



SCALE 1" = 40'
IRON = ●

STA. 0+00 LINE 2 =
STA. 2+19.19 LINE 1
CONSTRUCT STD. TYPE 'P' MH
TOP = 1364.5

STA. 2+68.01 LINE 2 =
STA. 0+00 LINE 2A
CONSTRUCT STD. TYPE 'P' MH
TOP = 1366.4



STA. 5+43.01 LINE 2
CONSTRUCT STD. TYPE 'P' MH
TOP = 1366.8

STA. 8+52.68 LINE 2
CONSTRUCT STD. TYPE 'P' MH
TOP = 1365.9

SEWER SERVICE TABLE

NUMBER	TYPE	SERVING			FOR INFORMATION ONLY	
		LOT NO.	BLOCK NO.	LINE NO.	STATION \ DIRECTION	APPROXIMATE LENGTH 4" PIPE VERTICAL HORIZONTAL
17	8" X 4" Tee Saddle	19	2	2	4+02.1 W 3+18.8 E	20' 21.1
18	8" X 4" Tee Saddle	18	3	2	4+77.1 W 75.71 E	20' 20.5

NOTE: Vertical Riser Pipe shall be extended to 2' minimum above ground water elevation and 4' maximum below proposed ground elevation.

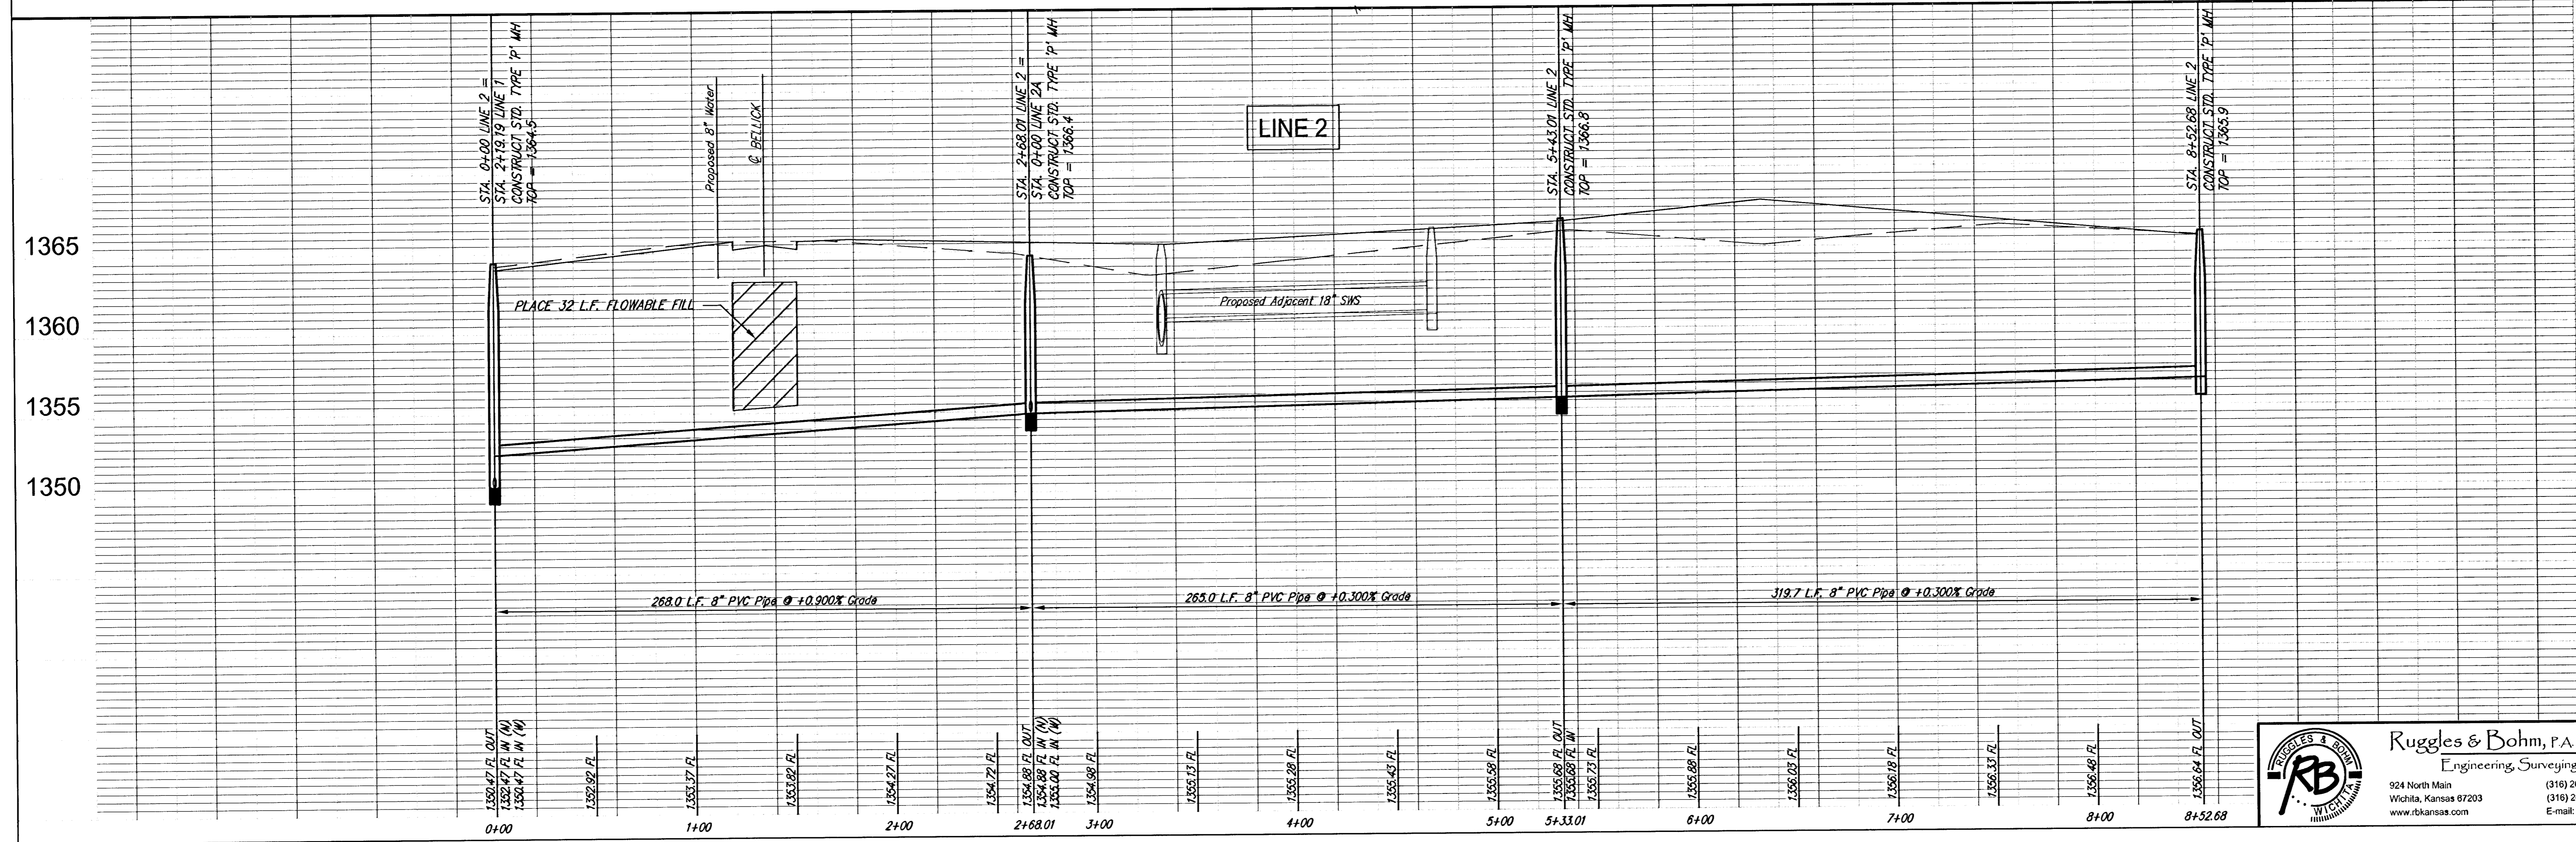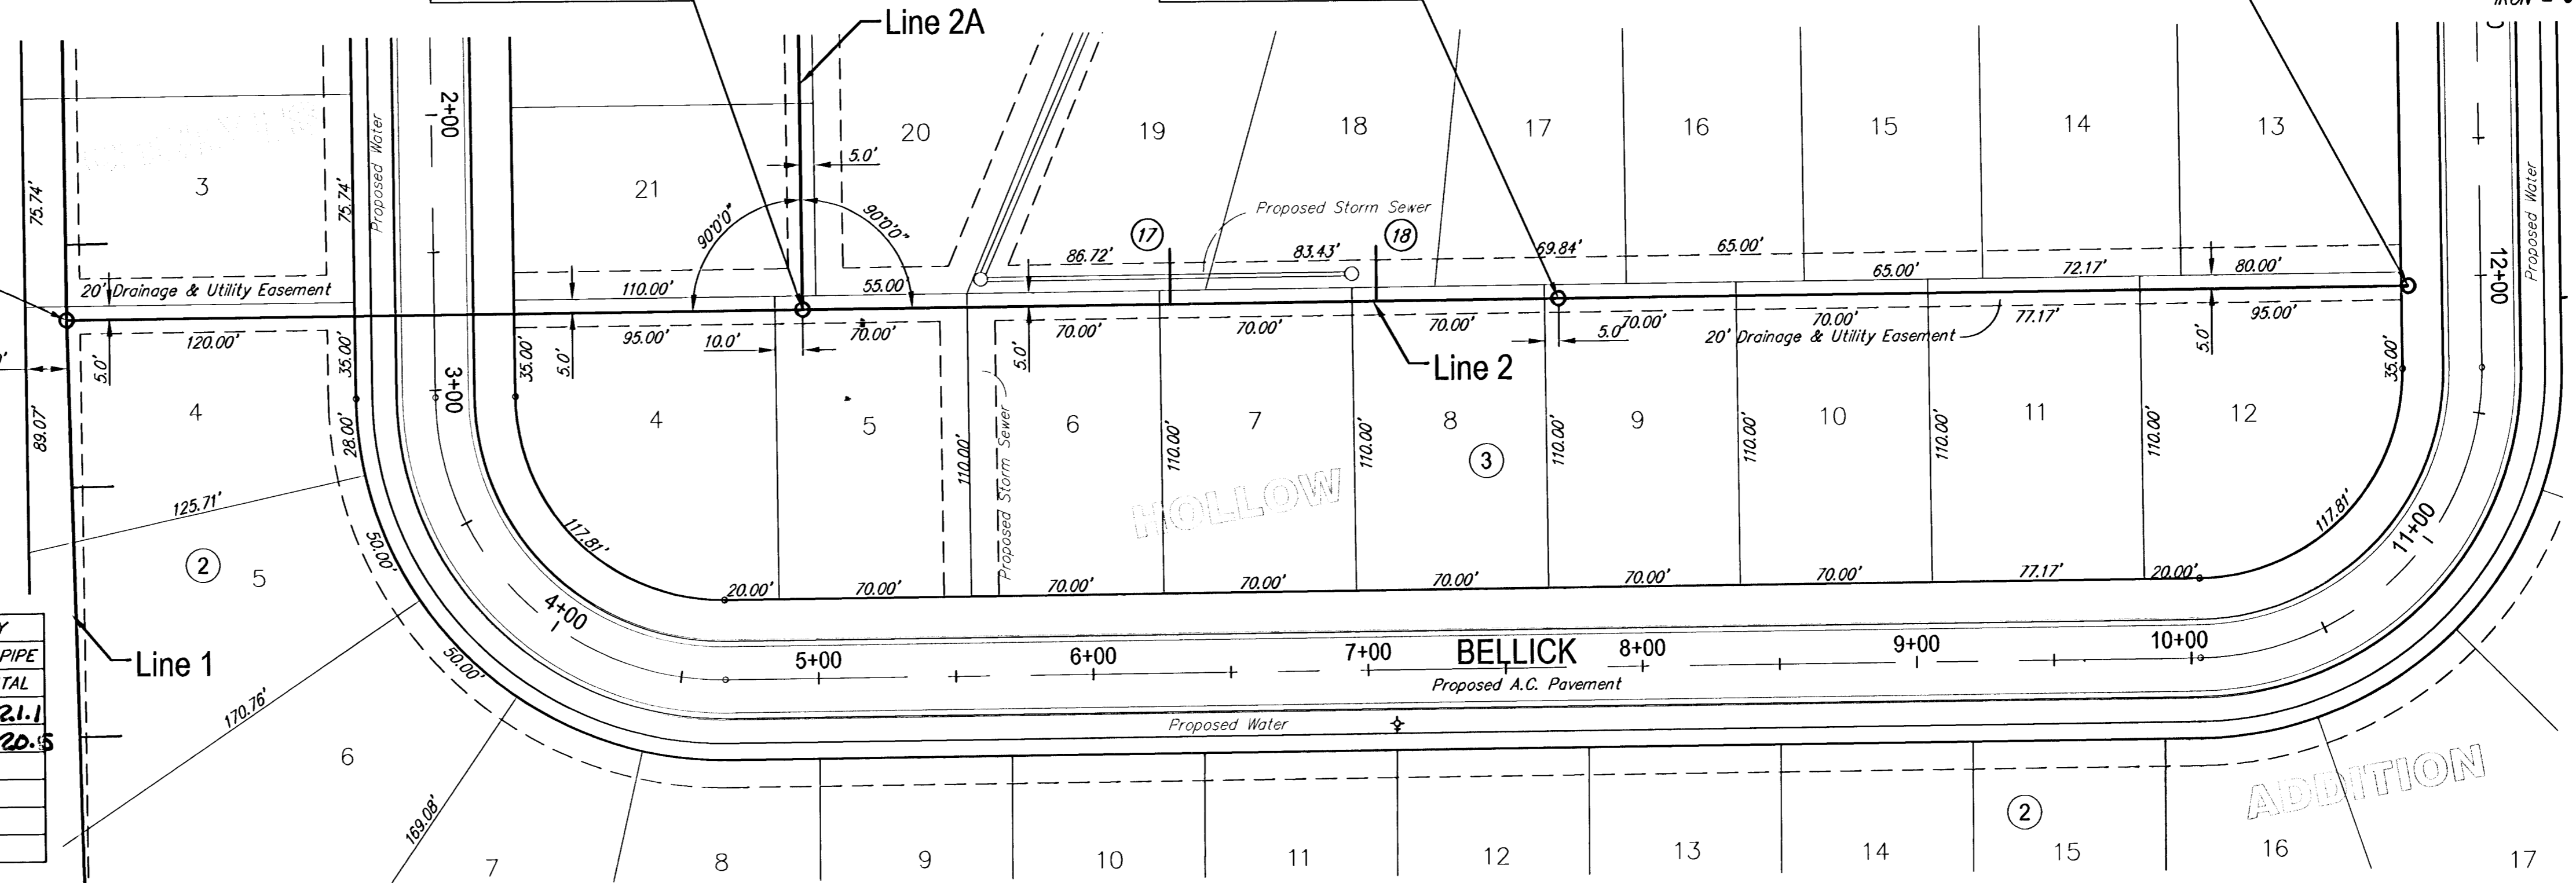

PROJECT NUMBER 488-83937	DESIGNER KWL	DATE May 3, 2005
DRAWING FILE Sanitary Sewer (Line 1)	REVISION RA	REVIEW
Cheryl's Hollow Addition Line 2 WICHITA, KANSAS		