

BENCHMARKS:

BM #1: C.O.W. disc at SW corner of intersection.
30.00'± S. of CL of 13th St. N.
35.00'± W. of CL of 135th St. W.
Elev. = 168.25 City Datum


BM #2: Small RR spike in 4th HLP
W. of 135th St. W. on south side of 13th St. N. (N. face of HLP).
Elev. = 179.24 City Datum

BM #3: RR spike in Power Pole.
1321.65 W. of 135th St. W.
30' N. of 13th St. N.
Elev. = 178.45 City Datum


SEWER SERVICE TABLE

NUMBER	TYPE	LOCATION			FOR INFORMATION ONLY		
		LOT NO.	BLOCK NO.	LINE NO.	STATION/DIRECTION	APPROXIMATE LENGTH 4" PIPE	
29	8" X 4" Tee	20	E	3	0+60/Lt. 10.4	13'	5'
30	4" Stub	1	F	3	2+44/Lt. 4.1.3	14.5'	17'
31	4" Stub	22	F	3	2+44/Lt. 4.1.3	14.5'	7'
32	8" X 4" Tee	21	F	3	3+40/Lt. 3.6.9	9.5'	5'
33	8" X 4" Tee	2	F	3	3+53/Lt. 5.1.9	9.5'	15'
34	8" X 4" Tee	3	F	3	4+48/Lt. 4.6.1	8.5'	18' 17'
35	8" X 4" Tee	4	F	3	5+34/Lt. 3.8.10	8.0'	25'
36	8" X 4" Tee	5	F	3	6+18/Lt. 1.9.10	7.5'	13' 12'
37	4" Stub	6	F	3	6+60/Lt. 1.1.1	7'	8' 6"

NOTE: Vertical Riser Pipe shall be extended to 2' minimum above ground water elevation and 4' maximum below proposed ground elevation.

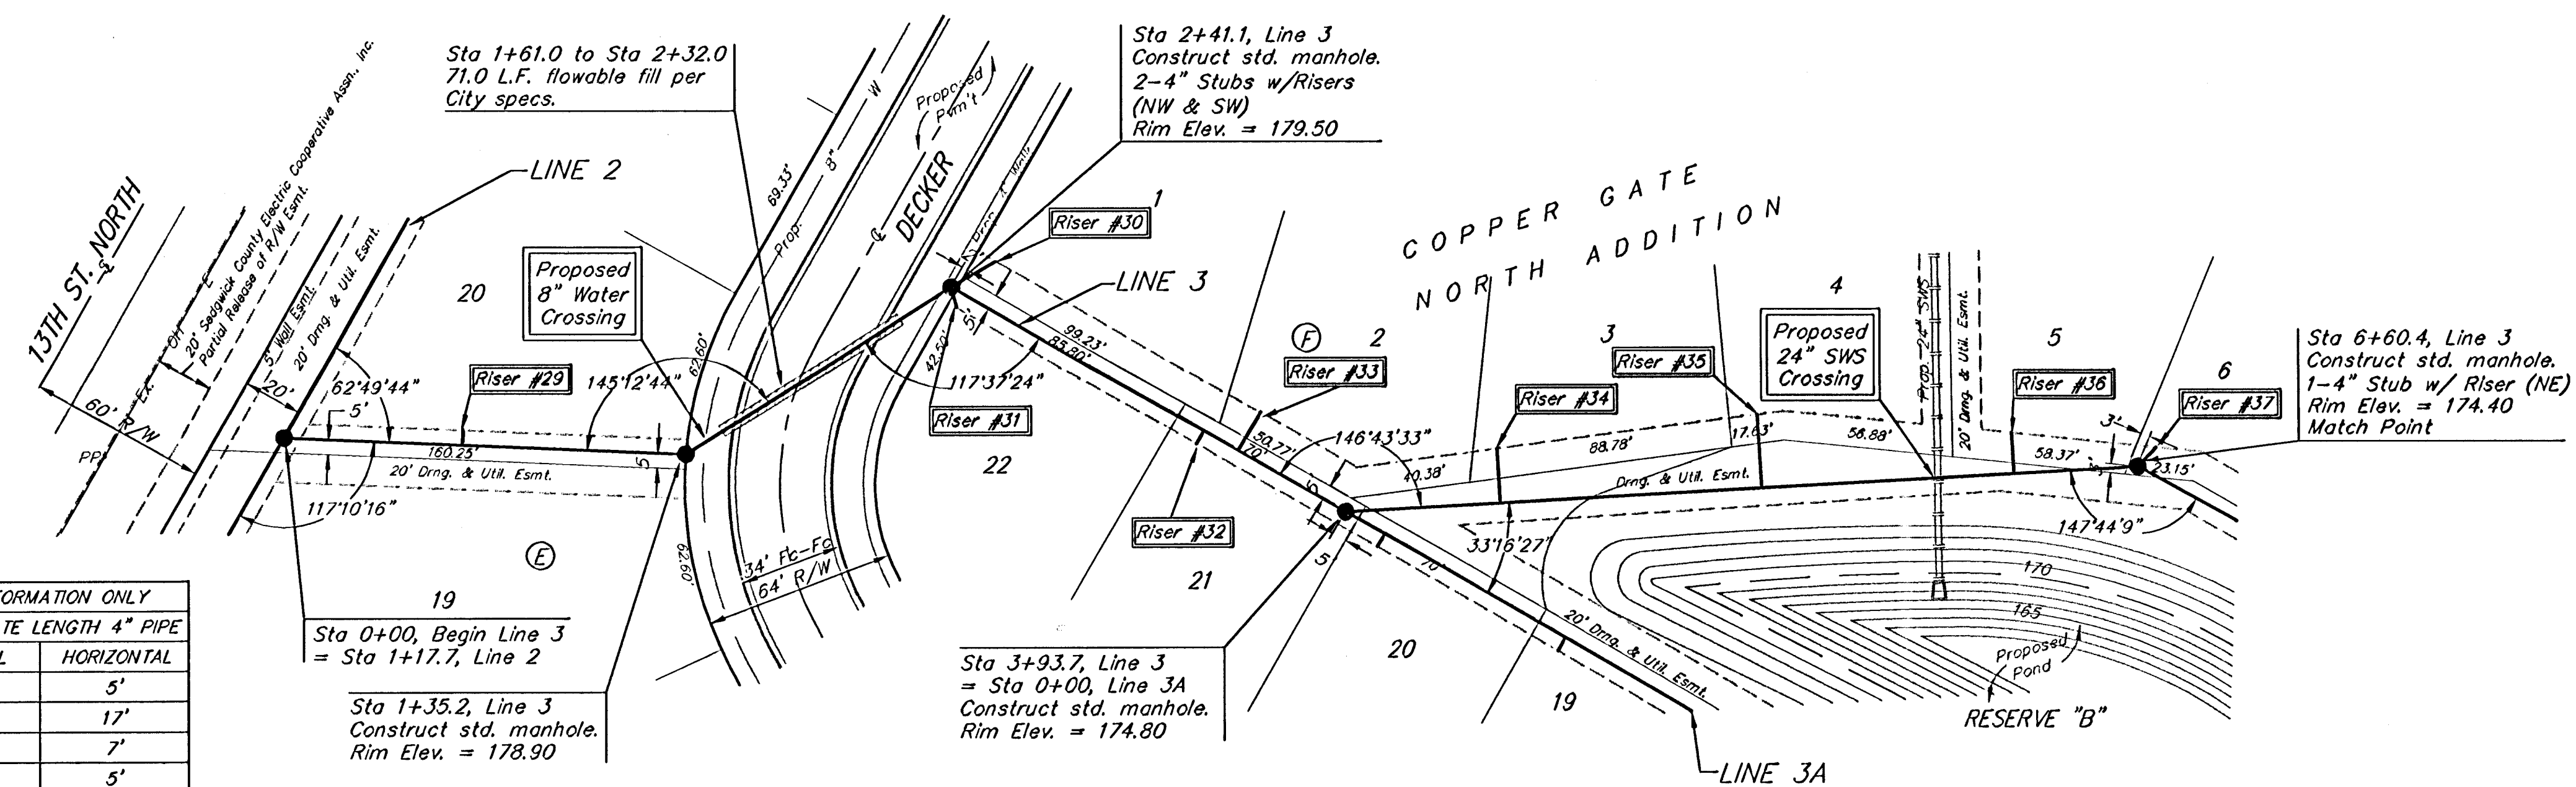

Scale: 1" = 40' Horizontal
1" = 5' Vertical
• = Iron

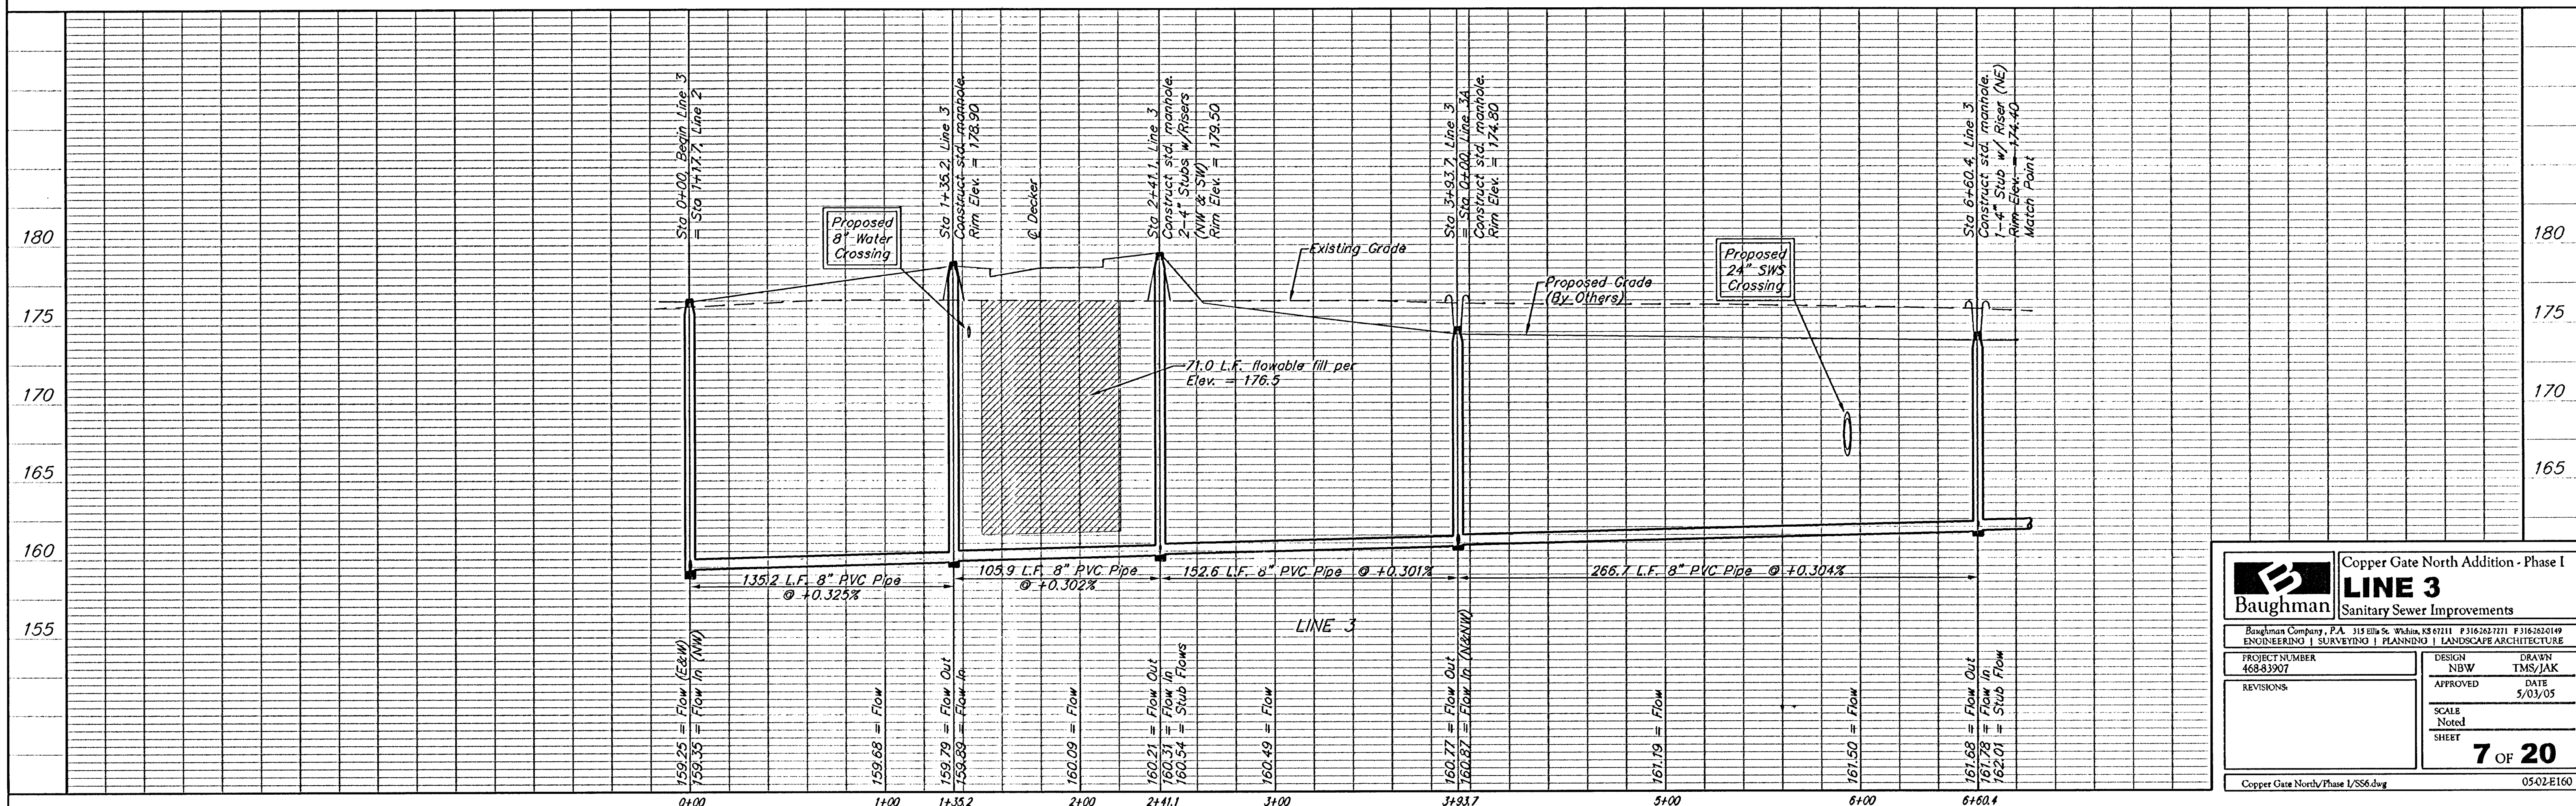

Baughman Copper Gate North Addition - Phase I
LINE 3
Sanitary Sewer Improvements

PROJECT NUMBER: 468-83907
DESIGN: NBW
DRAWN: TMS/JAK
APPROVED: DATE: 5/03/05
SCALE: Noted
SHEET: 7 OF 20

Copper Gate North/Phase I/SS6.dwg 0502E160