

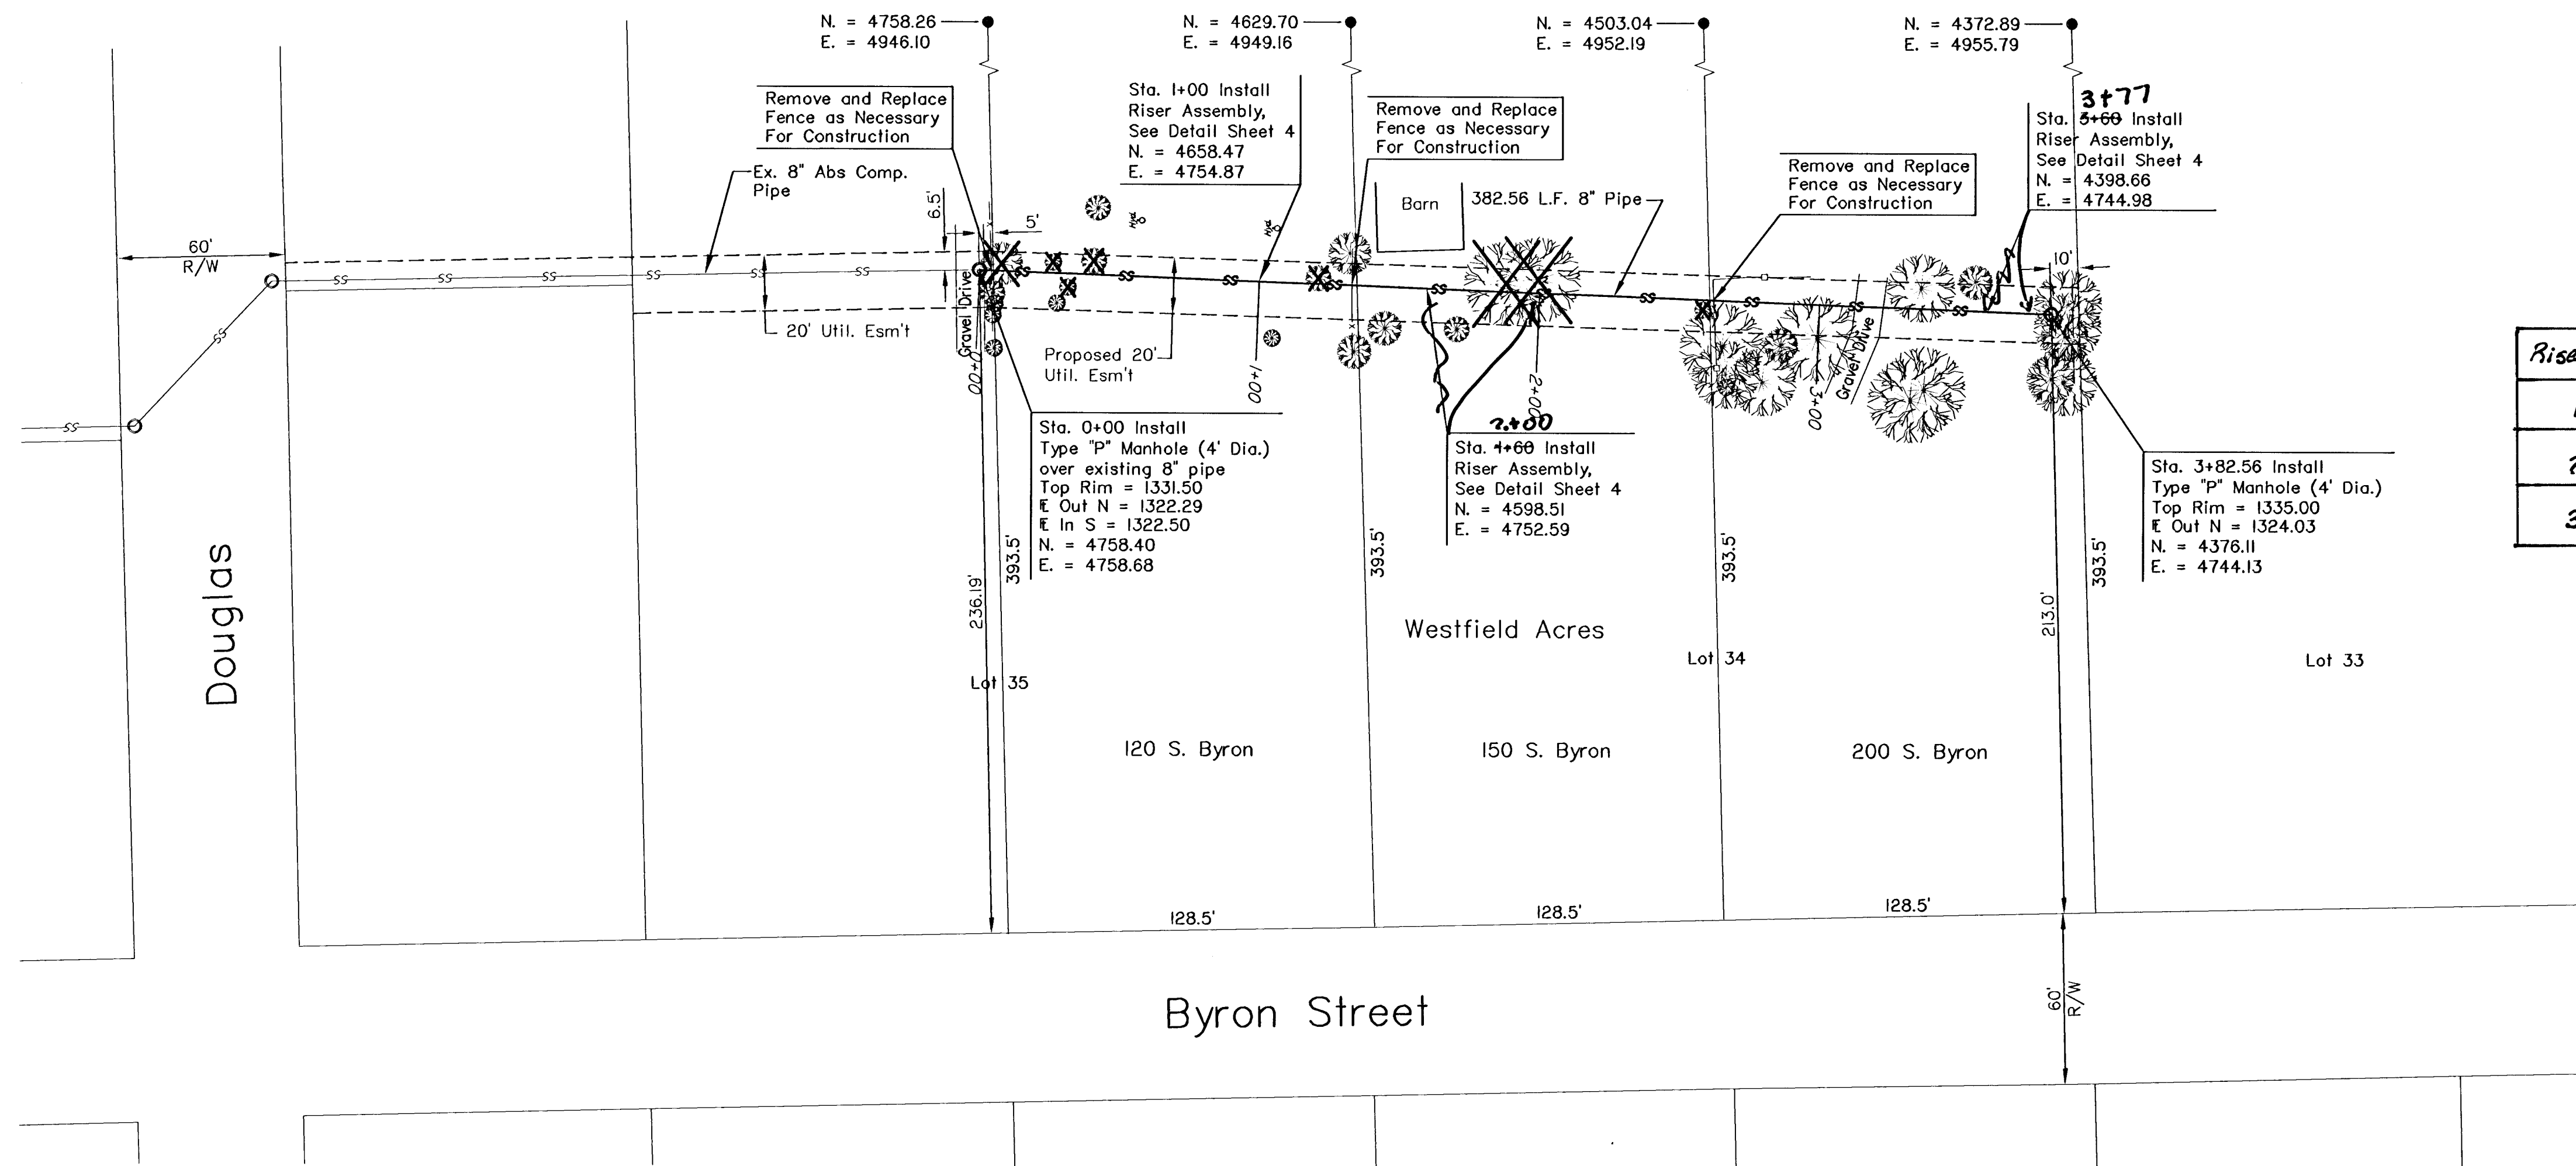


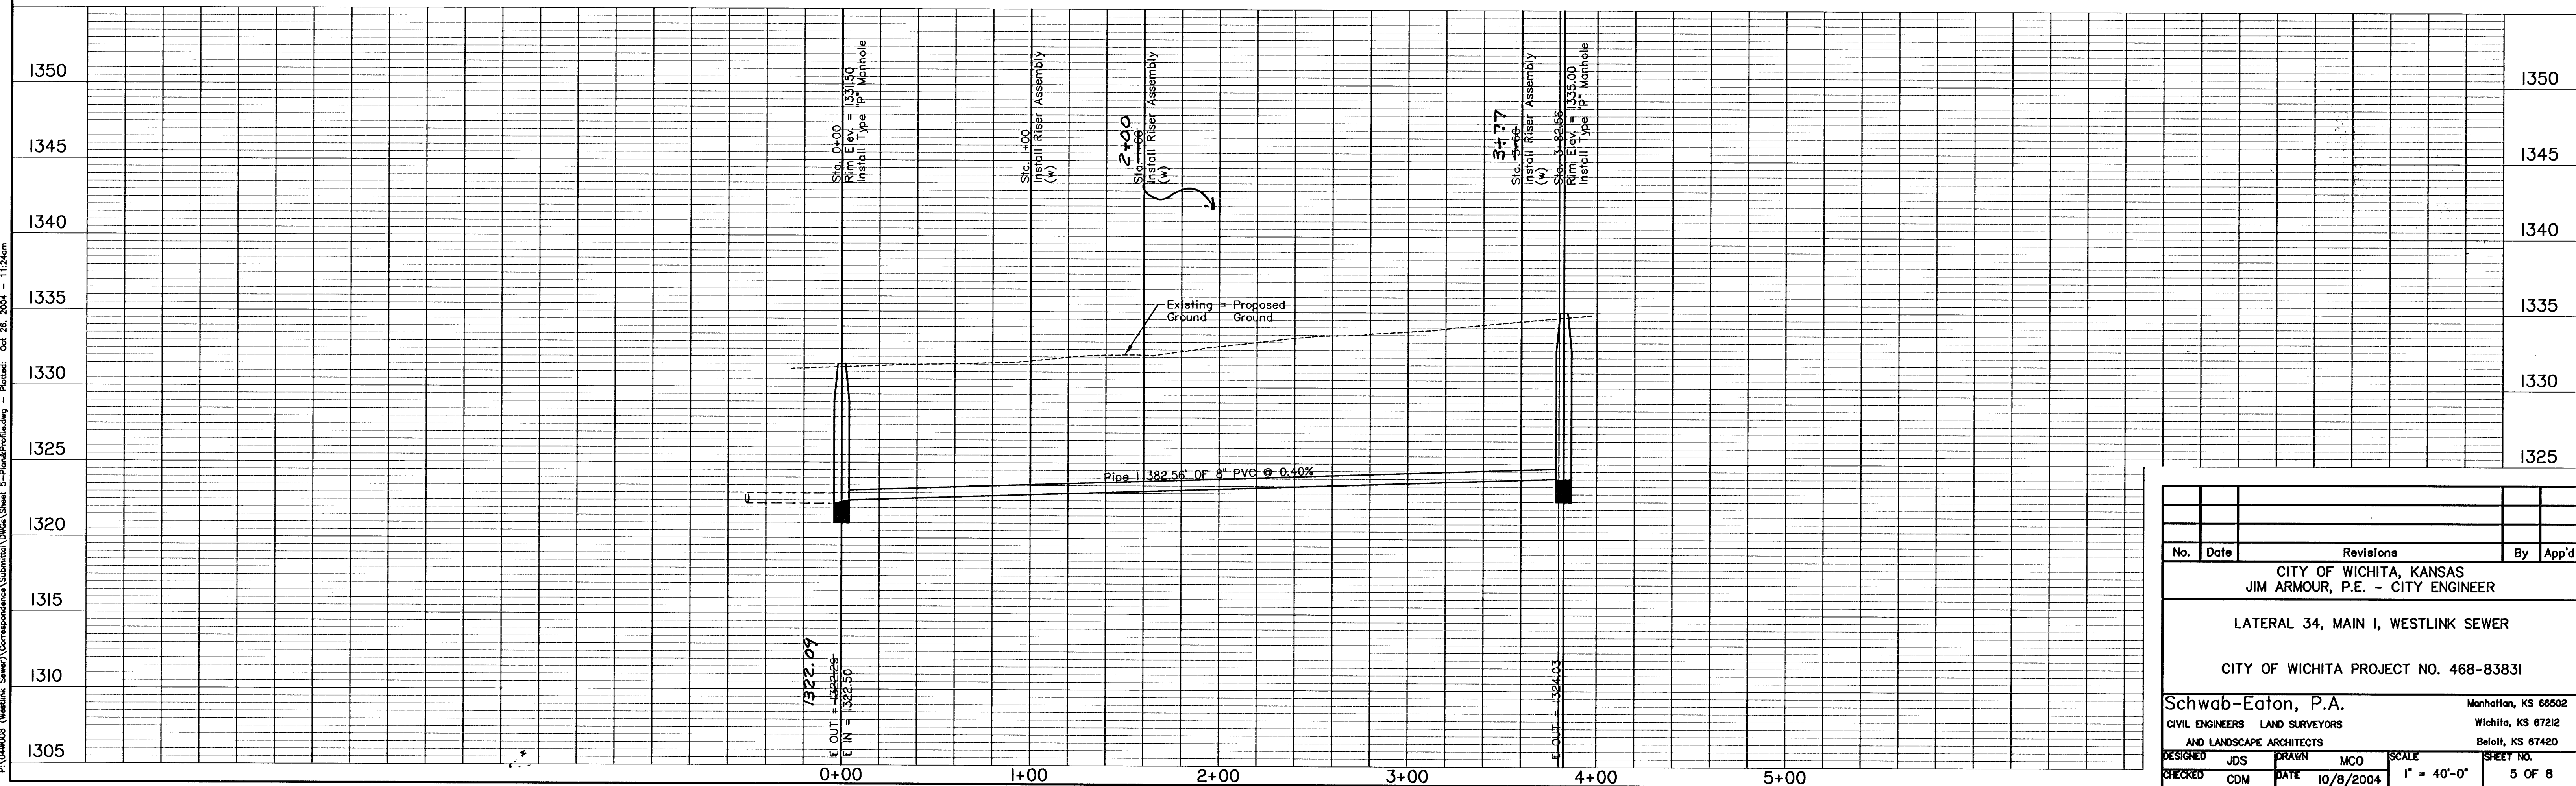

Riser No.	Line No.	Sta.	Distance Main-Riser	Distance from	
				Upstream MH	Downstream MH
1	1	1+00	10' Rt.	282.56	100'
2	1	2+00	10' Rt.	182.56	200'
3	1	3+77	10' Rt.	5'	377.56'

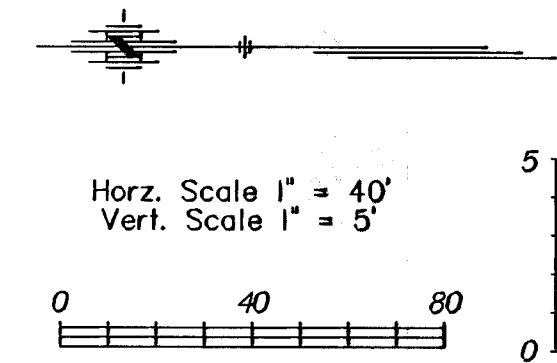

No.	Date	Revisions	By	App'd
CITY OF WICHITA, KANSAS JIM ARMOUR, P.E. - CITY ENGINEER				
LATERAL 34, MAIN 1, WESTLINK SEWER				
CITY OF WICHITA PROJECT NO. 468-83831				
Schwab-Eaton, P.A. CIVIL ENGINEERS LAND SURVEYORS AND LANDSCAPE ARCHITECTS Manhattan, KS 66502 Wichita, KS 67212 Beloit, KS 67420				
DESIGNED	JDS	DRAWN	MCO	SCALE
CHECKED	CDM	DATE	10/8/2004	1" = 40'-0"
SHEET NO.				5 OF 8