



NORTHRIDGE PLAZA ADDITION

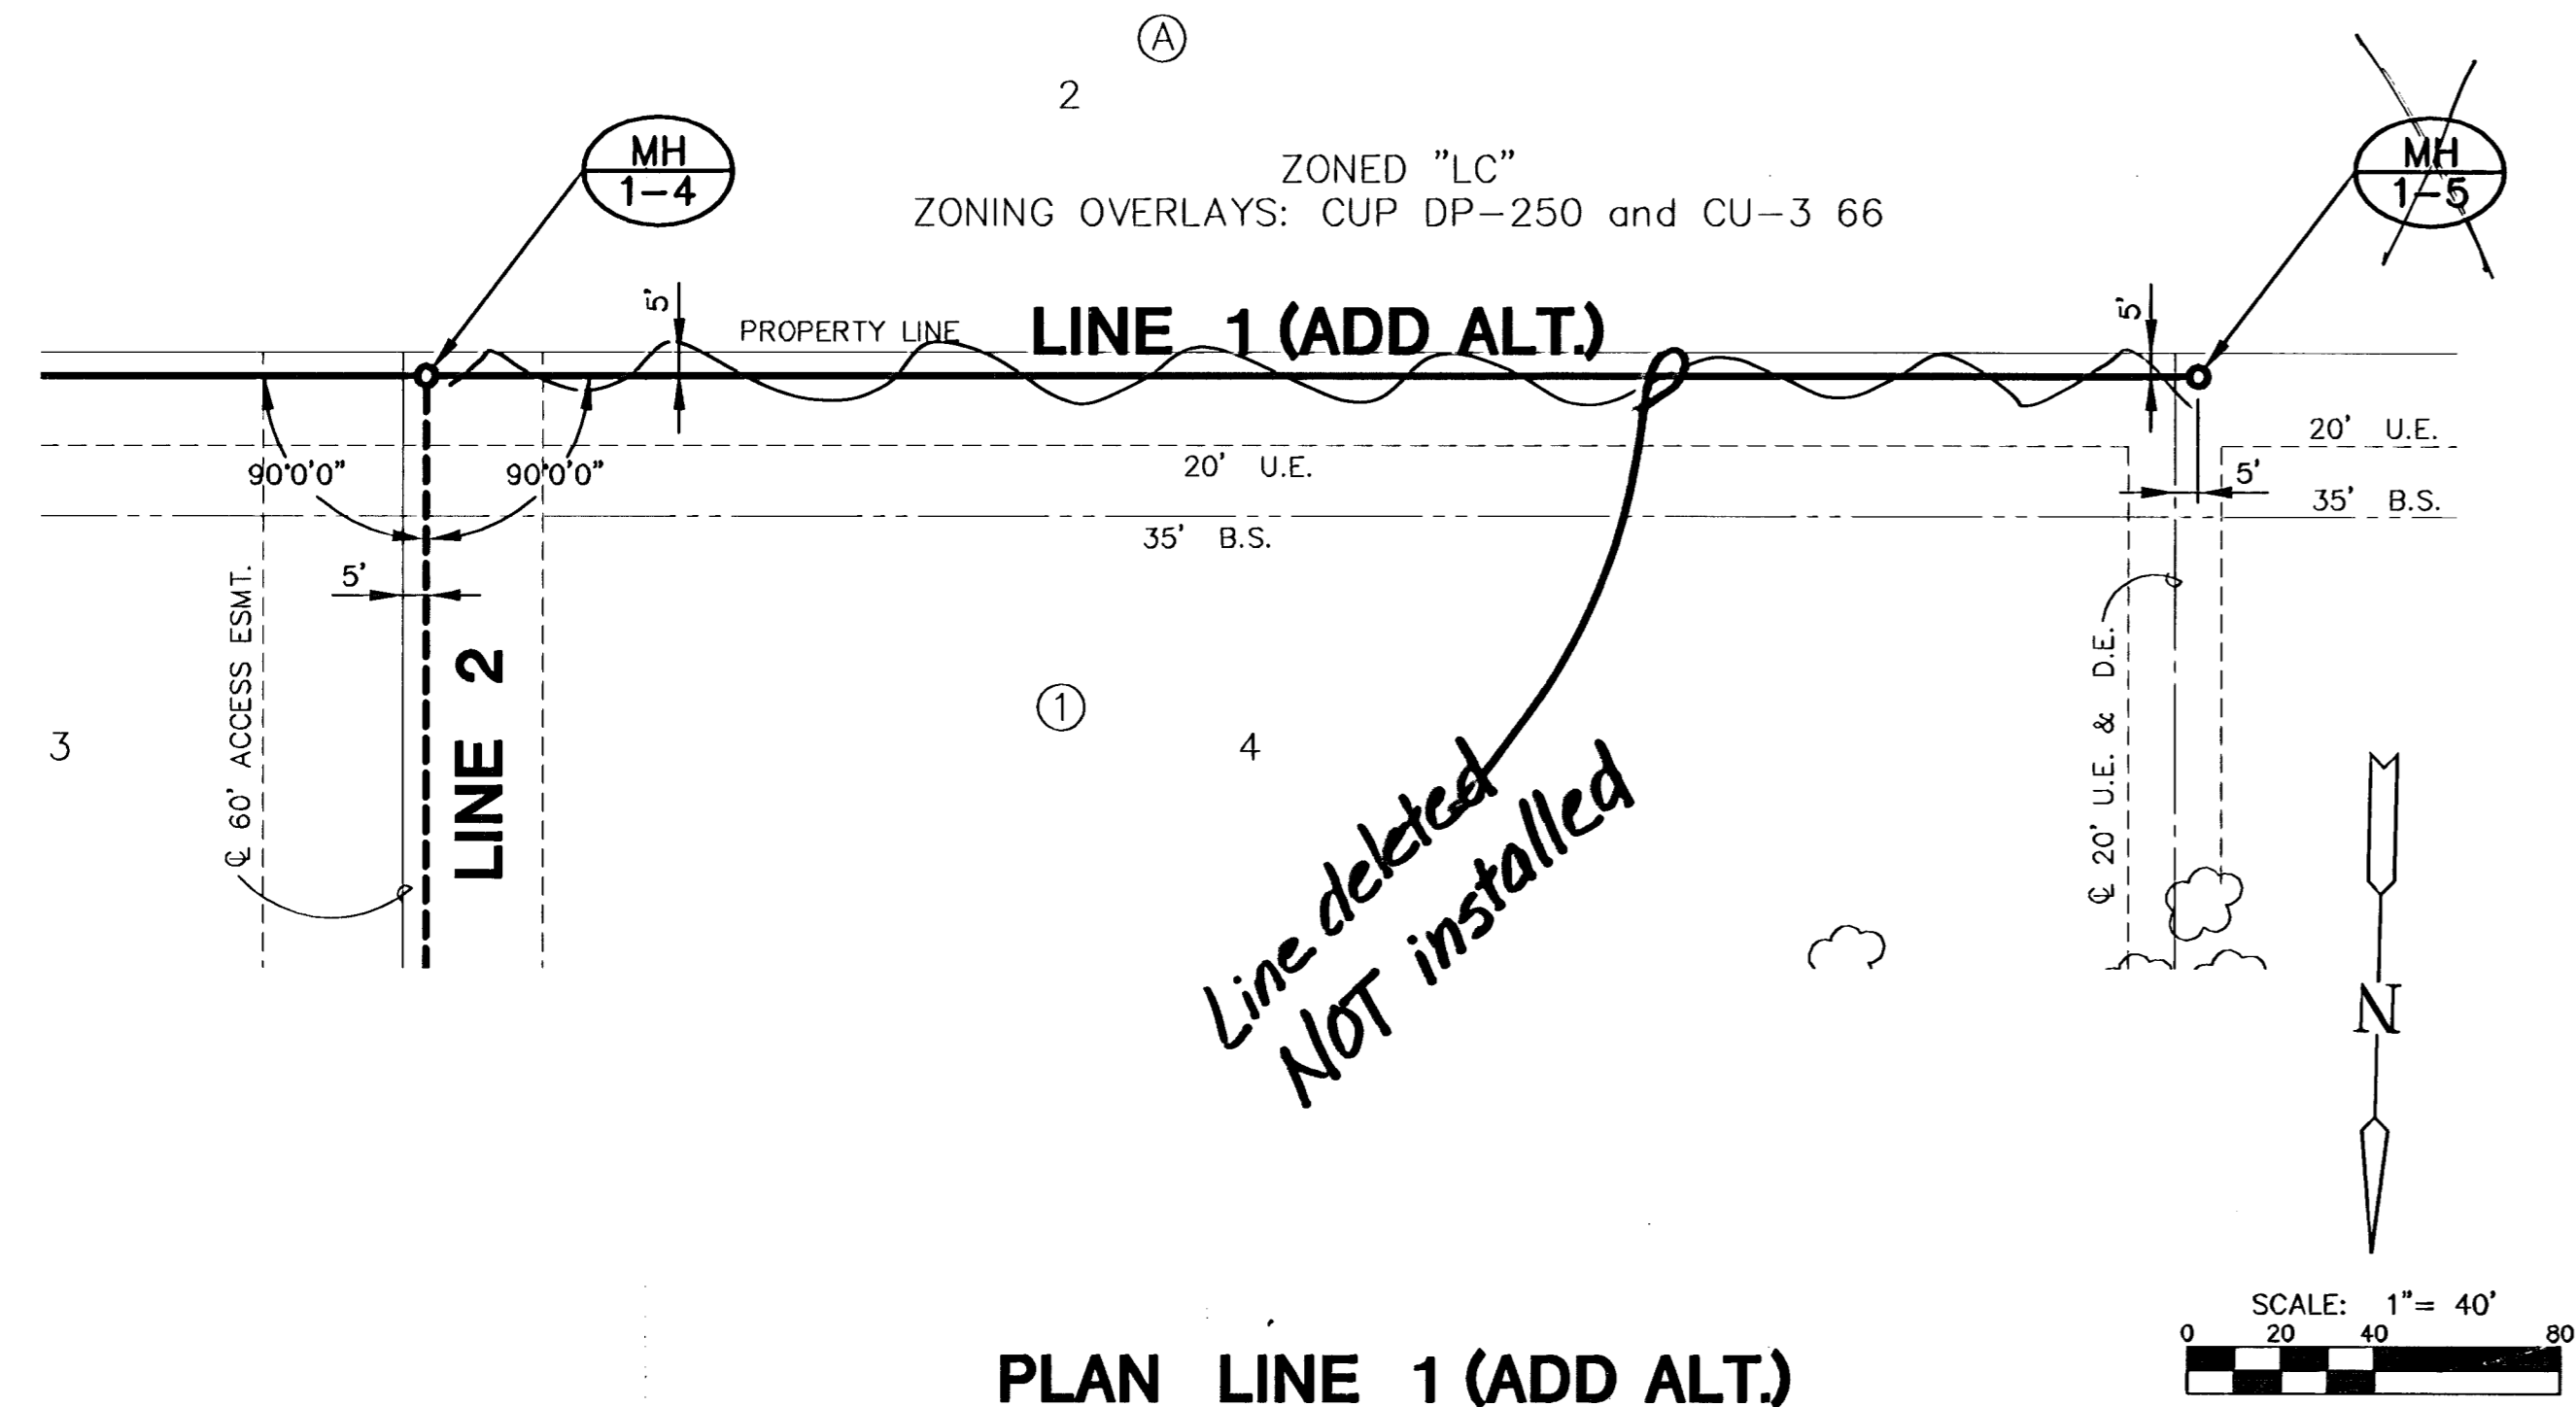

NORTHRIDGE
PLAZA ADDITION


ZONED "LC"
ZONING OVERLAYS: CUP DP-250 and CU-3 66

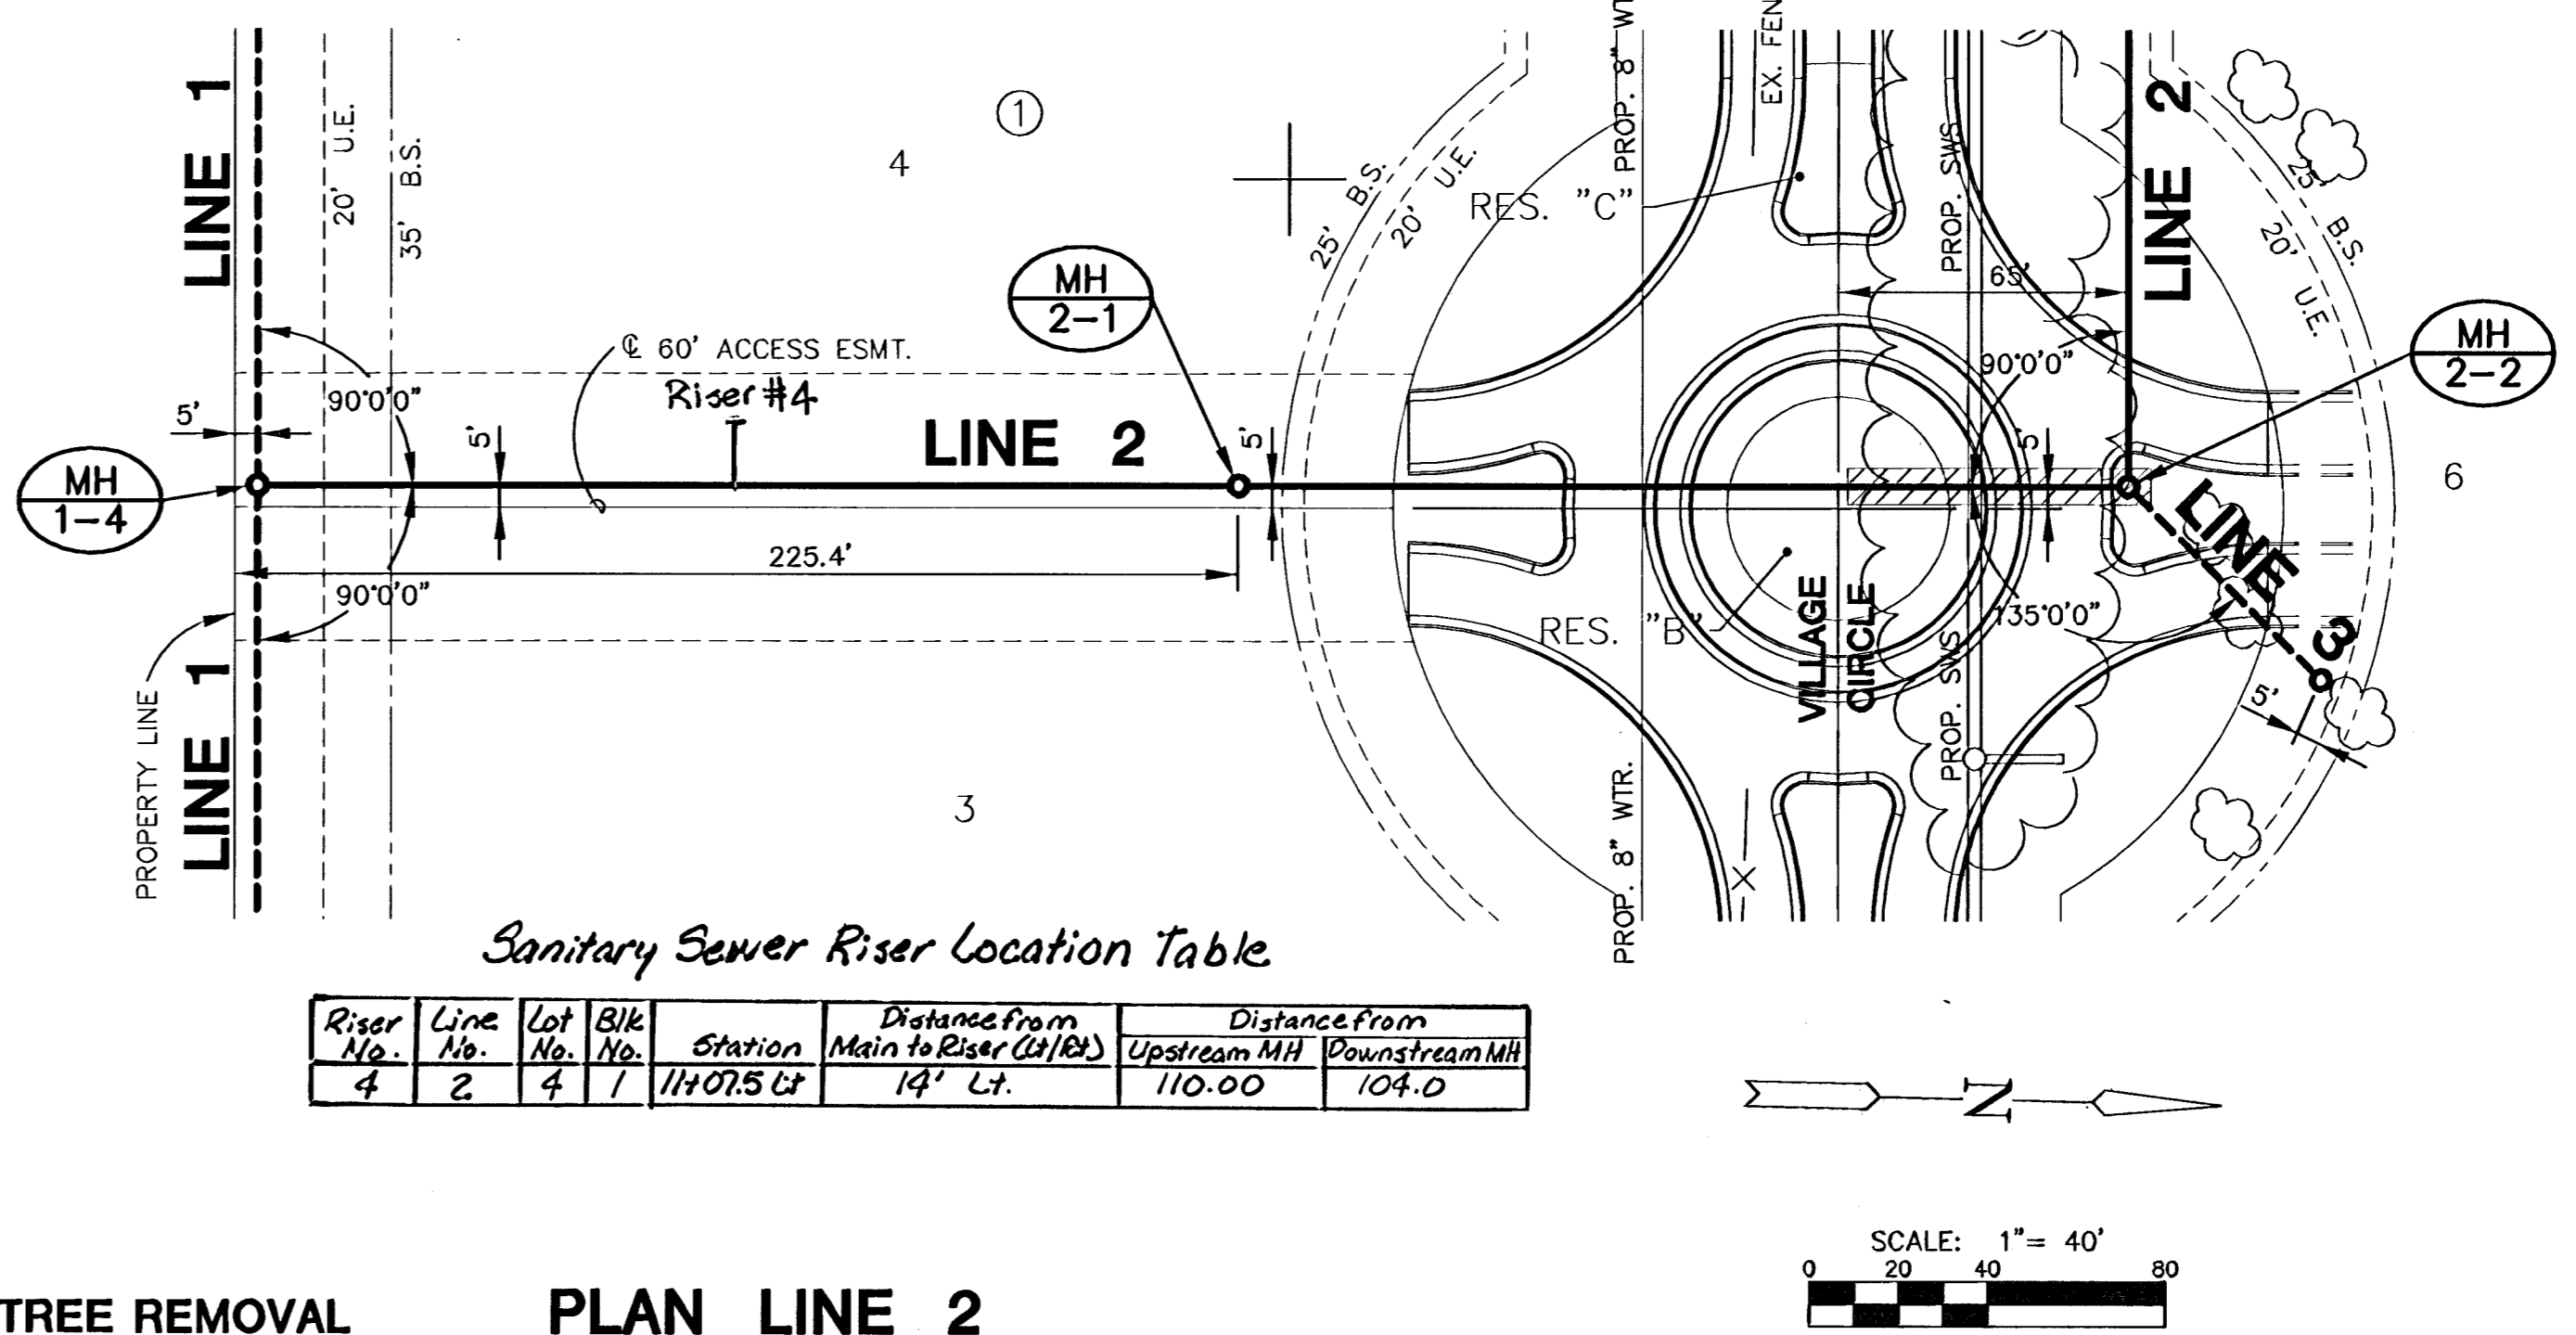

Sanitary Sewer Riser Location Table

Riser No.	Line No.	Lot No.	Blk. No.	Station	Distance from Main to Riser (ft)	Distance from Upstream MH	Distance from Downstream MH

PROFILE LINE 1 (ADD ALT.)

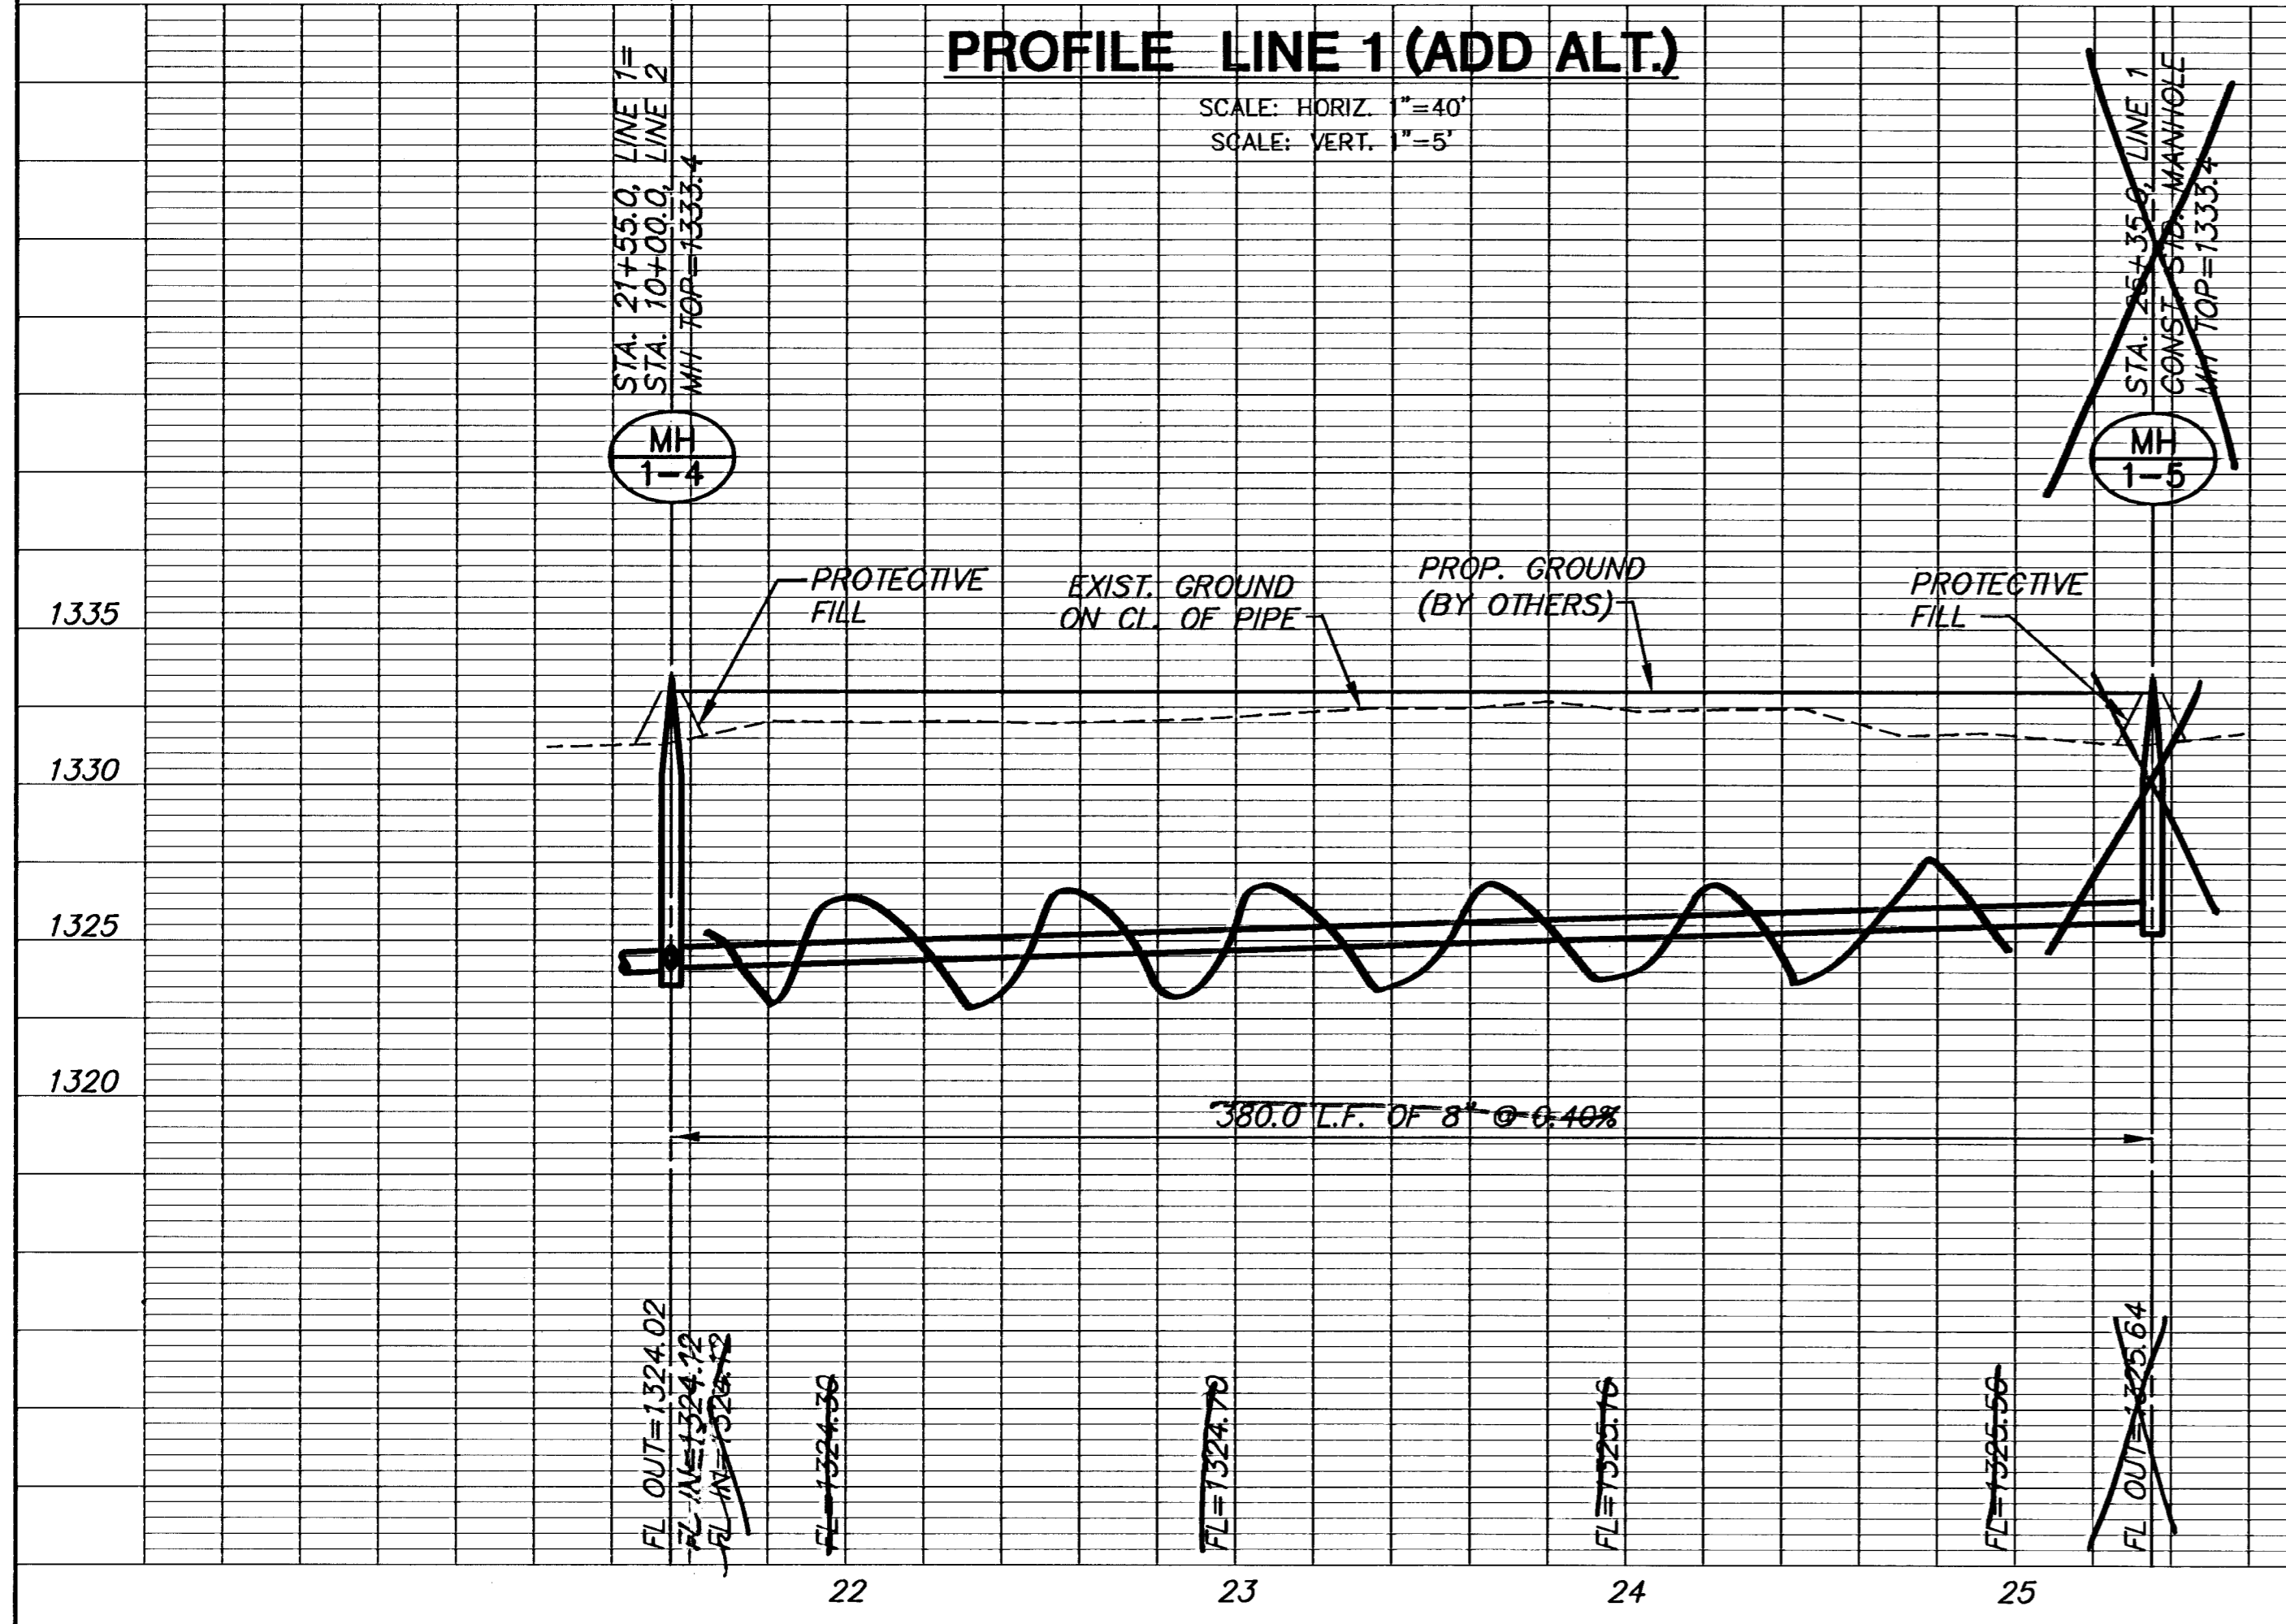

PROFILE LINE 2

