


Benchmarks:

City of Wichita Benchmark located
41.60' North and 69.00' East of the
Centerlines of Hoover and MacArthur
(39th St. South)

Elevation = 121.22 (City Datum)

City of Wichita Benchmark located
at East end of Bridge over the Big
Ditch on MacArthur in the West bound
lane.

Elevation = 116.52 (City Datum)

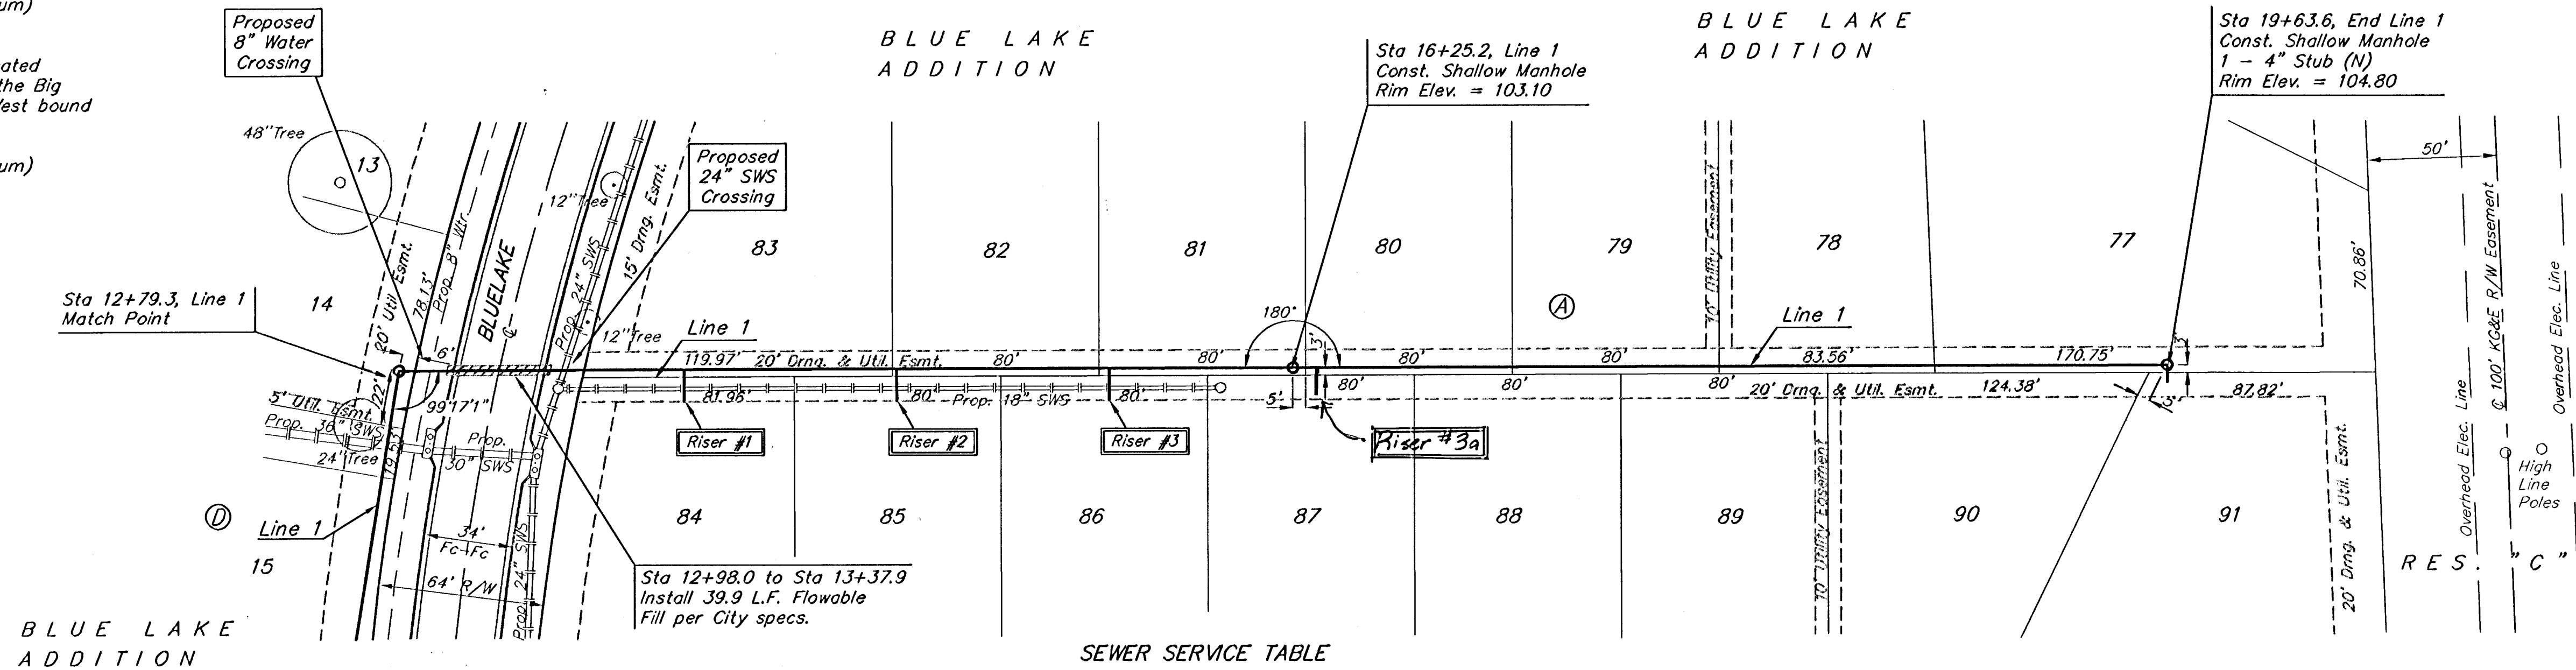


SEWER SERVICE TABLE

NUMBER	TYPE	LOCATION			FOR INFORMATION ONLY		
		LOT NO.	BLOCK NO.	LINE NO.	STATION \ DIRECTION	APPROXIMATE LENGTH 4" PIPE	
1	8" x 4" Tee Saddle	84	A	1	13+88/Rt. 83	2.5'	13' 12"
2	8" x 4" Tee Saddle	85	A	1	14+68/Rt. 65	2'	13' 12"
3	8" x 4" Tee Saddle	86	A	1	15+50/Rt. 44	2.5'	13' 12"
3a	8" x 4" Tee Saddle	87	A	1	16+33/Rt. 4		12'

Note: Vertical Riser Pipe shall be
extended to 2' minimum above ground
water elevation and 4' maximum below
proposed ground elevation.

Note: Contractor shall Remove Trees
only as Necessary to Construct Sanitary
Sewer Line. Cost of Tree Removal shall
be Included in Bid Item "Site Clearing
and Restoration."

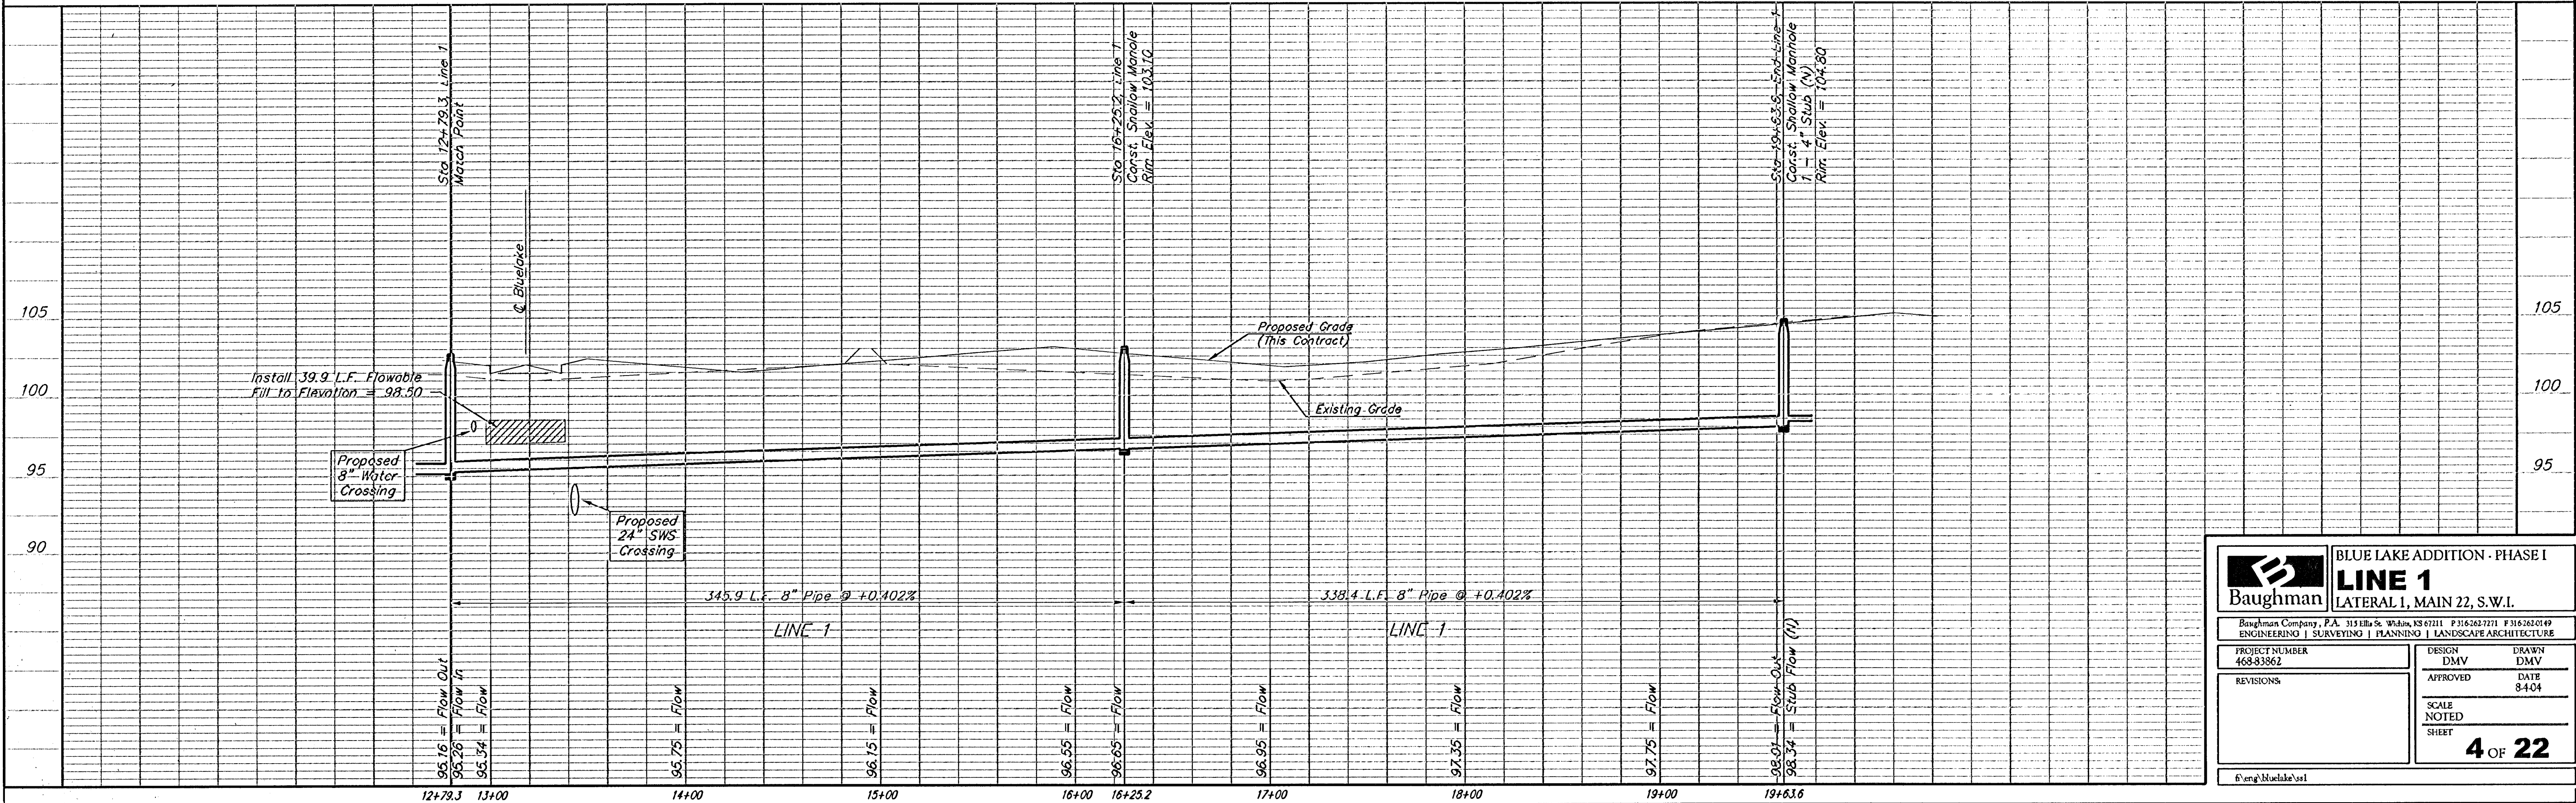

**BLUE LAKE ADDITION - PHASE I**
LINE 1
LATERAL 1, MAIN 22, S.W.L.

Baughman Company, P.A. 3151 E. St. Wichita, KS 67211 P 316.262.7271 F 316.262.0149
ENGINEERING | SURVEYING | PLANNING | LANDSCAPE ARCHITECTURE

PROJECT NUMBER 468-83862	DESIGN DMV	DRAWN DMV
REVISIONS:	APPROVED	DATE 8-4-04
	SCALE NOTED	
	SHEET	

4 OF 22

© 2004 Baughman Co.