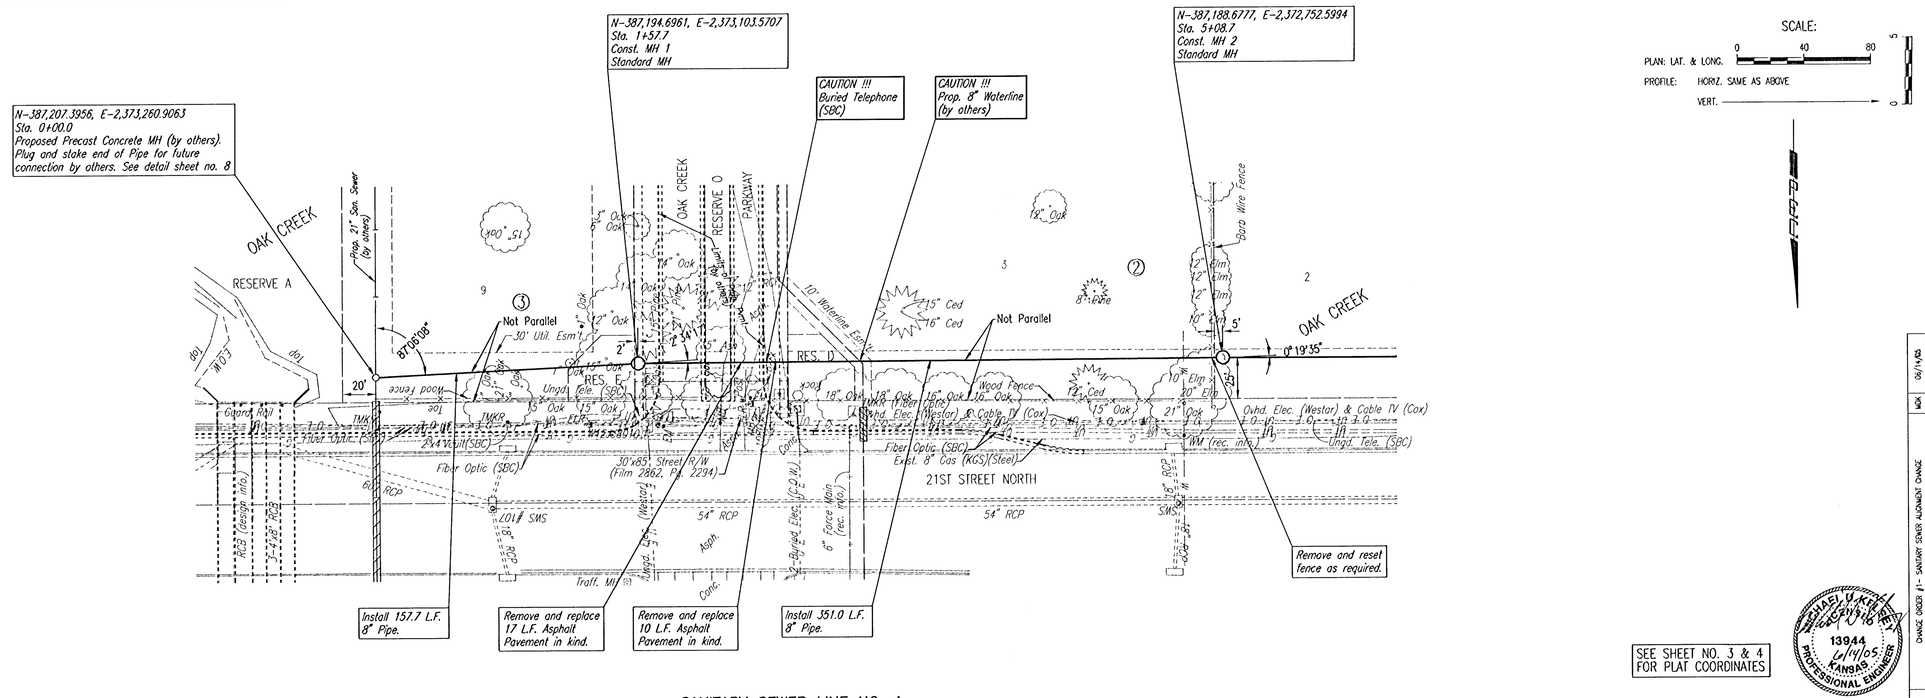

SEE SHEET NO. 3 & 4
FOR PLAT COORDINATES

SANITARY SEWER LINE NO. 1

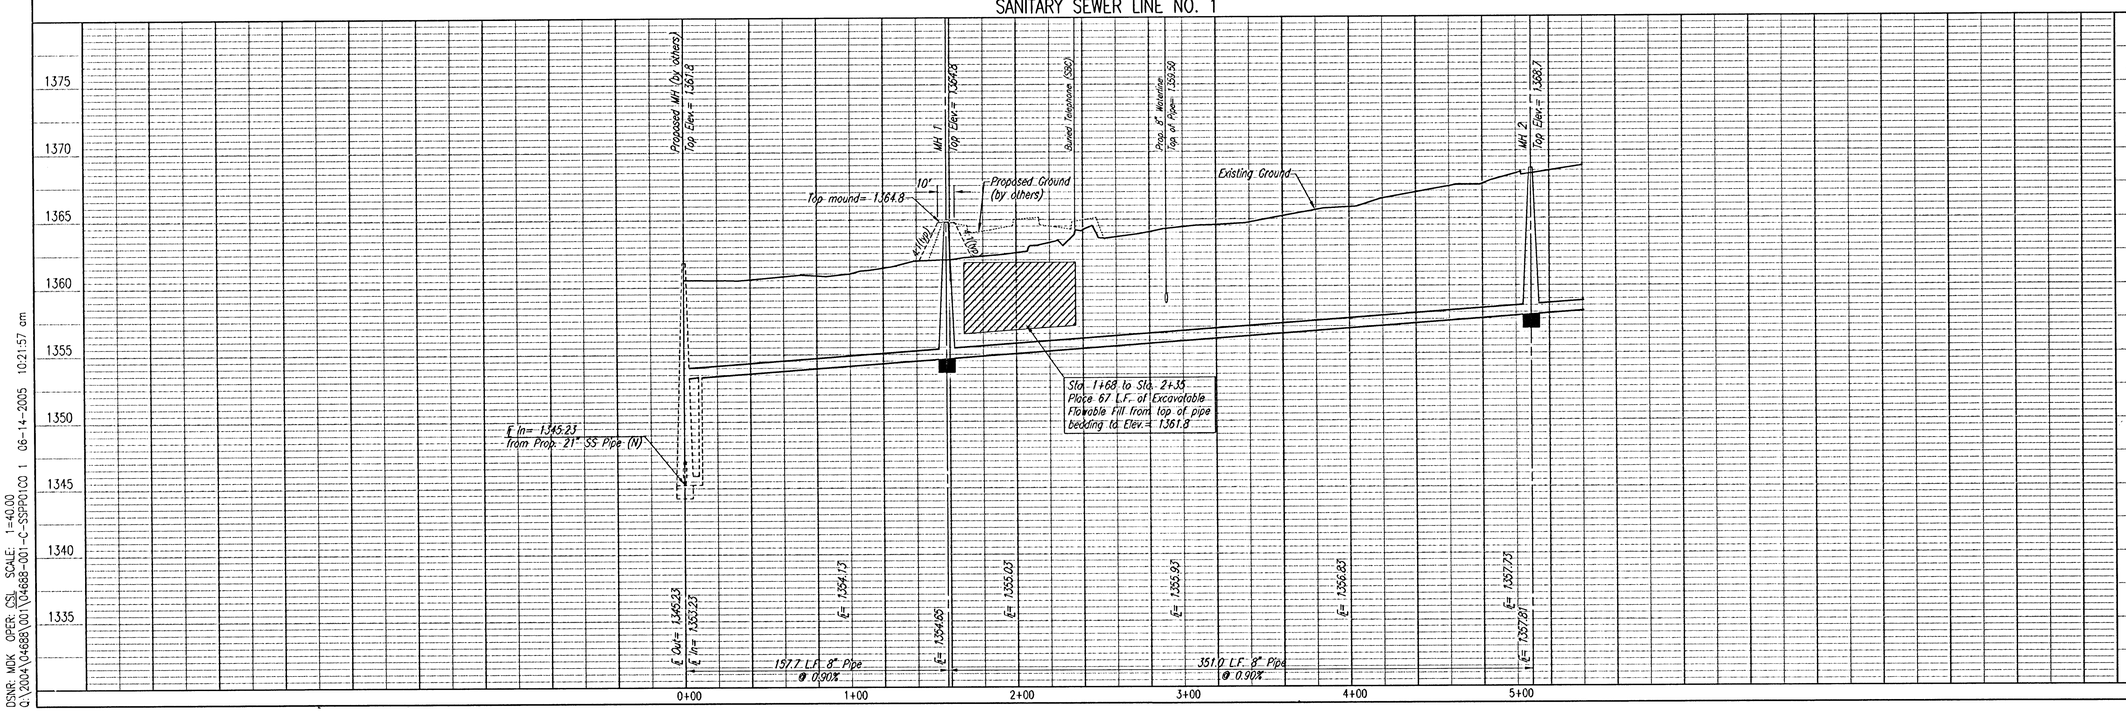

PLAN		BY	DATE
	CHECKED		
	CHECKED		

PROFILE		BY	DATE
	CHECKED		
	CHECKED		

DSN'R: MDK OPER: CSJ SCALE: 1"=40.00
C:\2004\04688\001\04688-001-C-SSPP0100 1 06-14-2005 10:21:57 am

No.	Revision	By	Date
1	CHANGE ORDER #1 - SANITARY SEWER ALIGNMENT CHANGE	MDK	06/14/05

MICHAEL D. KEPLER
NO. 13944
KANSAS
PROFESSIONAL ENGINEER
6/14/05

LATERAL 1, MAIN 16
OF THE FOUR MILE CREEK SEWER

SANITARY SEWER LINE NO. 1

JAMES L. ARMOUR, P.E. – ACTING CITY ENGINEER
CITY OF WICHITA PROJECT NO. 468-63984

Professional Engineering Consultants, P.A.
303 S. TOPEKA • WICHITA, KANSAS 67202
316 262-2691 • FAX 316 262-3003

Designed By	MDK	Job No.	35-04688-001
Drawn By	TLB	Date	January 2005

Sheet 5 of 18

CHANGE ORDER #1