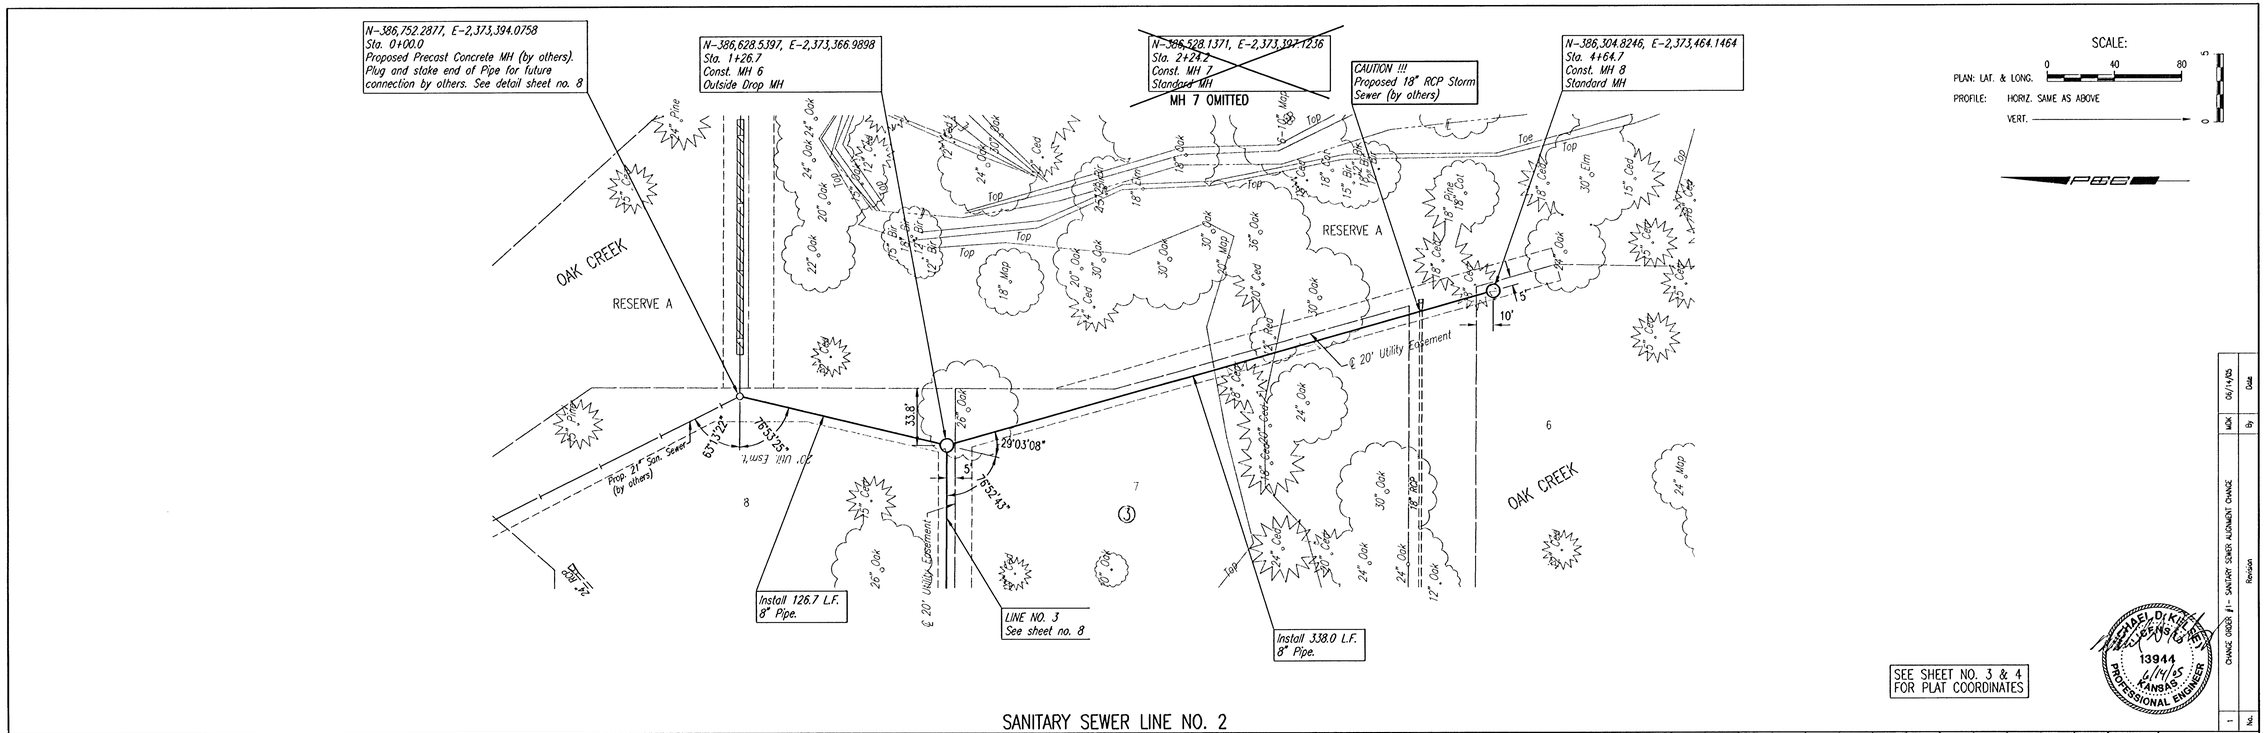
N-386,752.2877, E-2,373,394.0758
Sta. 0+00.0
Proposed Precast Concrete MH (by others).
Plug and stake end of Pipe for future
connection by others. See detail sheet no. 8
N-386,628.5397, E-2,373,366.9898
Sta. 1+26.7
Const. MH 6
Outside Drop MH
N-386,528.1371, E-2,373,397.1236
Sta. 2+24.2
Const. MH 7
Standard MH
MH 7 OMITTED
CAUTION !!!
Proposed 18" RCP Storm
Sewer (by others)
N-386,304.8246, E-2,373,464.1464
Sta. 4+64.7
Const. MH 8
Standard MH
SCALE:
PLAN: LAT. & LONG.
PROFILE: HORIZ. SAME AS ABOVE
VERT.
OAK CREEK
RESERVE A
RESERVE A
OAK CREEK
Prop. 21" San. Sewer
(by others)
20' Util Esm't
Install 126.7 L.F.
8" Pipe.
LINE NO. 3
See sheet no. 8
℄ 20' Utility Easement
Install 338.0 L.F.
8" Pipe.
℄ 20' Utility Easement
SEE SHEET NO. 3 & 4
FOR PLAT COORDINATES
SANITARY SEWER LINE NO. 2
Proposed MH (by others)
Top Elev. = 1360.9
MH 6
Top Elev. = 1361.3
Existing Ground
℄ In= 1354.02
from LINE NO. 3
Prop. 18" RCP SWS
℄= 1358.01
MH 8
Top Elev. = 1360.3
℄ In= 1344.76
from Prop. 21" SS Pipe (NW)
℄ Out= 1344.66
℄ In= 1345.85
℄= 1347.23
℄= 1347.69
℄= 1348.10
℄= 1348.78
℄= 1349.46
℄= 1349.90
126.7 L.F. 8" Pipe
@ 1.40%
338.0 L.F. 8" Pipe
@ 0.68%
0+00
1+00
2+00
3+00
4+00
1370
1365
1360
1355
1350
1345
1340
1335
1330
LATERAL 1, MAIN 16
OF THE FOUR MILE CREEK SEWER
SANITARY SEWER LINE NO. 2
JAMES L. ARMOUR, P.E.- ACTING CITY ENGINEER
CITY OF WICHITA PROJECT NO. 468-83984
Professional Engineering Consultants, P.A.
303 S. TOPEKA • WICHITA, KANSAS 67202
316-262-2691 • FAX 316-262-8003
Designed By MDK
Drawn By TLB
Job No. 35-04688-001
Date January 2005
Sheet 7 of 18
CHANGE ORDER #1
CHANGE ORDER #1 - SANITARY SEWER ALIGNMENT CHANGE
No. Revision By Date
1 MDK 06/14/05
MICHAEL DIRKS
LICENSED
13944
6/14/05
KANSAS
PROFESSIONAL ENGINEER
PLAN CHECKED CHECKED
PROFILE CHECKED CHECKED
DATE BY
DSNR: MDK OPER: CSL SCALE: 1=40.00
C:\2004\04688\001\04688-001-C-SSPR03CO 1 06-14-2005 10:13:44 am