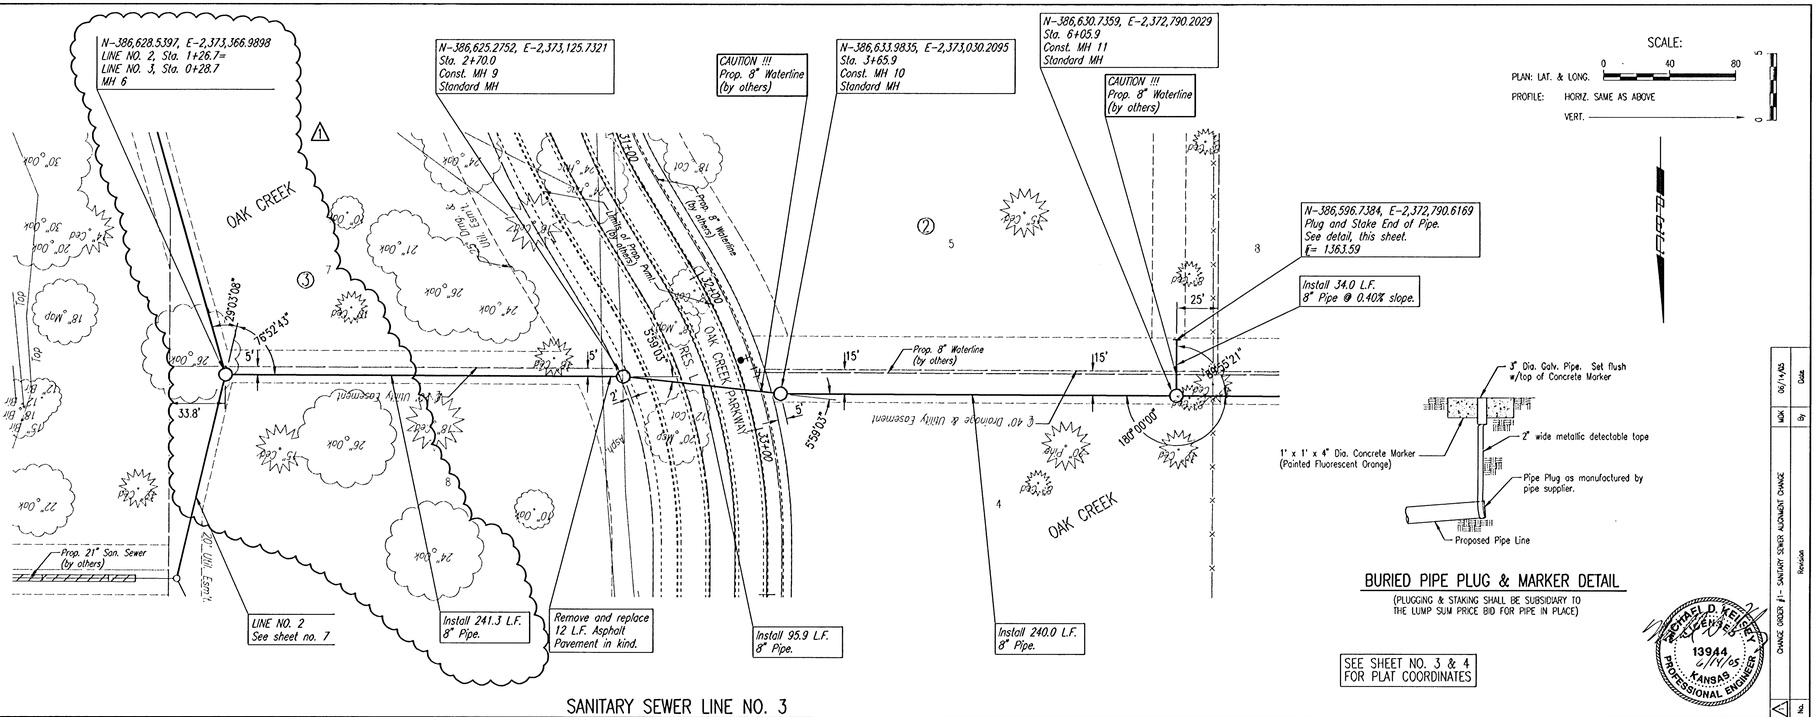

SANITARY SEWER LINE NO. 3

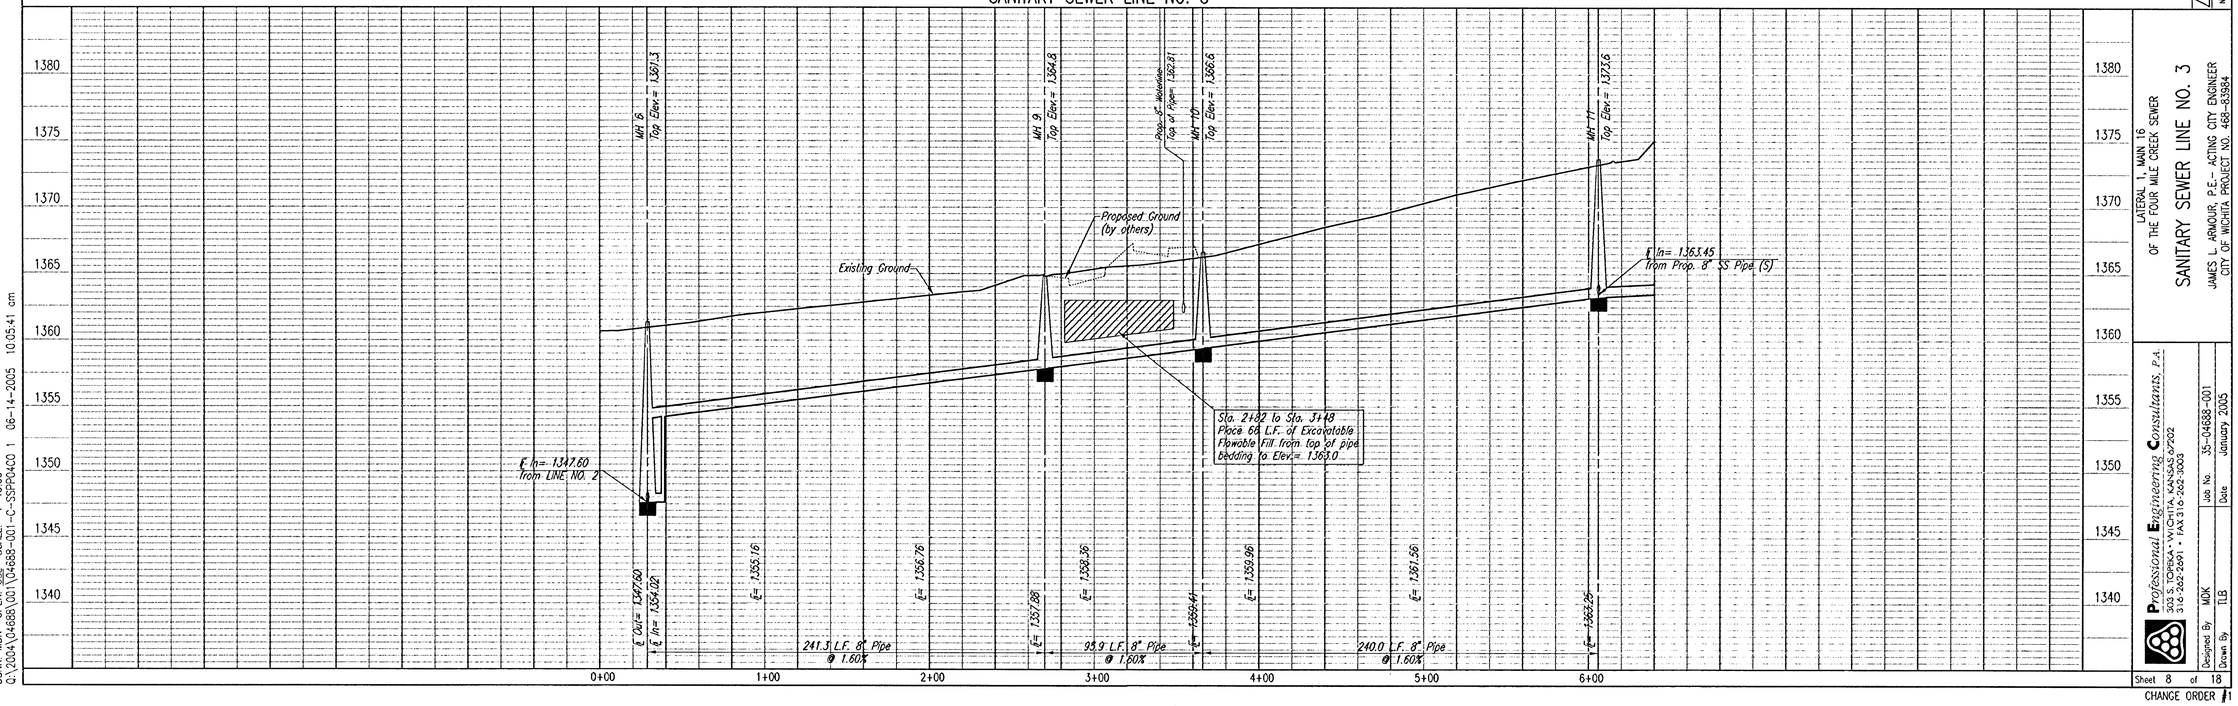

PLAN — CHECKED / CHECKED — BY — DATE

PROFILE — CHECKED / CHECKED — BY — DATE

DSNR: MDK OPER: CSL SCALE: 1=40.00
C:\2004\04688\001\04688-001-C-SSPP04CO 1 06-14-2005 10:05:41 cm

CHANGE ORDER #1

No.	Revision	By	Date
1	CHANGE ORDER #1 - SANITARY SEWER ALIGNMENT CHANGE	MDK	06/14/05

LATERAL 1, MAIN 16
OF THE FOUR MILE CREEK SEWER

SANITARY SEWER LINE NO. 3

JAMES L. ARMOUR, P.E. - ACTING CITY ENGINEER
CITY OF WICHITA PROJECT NO. 468-83984

Professional Engineering Consultants, P.A.
305 S. Topeka • Wichita, KS 67202
316-262-2691 • FAX 316-262-8003

Designed By	MDK	Job No.	35-04688-001
Drawn By	TLB	Date	January 2005

Sheet 8 of 18