

PLAN	CHECKED	DATE
	CHECKED	

PROFILE	CHECKED	DATE
	CHECKED	



DSNR: MDK OPER. JGA SCALE: 1"=40.00  
 C:\2004\04688\001\04688-001-C-SSPP06 05-03-2005 09:55:32 am

N-385,269.8124, E-2,374,042.9405  
 Sta. 0+00.0  
 Const. MH 15  
 Standard MH

CAUTION !!!  
 Proposed 15" RCP Storm  
 Sewer (by others)

N-385,259.4665, E-2,373,643.0743  
 Sta. 4+00.0  
 Const. MH 16  
 Standard MH

N-385,272.8269, E-2,373,514.3560  
 Sta. 5+29.4  
 Const. MH 17  
 Standard MH

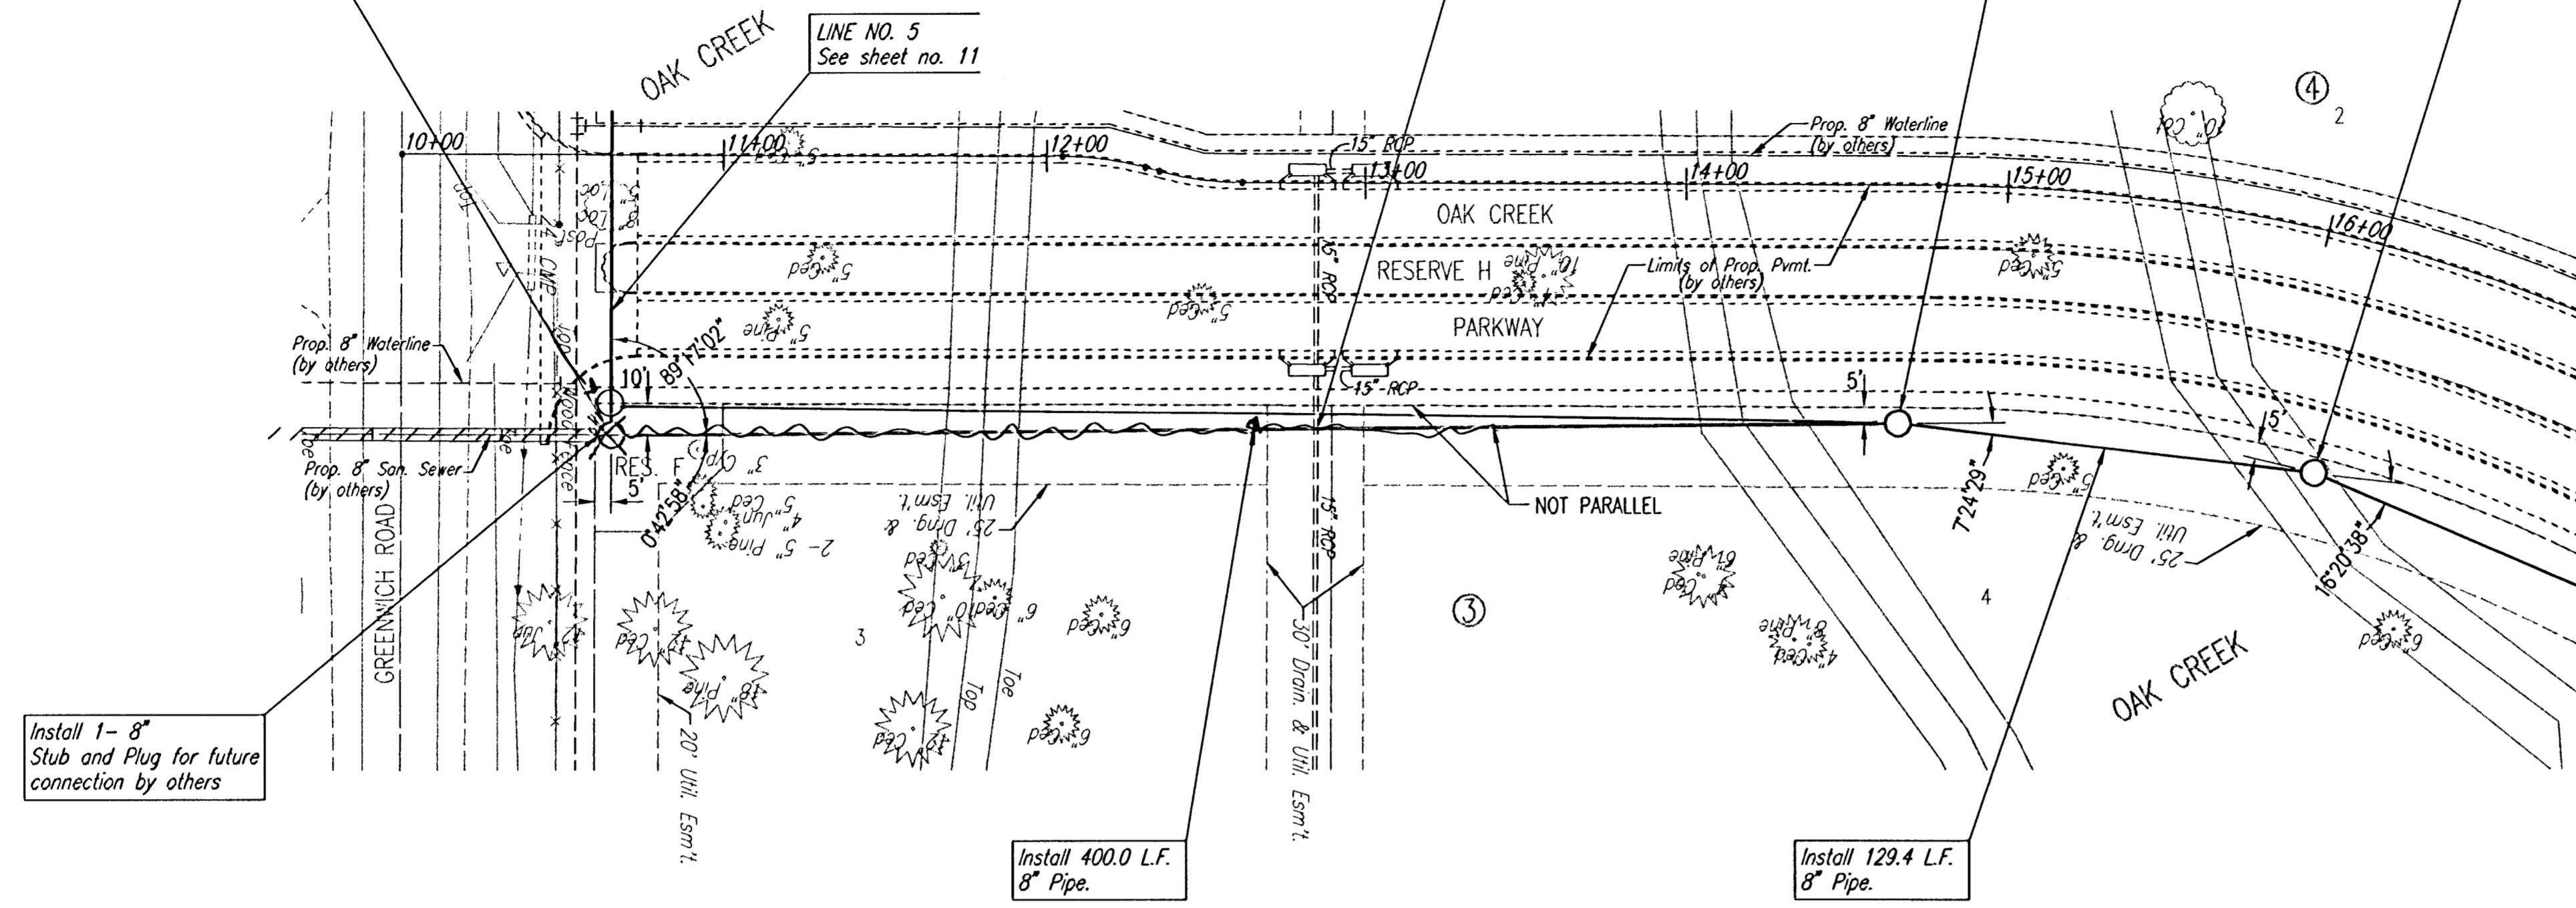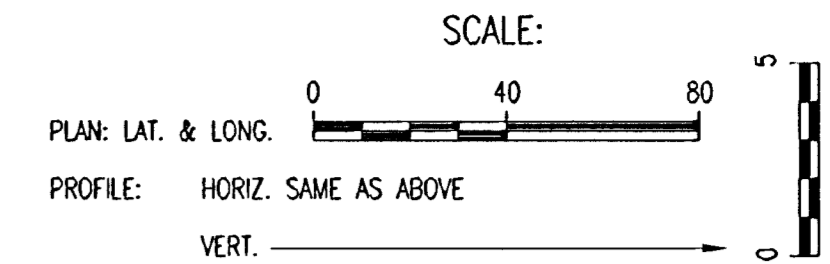


Install 1- 8" Stub and Plug for future connection by others


Install 400.0 L.F. 8" Pipe.

Install 129.4 L.F. 8" Pipe.

SEE SHEET NO. 3 & 4 FOR PLAT COORDINATES

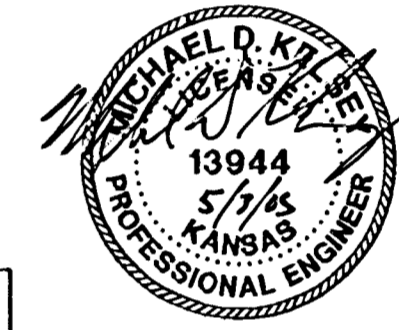

SANITARY SEWER LINE NO. 4

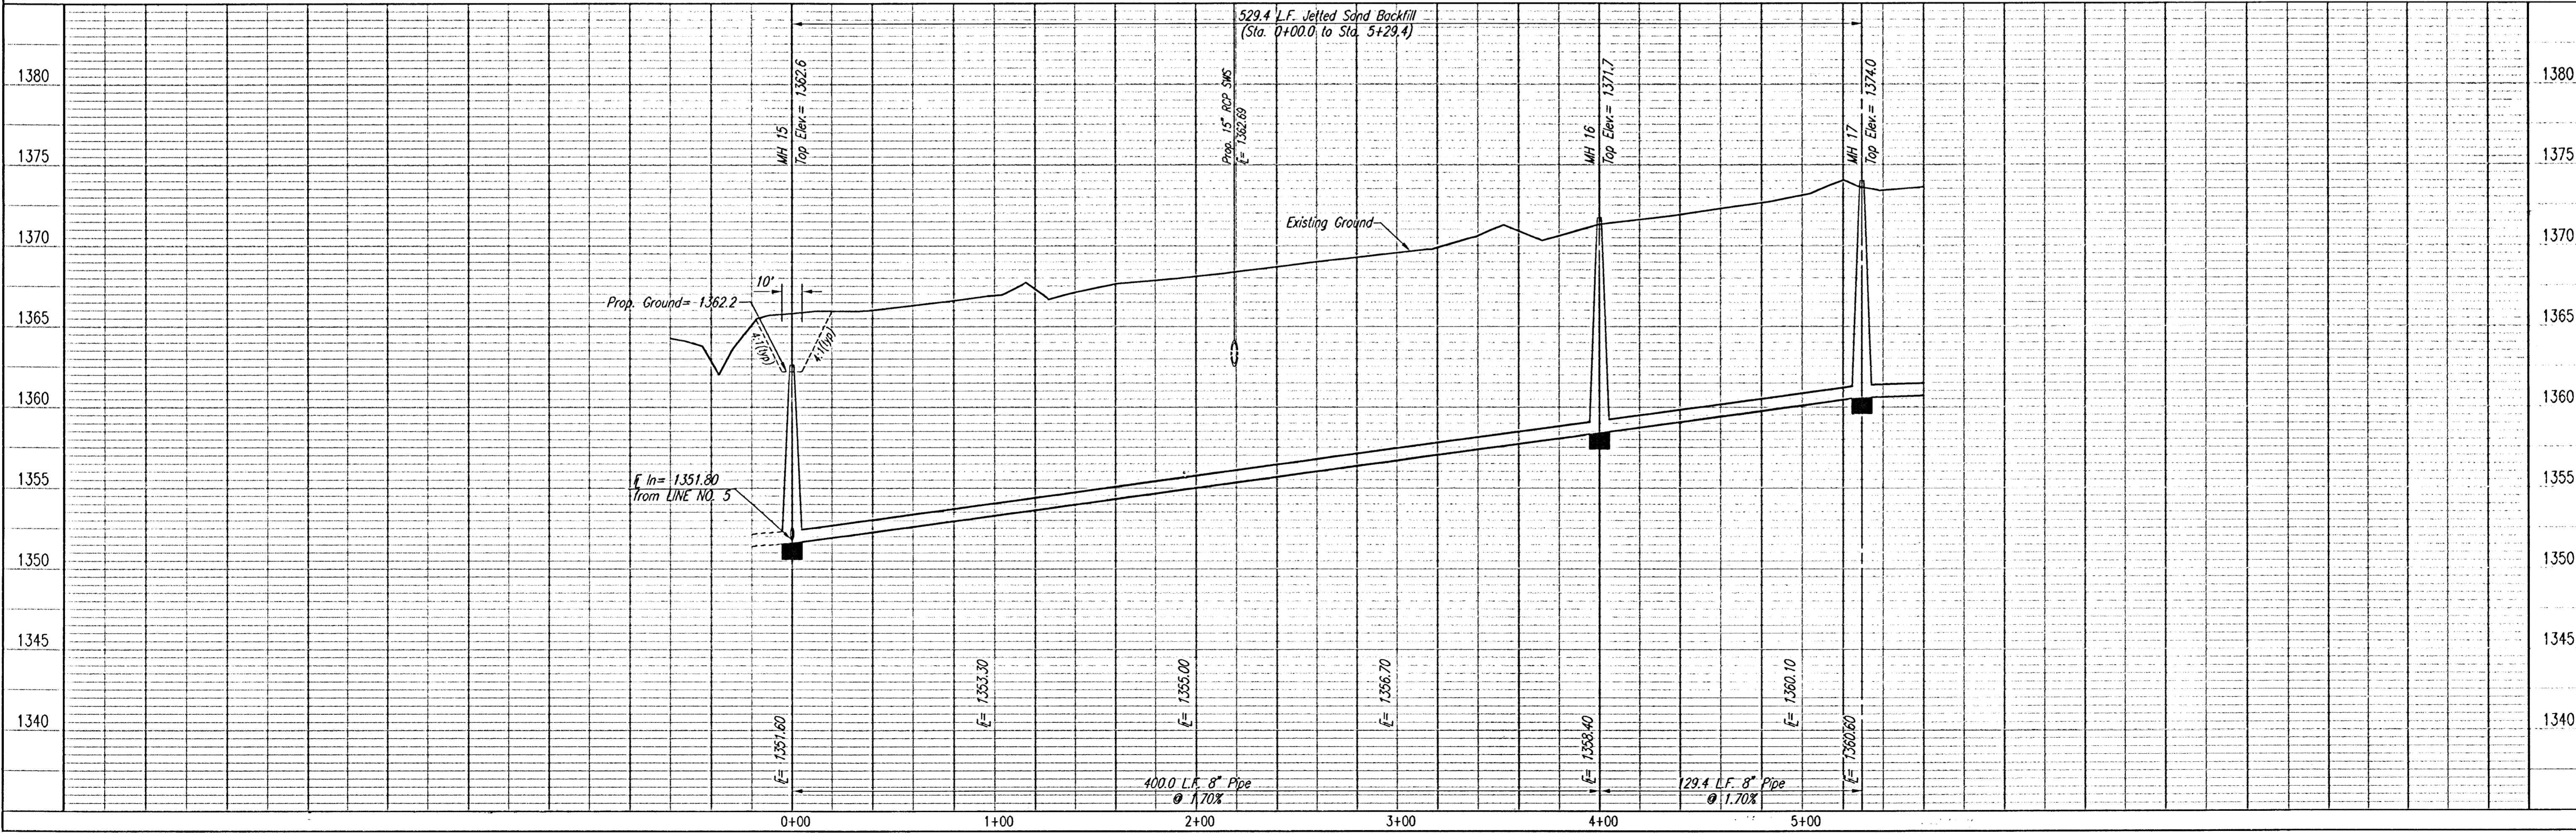

LATERAL 1, MAIN 16  
 OF THE FOUR MILE CREEK SEWER  
**SANITARY SEWER LINE NO. 4**  
 JAMES L. ARMOUR, P.E. - ACTING CITY ENGINEER  
 CITY OF WICHITA PROJECT NO. 468-83984

Professional Engineering Consultants, P.A.  
 303 S. TORREYA WICHITA, KANSAS 67202  
 316-262-2091 • FAX 316-262-3003

Designed By: MDK  
 Drawn By: TLB

Job No. 35-04688-001  
 Date: January 2005