
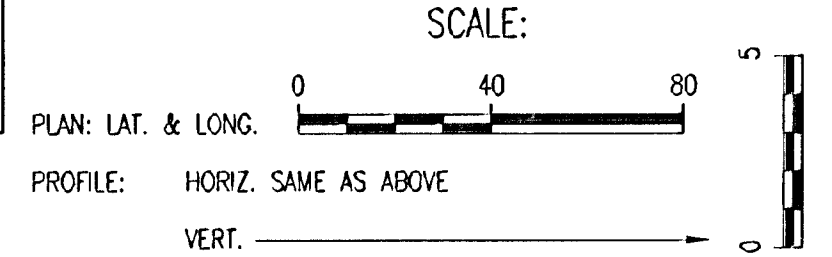
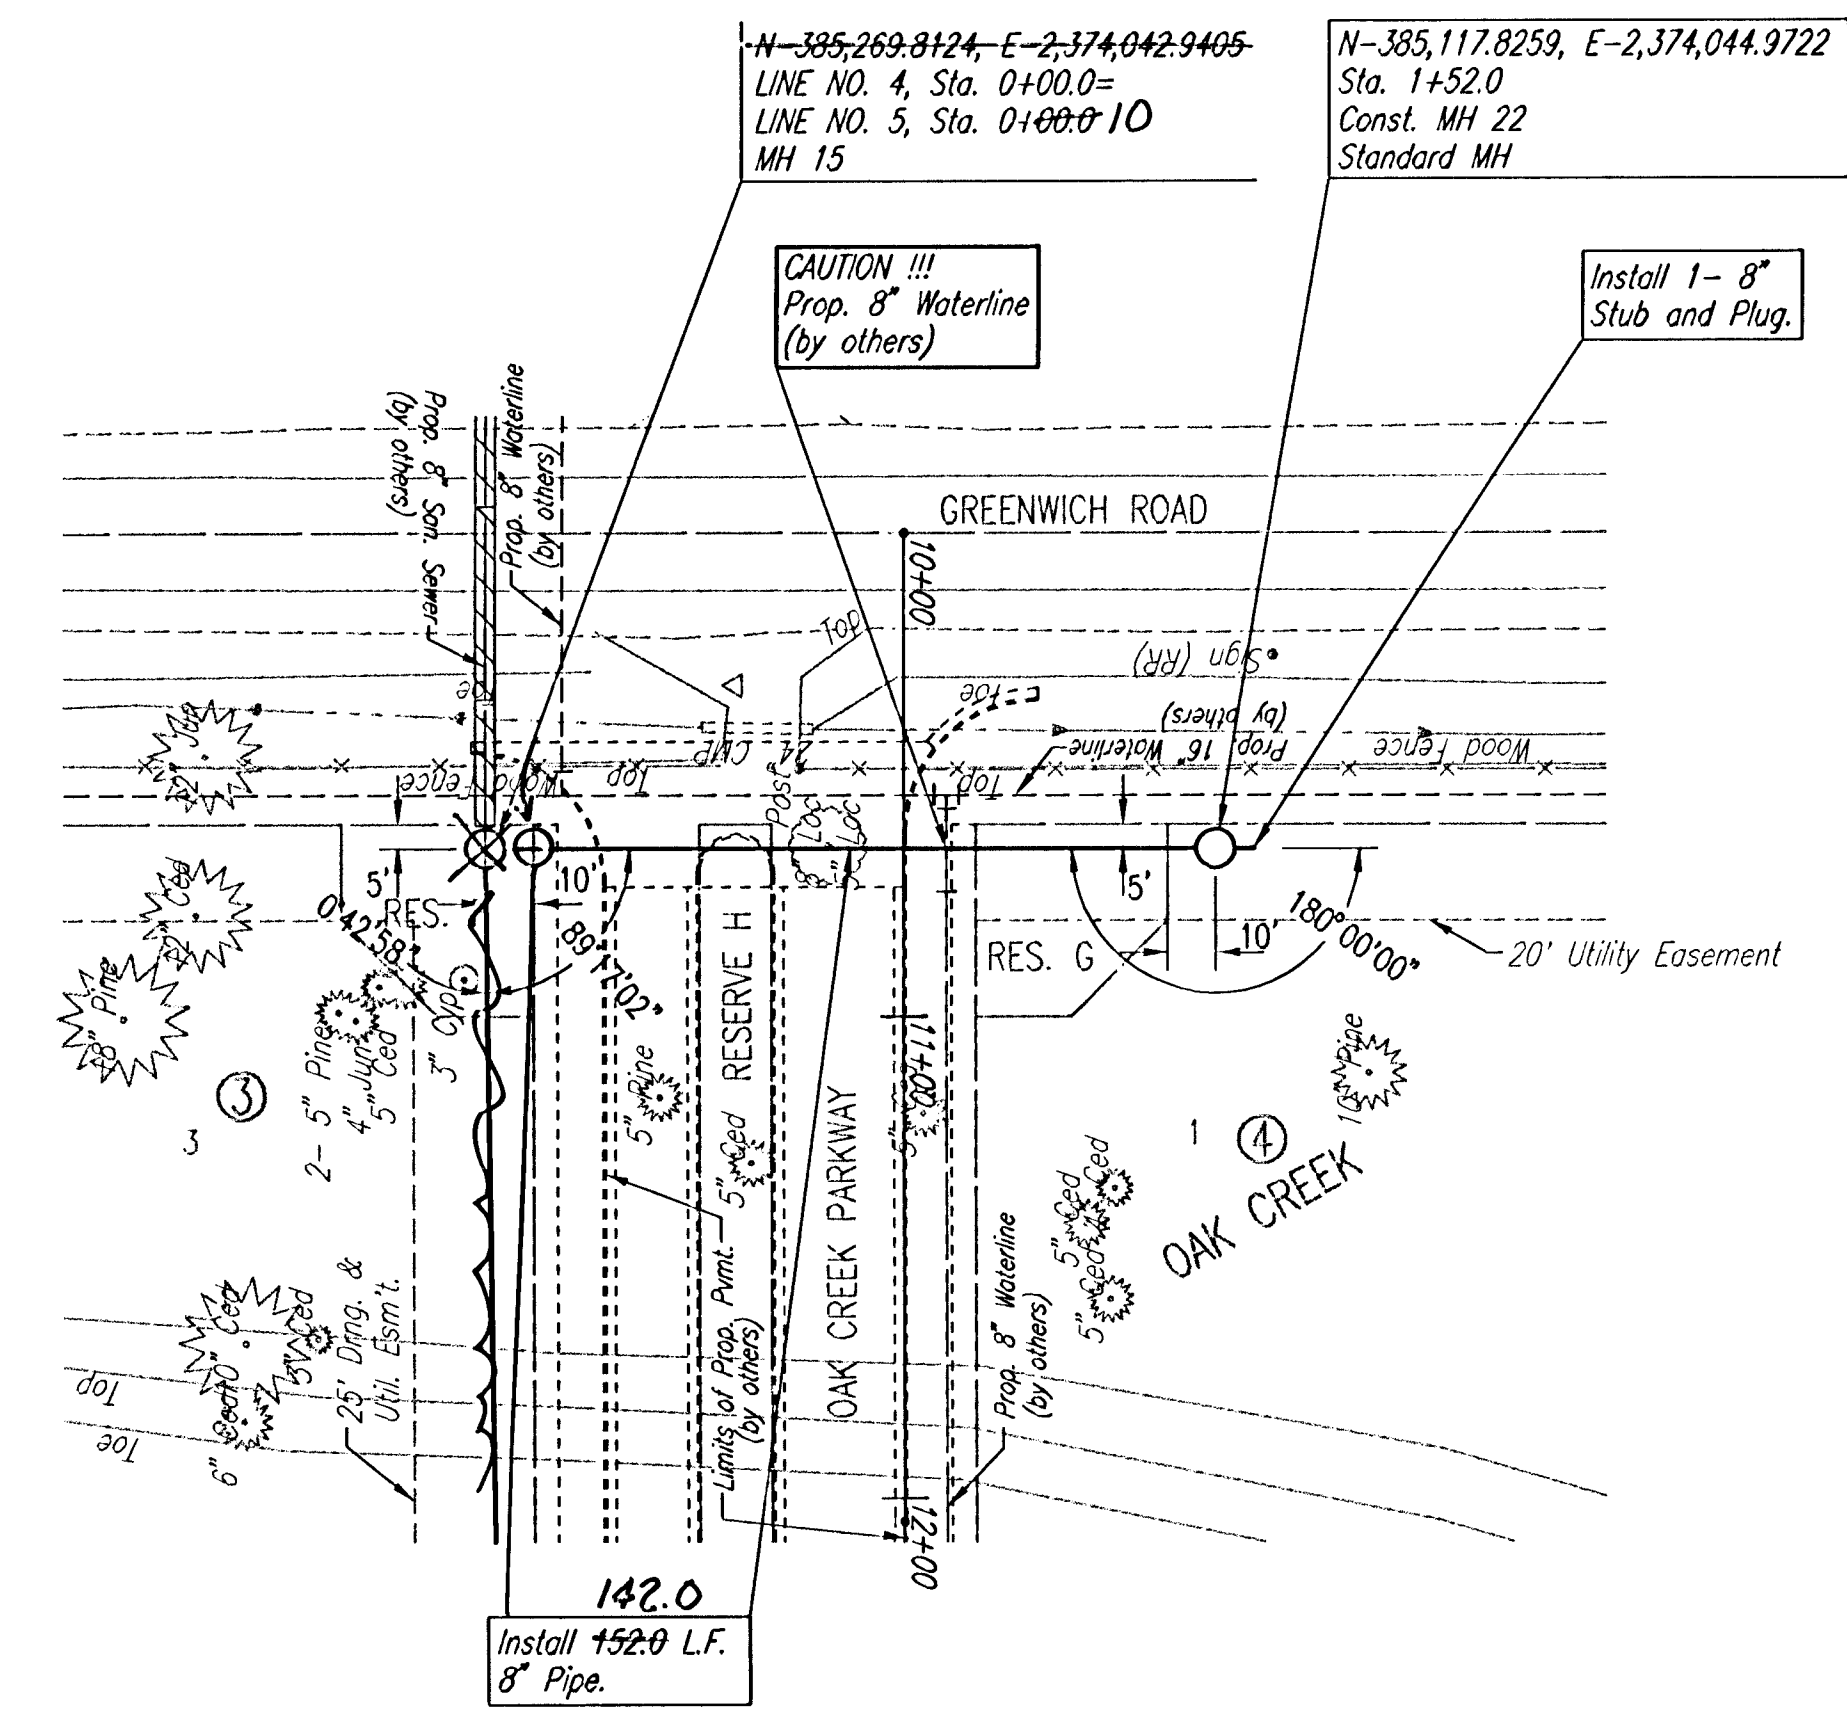



PLAN	CHECKED	DATE
	CHECKED	

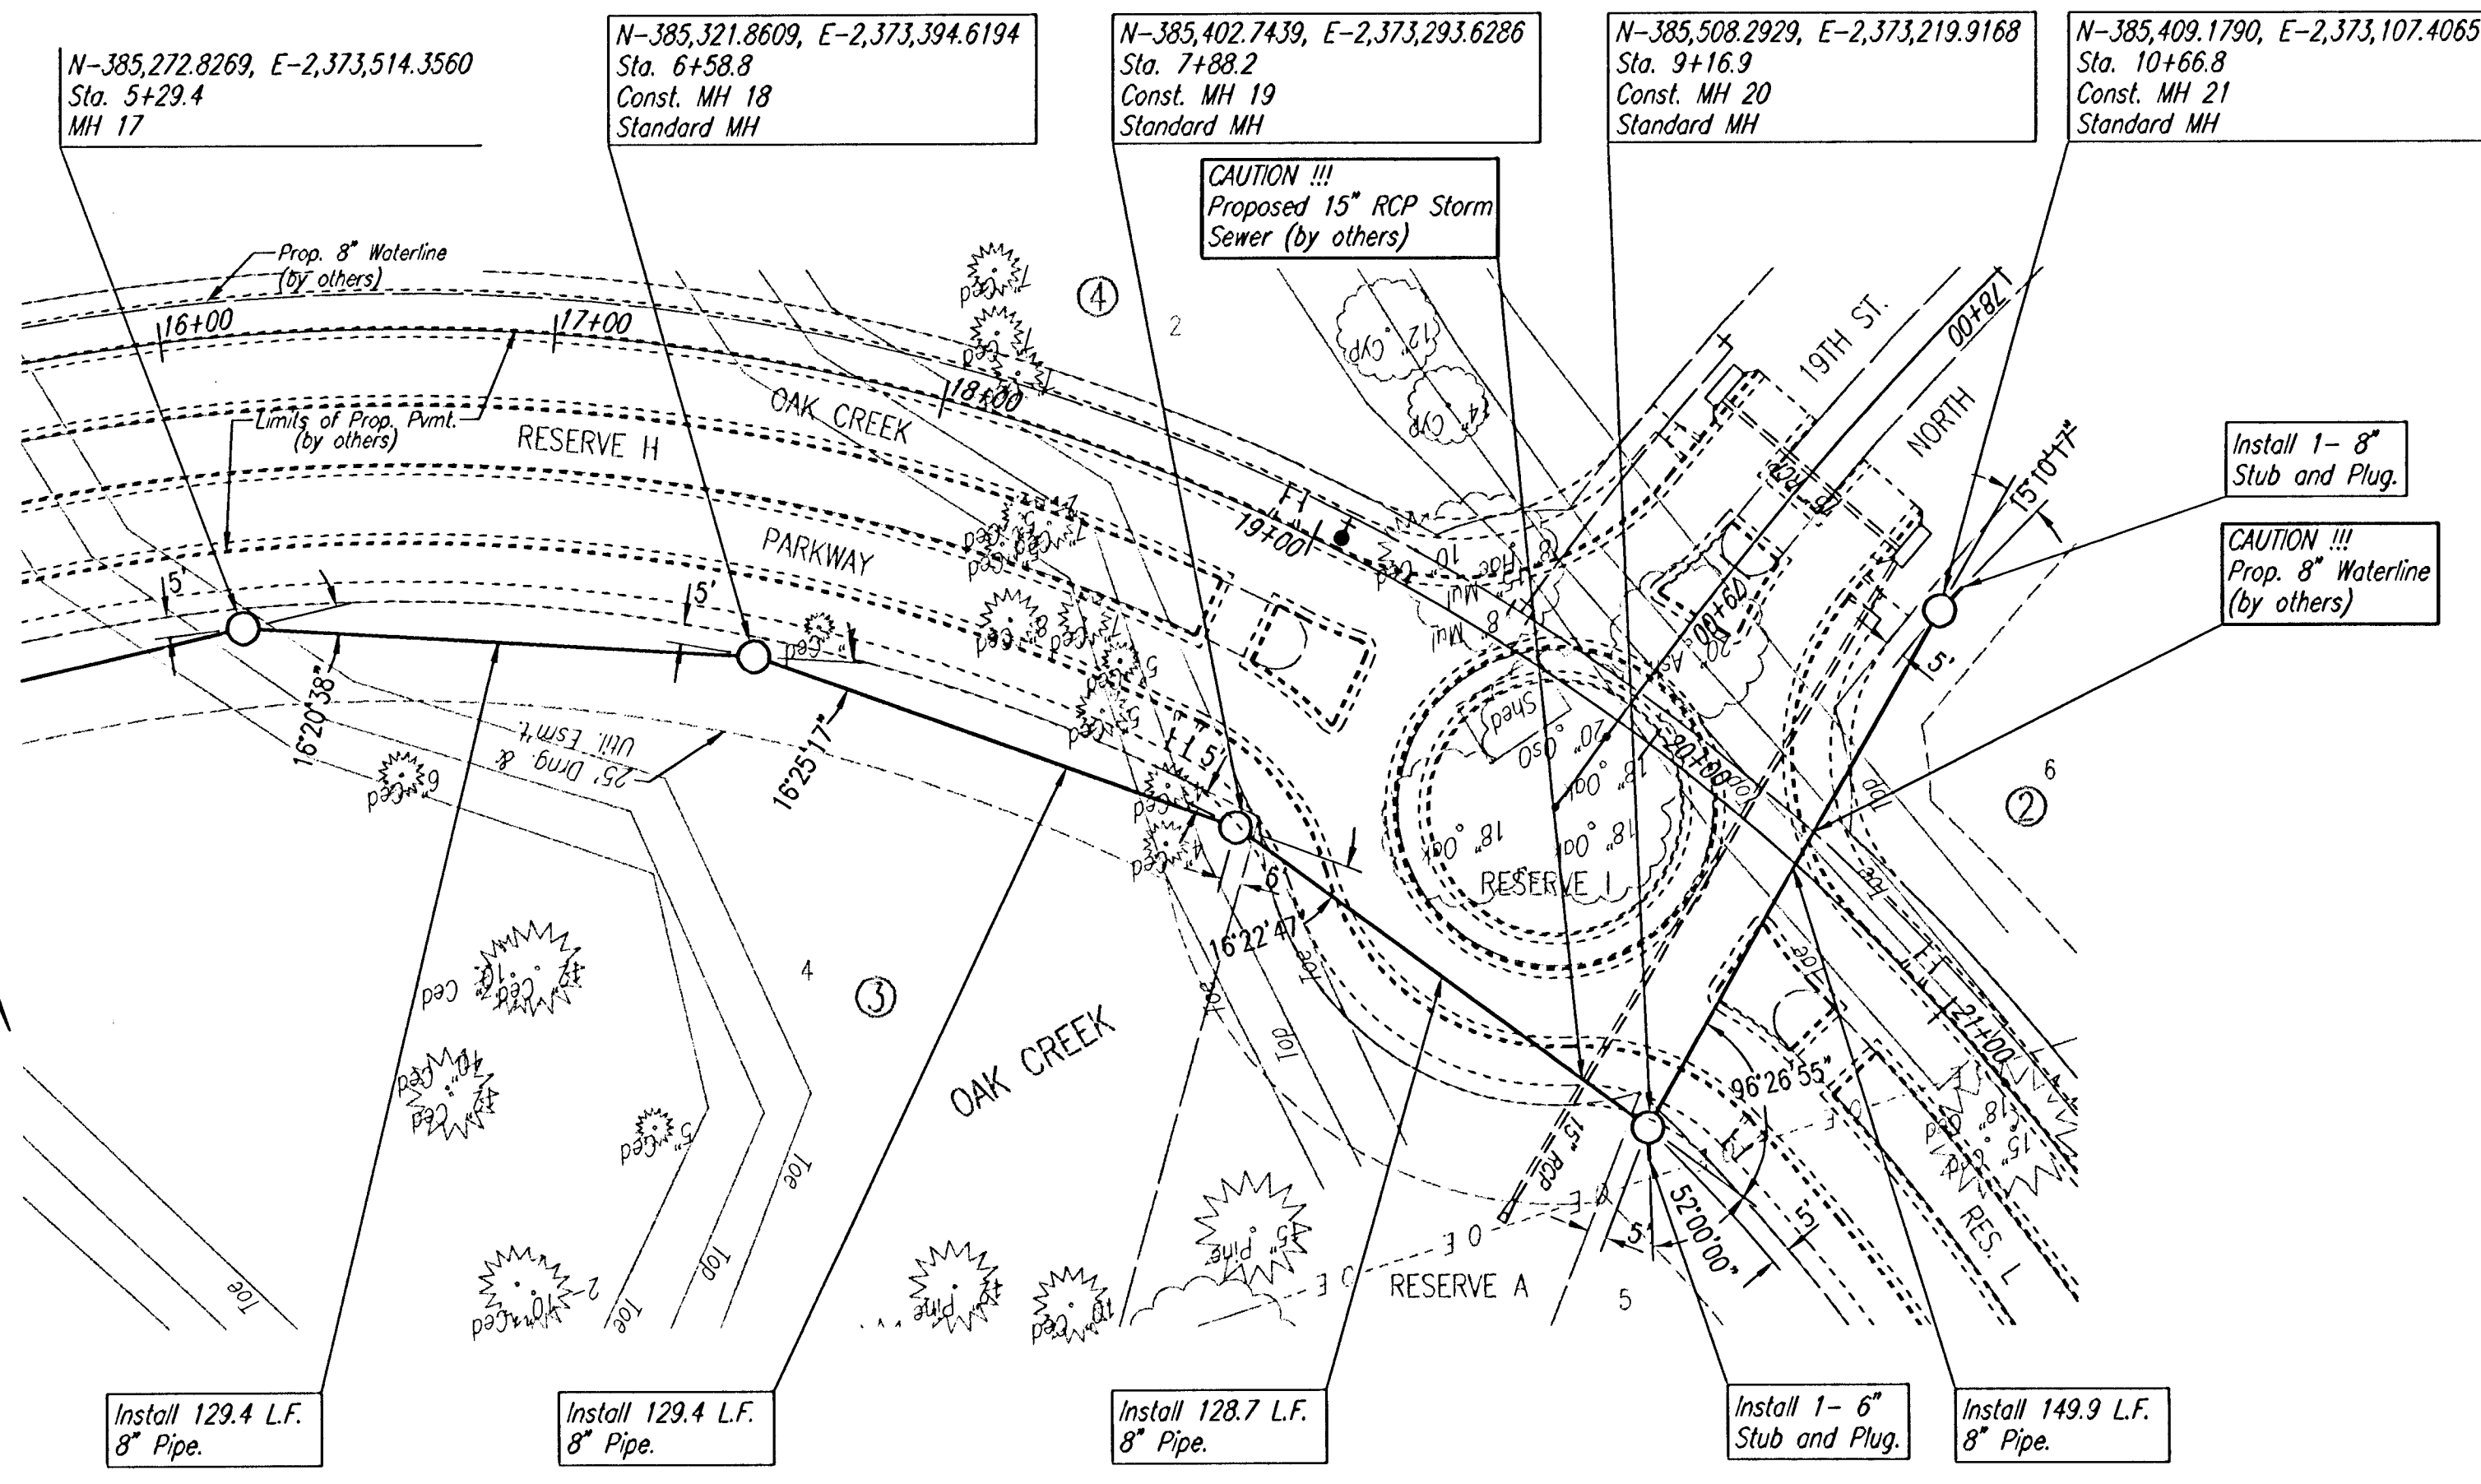


SEE SHEET NO. 3 & 4 FOR PLAT COORDINATES

PROFILE	CHECKED	DATE
	CHECKED	

SANITARY SEWER LINE NO. 4

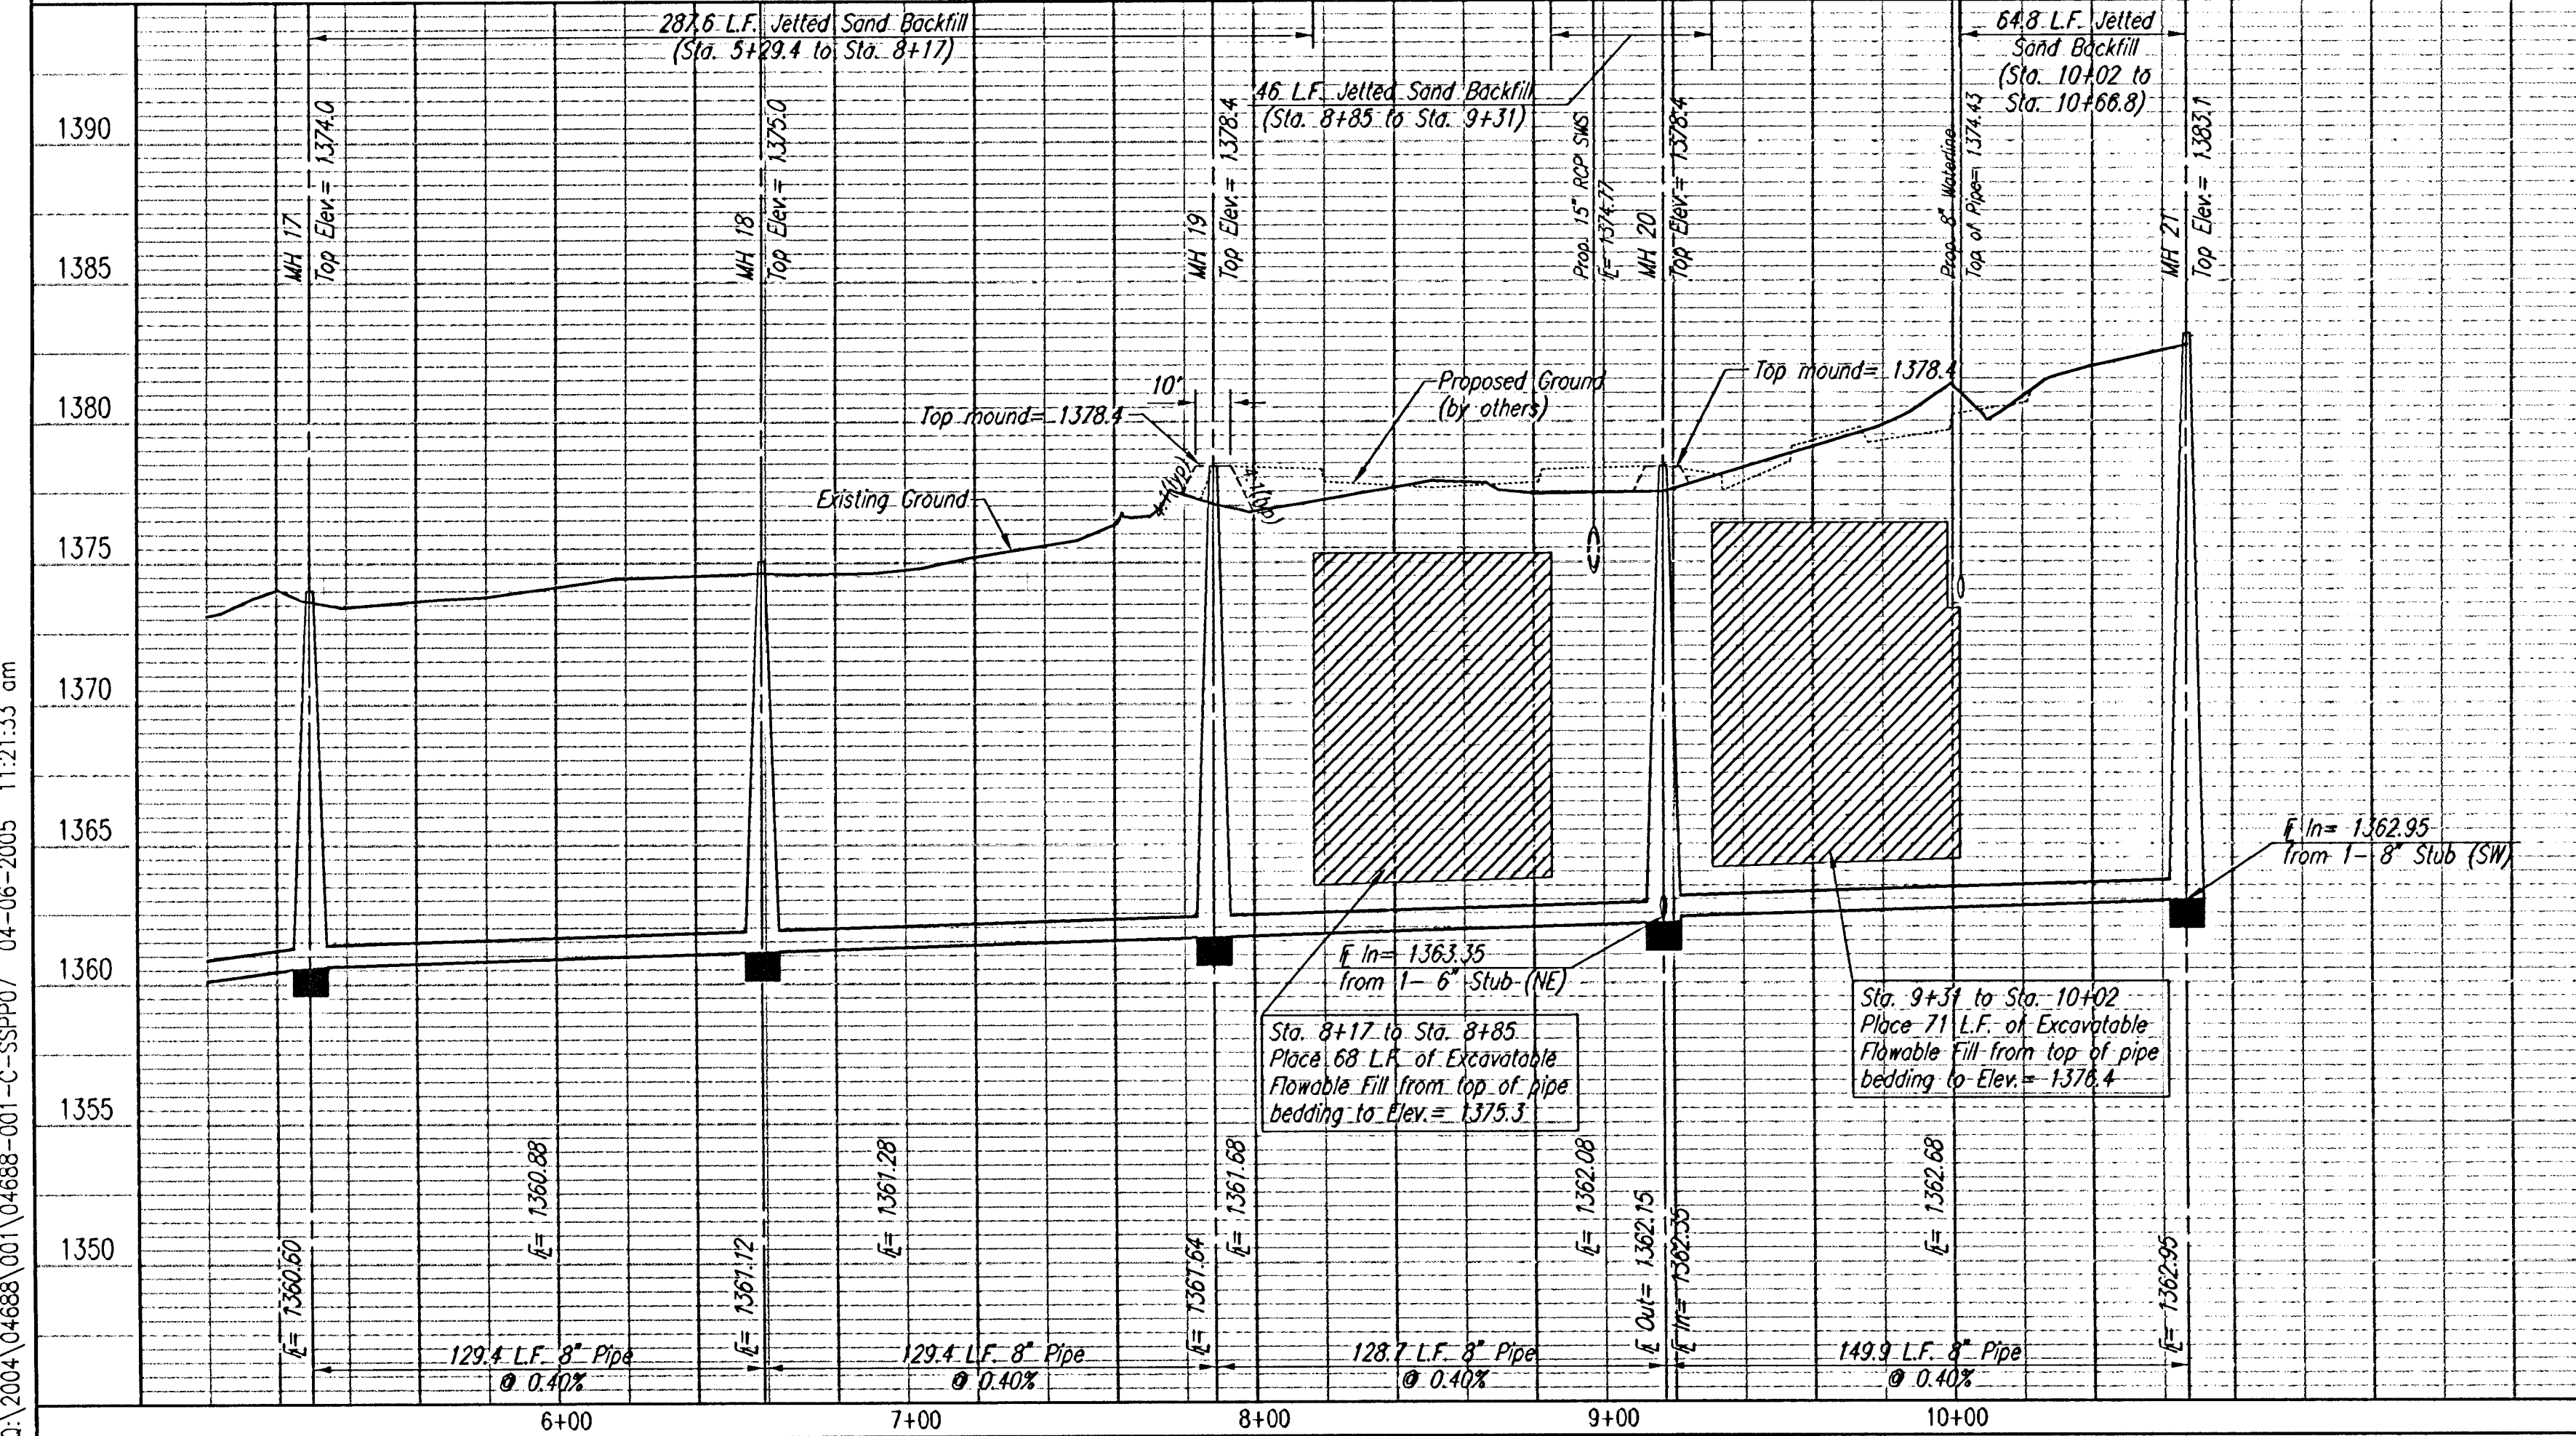

SANITARY SEWER LINE NO. 5

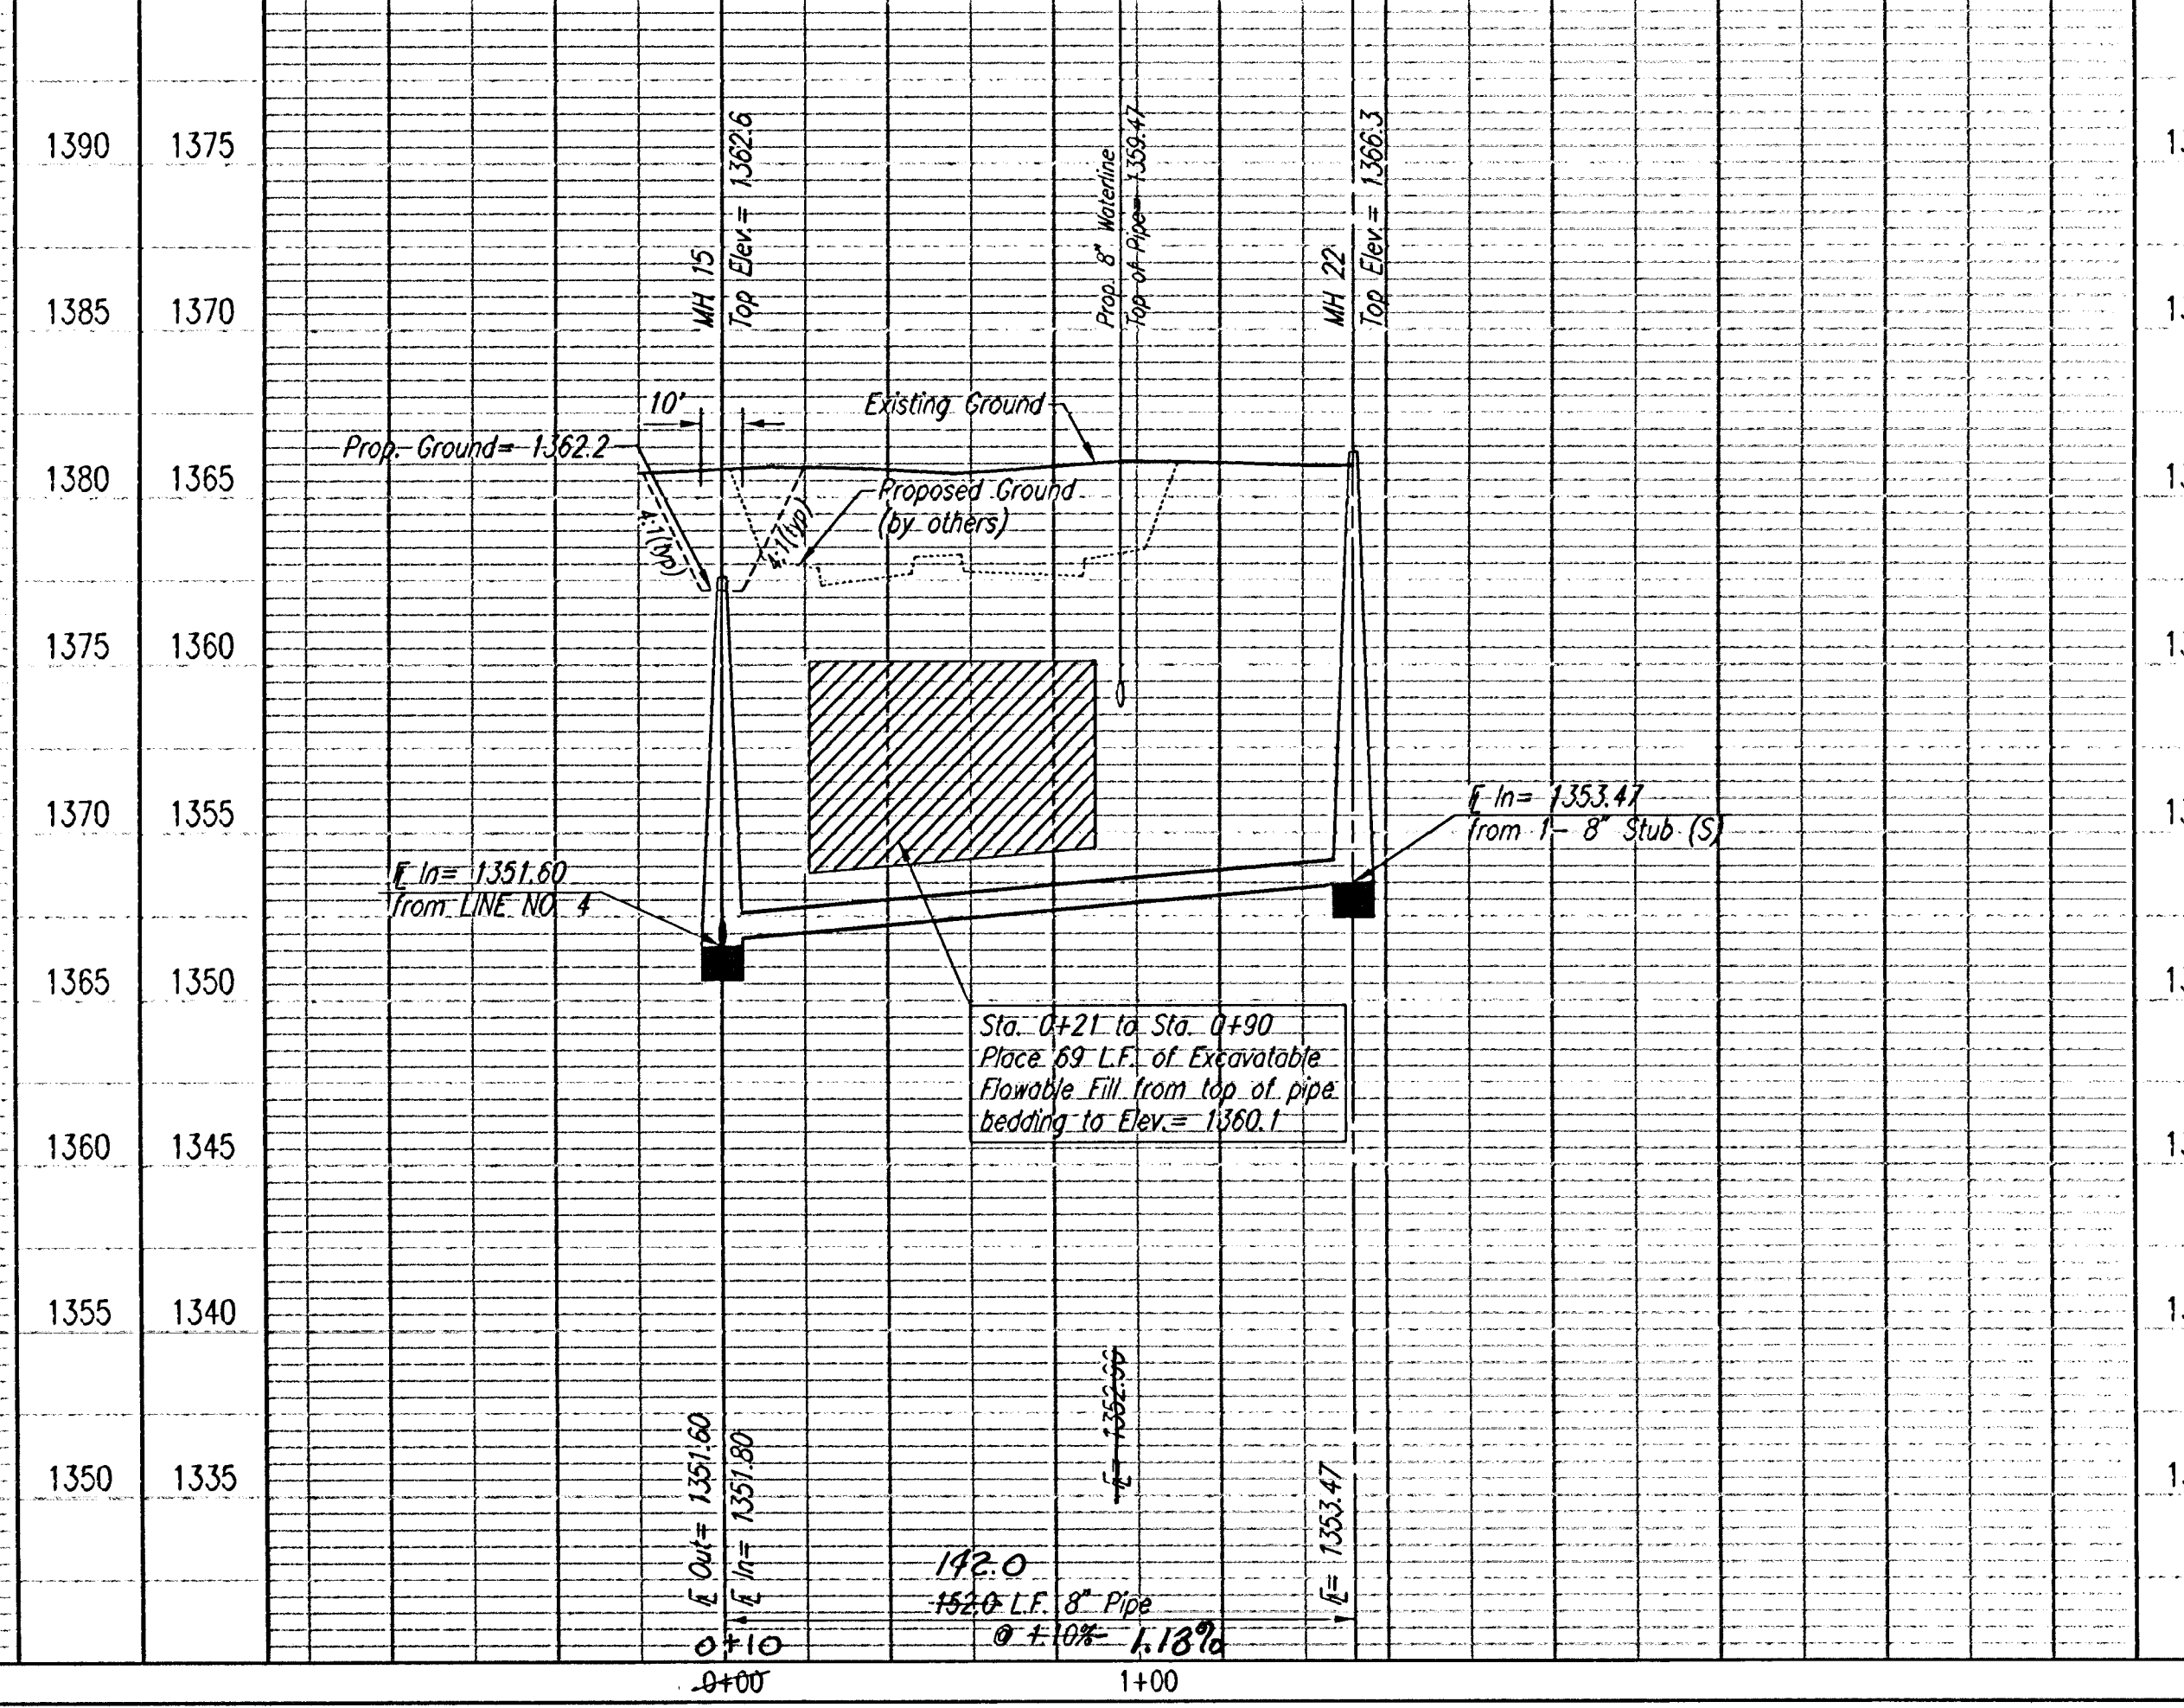

DSNR: MDK OPER: JLM SCALE: 1=40.00  
 01/2004/04688/001/04688-001-C-SSPP07 04-06-2005 11:21:33 am

LATERAL 1, MAIN 16  
 OF THE FOUR MILE CREEK SEWER  
**SANITARY SEWER LINE NO. 4 & 5**  
 JAMES L. ARMOUR, P.E. - ACTING CITY ENGINEER  
 CITY OF WICHITA PROJECT NO. 468-83984

Professional Engineering Consultants, P.A.  
 303 S. TOPEKA - WICHITA, KANSAS 67202  
 316-262-2691 • FAX 316-262-3003

Designed By: MDK  
 Drawn By: TLB  
 Job No.: 35-04688-001  
 Date: January 2005