




USINK: OPER: JGA SCALE: 1=40.00
O:\2004\04090\000\Change Order No. 1\04090-000-C-SSPP01 05-05-2005 01:10:49 pm

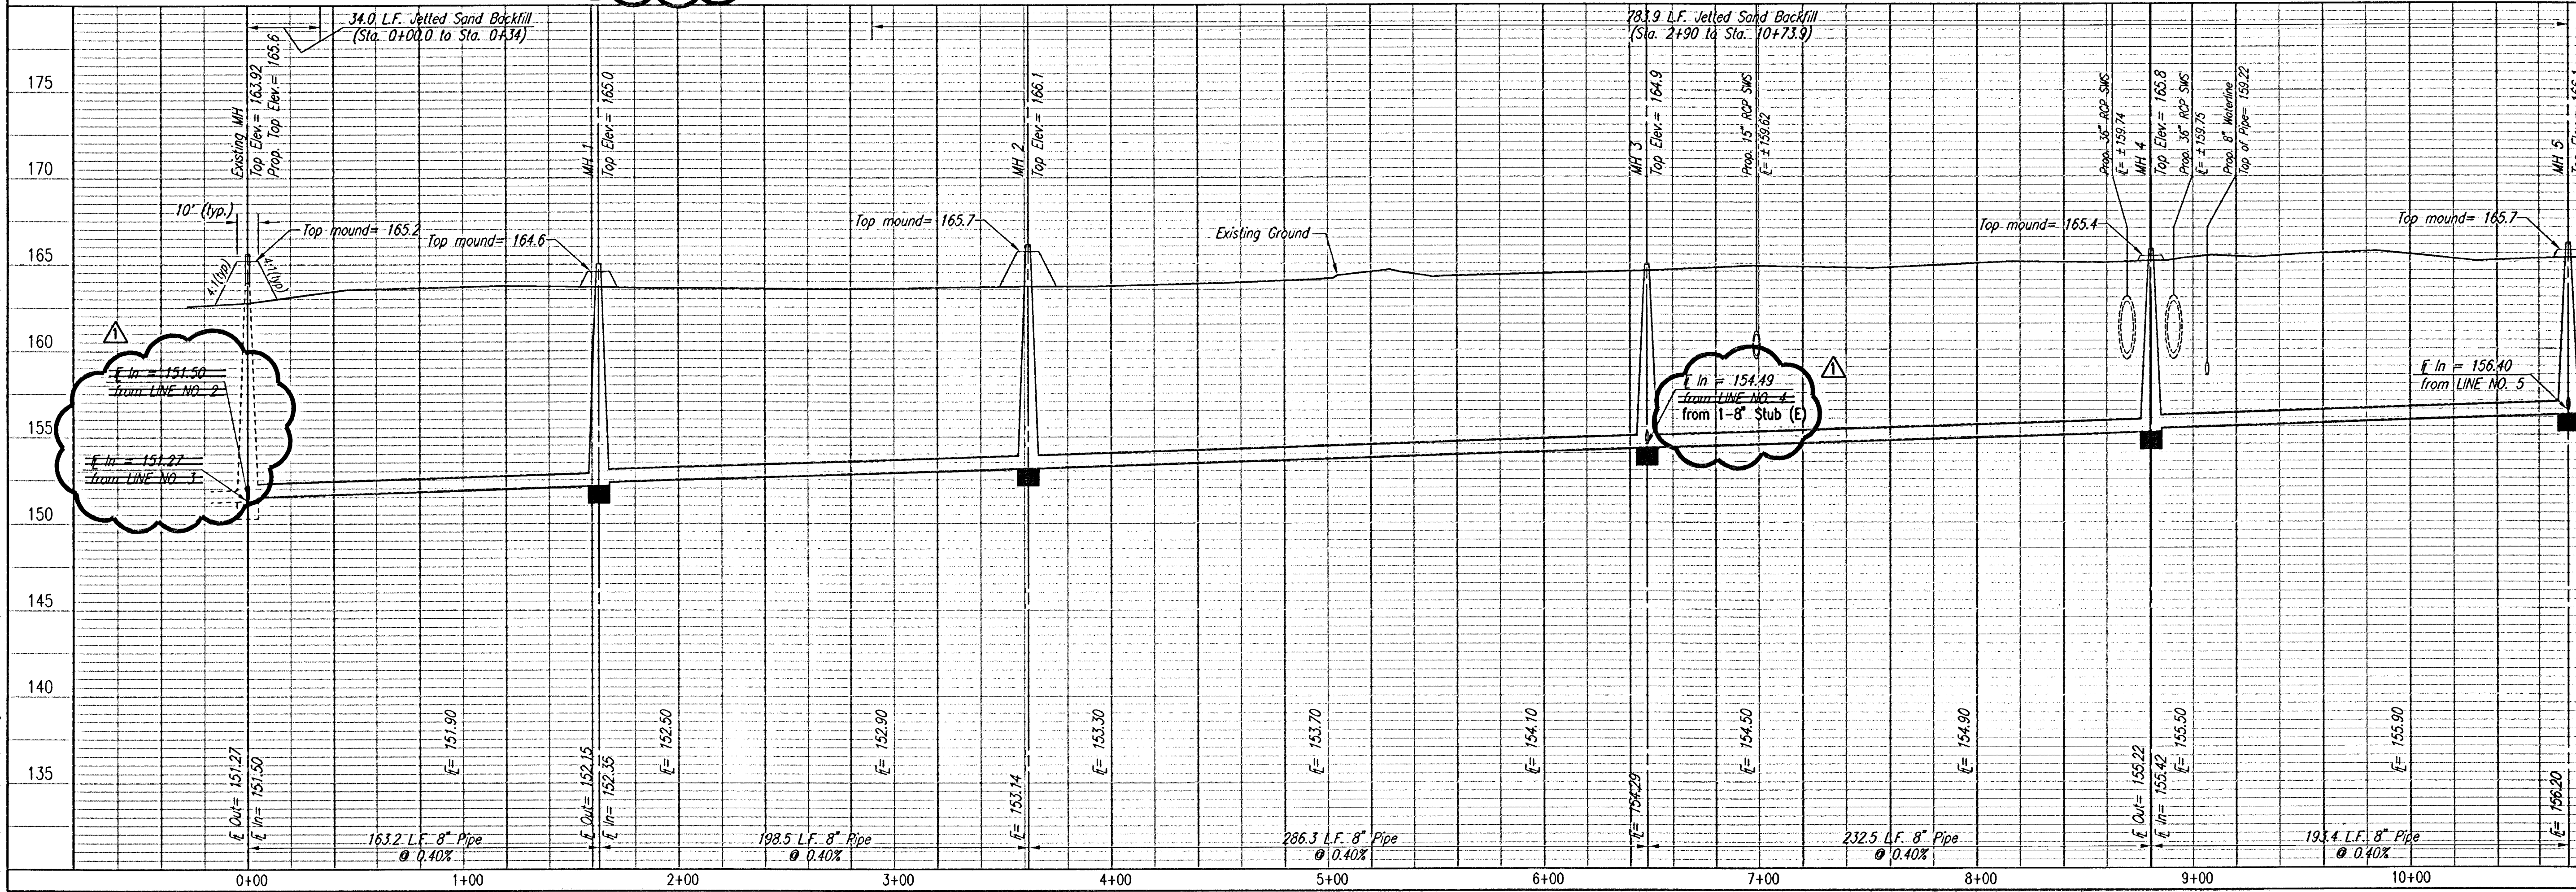

SAME AS ABOVE

LATERAL 1, MAIN 6 OF THE
NORTHWEST INTERCEPT SEWER

SANITARY SEWER LINE NO. 1

JAMES L. ARMOUR, P.E. - ACTING CITY ENGINEER
CITY OF WICHITA PROJECT NO. 468-83969



Professional Engineering Consultants, P.A.
303 S. TOPEKA • WICHITA, KANSAS 67202
316-262-2691 • FAX 316-262-3003

Designed By	MDK	Job No.	35-04090-5054
Drawn By	JCA	Date	January 2005

CHANGE ORDER NO. 1 5-02-05