

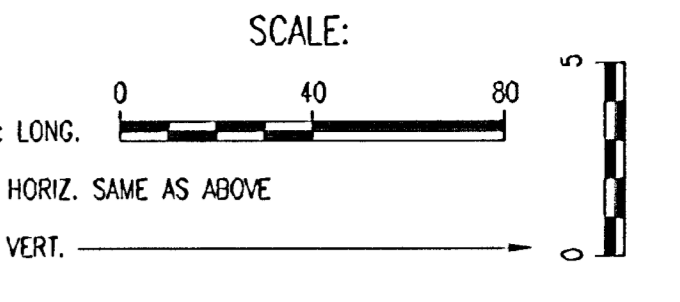



DATE	
BY	
CHECKED	
CHECKED	
PLAN	

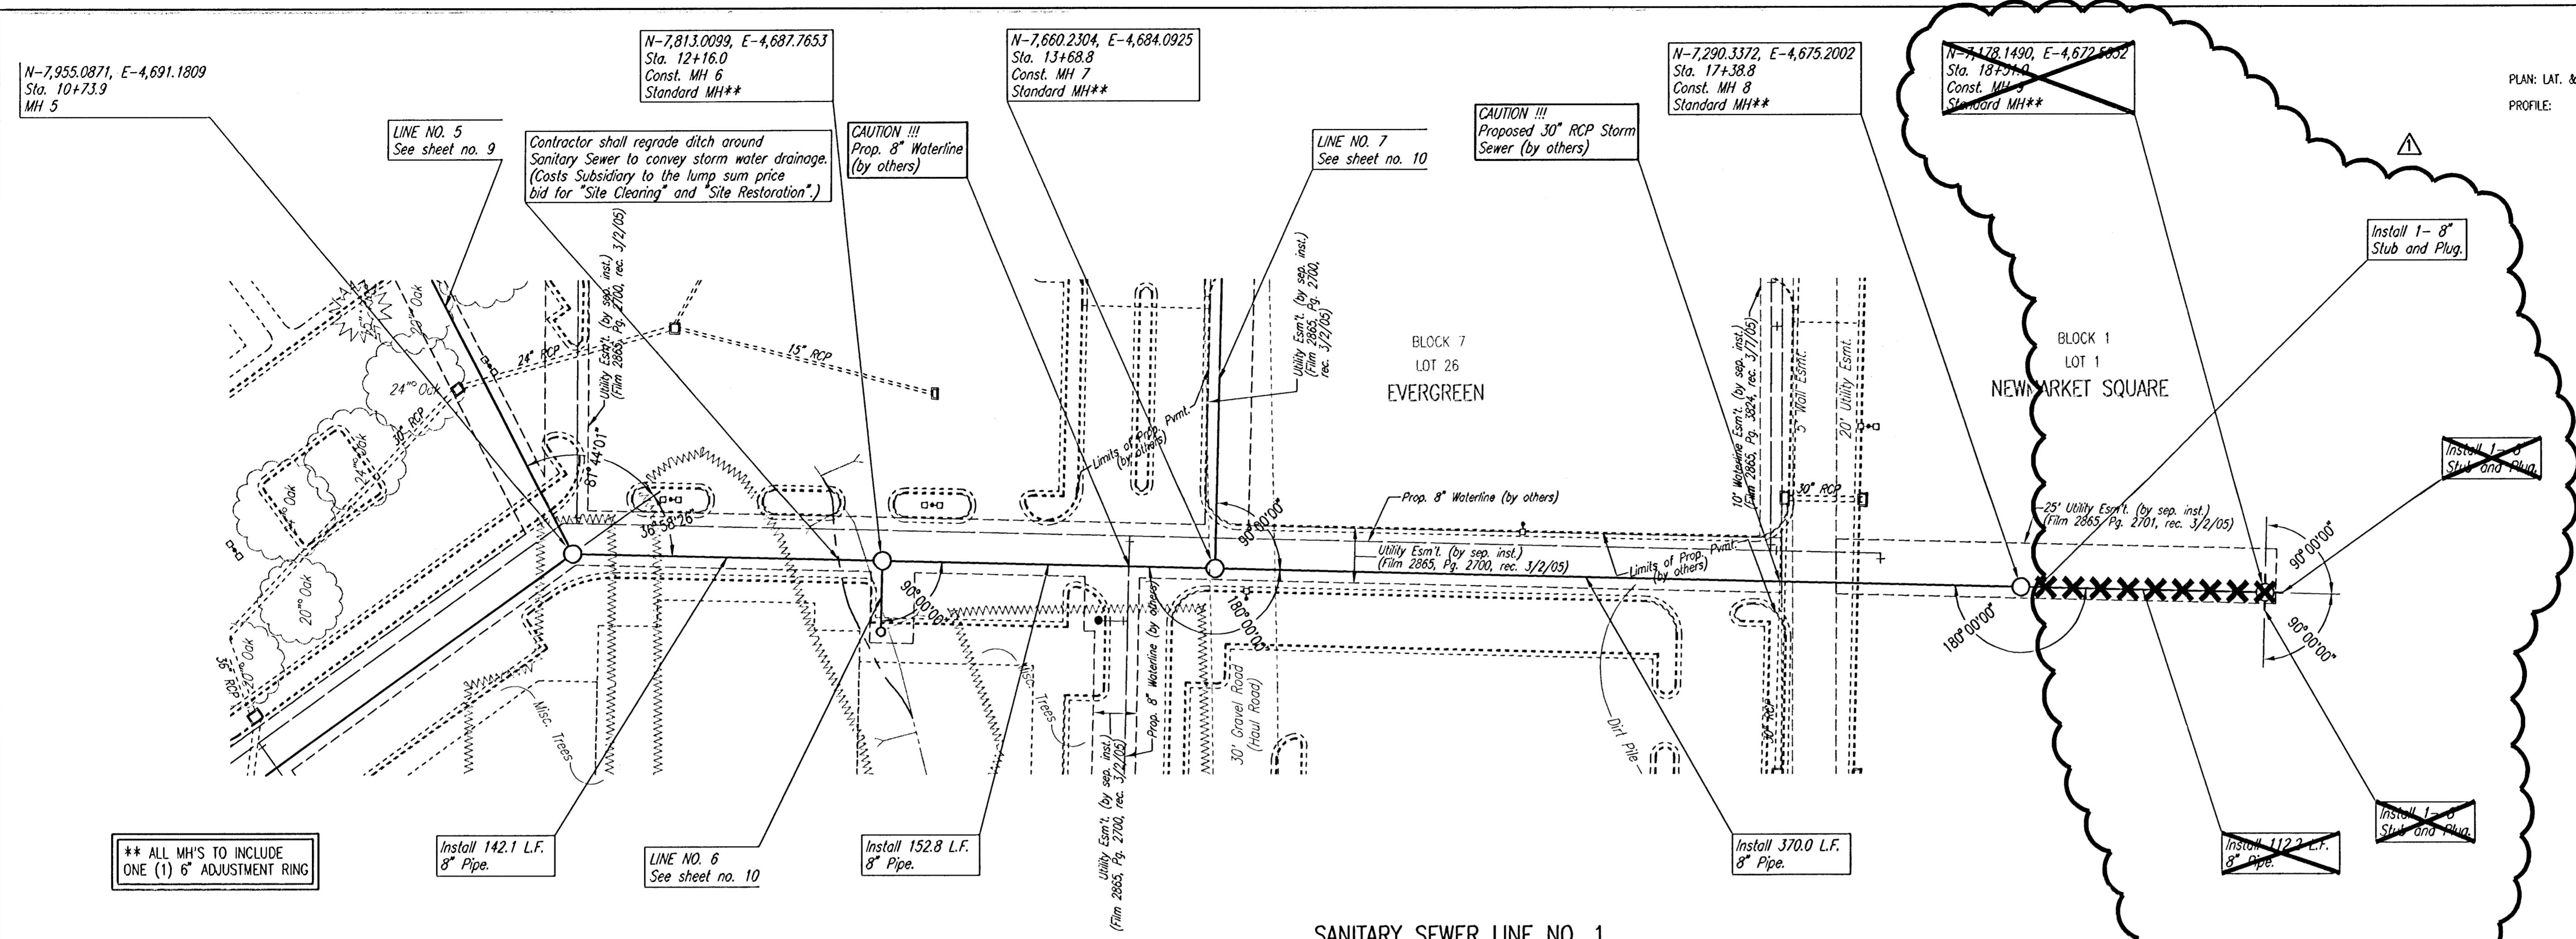

SEE SHEET NO. 3, 4, AND 5 FOR PLAT COORDINATES

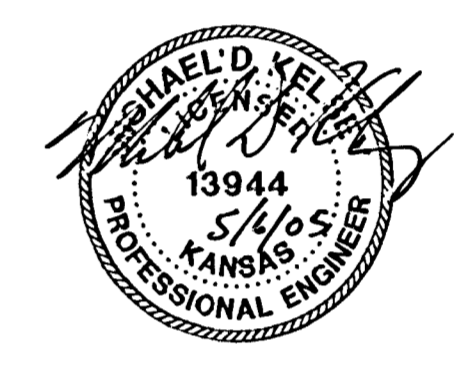

DATE	
BY	
CHECKED	
CHECKED	
PROFILE	

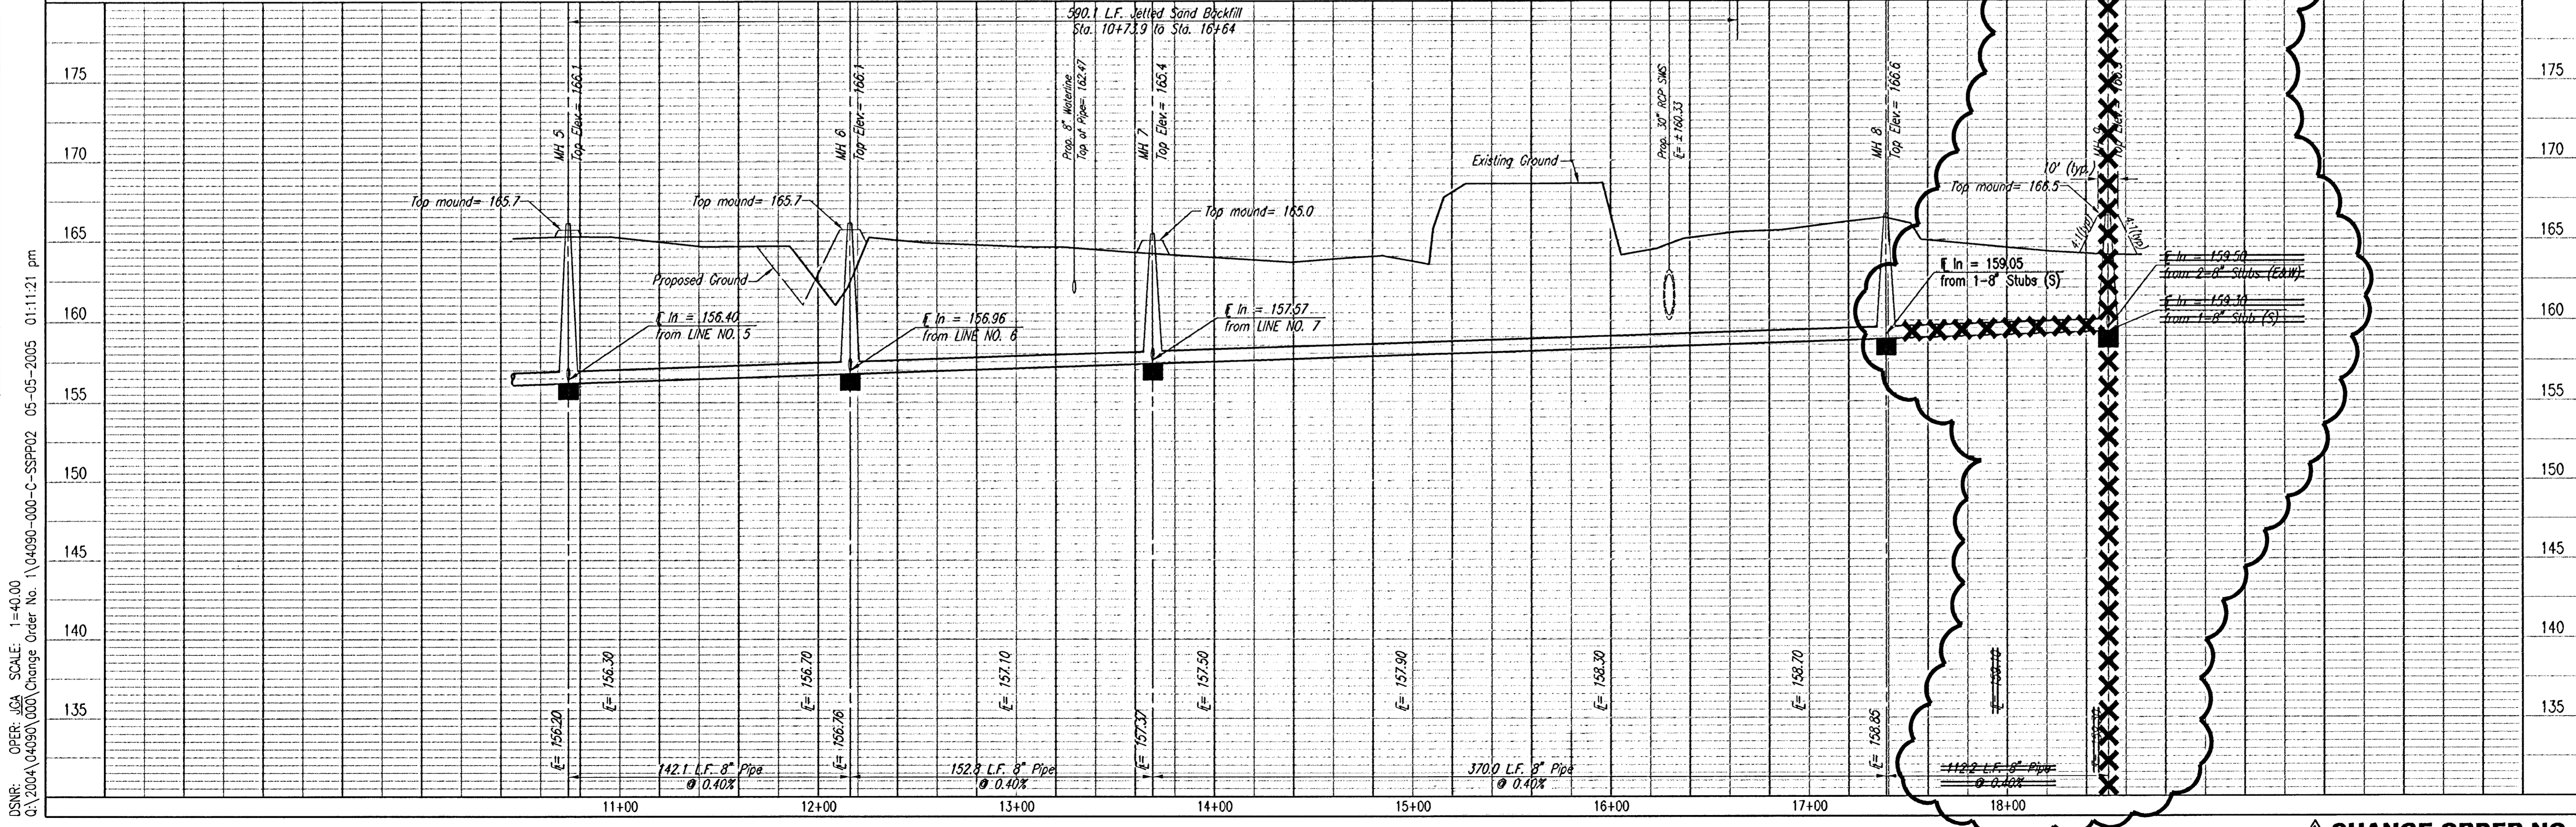

LATERAL 1, MAIN 6 OF THE NORTHWEST INTERCEPTOR SEWER

**SANITARY SEWER LINE NO. 1**

JAMES L. ARMOUR, P.E. - ACTING CITY ENGINEER  
CITY OF WICHITA PROJECT NO. 488-83669

Professional Engineering Consultants, P.A.  
303 S. TOPICKA • WICHITA, KANSAS 67202  
316-262-2691 • FAX 316-262-3003

Designed By: MDK  
Drawn By: JGA  
Job No.: 35-04090-5054  
Date: January 2005

Sheet 7 of 18

DSNR: OPER. JGA SCALE: 1"=40.00  
C:\2004\04090\000\Change Order No. 1\04090-000-C-SSPP02 05-05-2005 01:11:21 pm