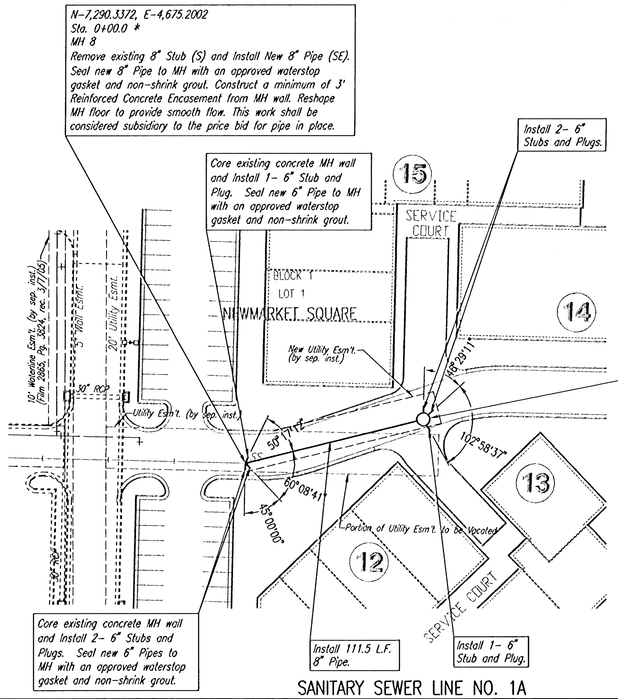

SCALE:
0 40 80
PLAN: LAT. & LONG.
PROFILE: HORIZ. SAME AS ABOVE
VERT.

* PRIOR TO BEGINNING CONSTRUCTION, THE CONTRACTOR SHALL EXCAVATE THE EXISTING 8" PIPE STUB AT SANITARY SEWER STATION 0+00.0 TO VERIFY ITS HORIZONTAL AND VERTICAL LOCATION. THE PIPE LOCATION SHALL BE REPORTED TO THE ENGINEER SO THAT ANY NECESSARY PLAN MODIFICATIONS CAN BE MADE. ANY ADDITIONAL LABOR OR MATERIALS NECESSARY TO COMPLETE THE CONNECTION SHALL BE CONSIDERED SUBSIDIARY TO THE PROJECT.

MICHAEL D. KEY
13944
6/15/05
KANSAS
PROFESSIONAL ENGINEER

SANITARY SEWER LINE NO. 1A

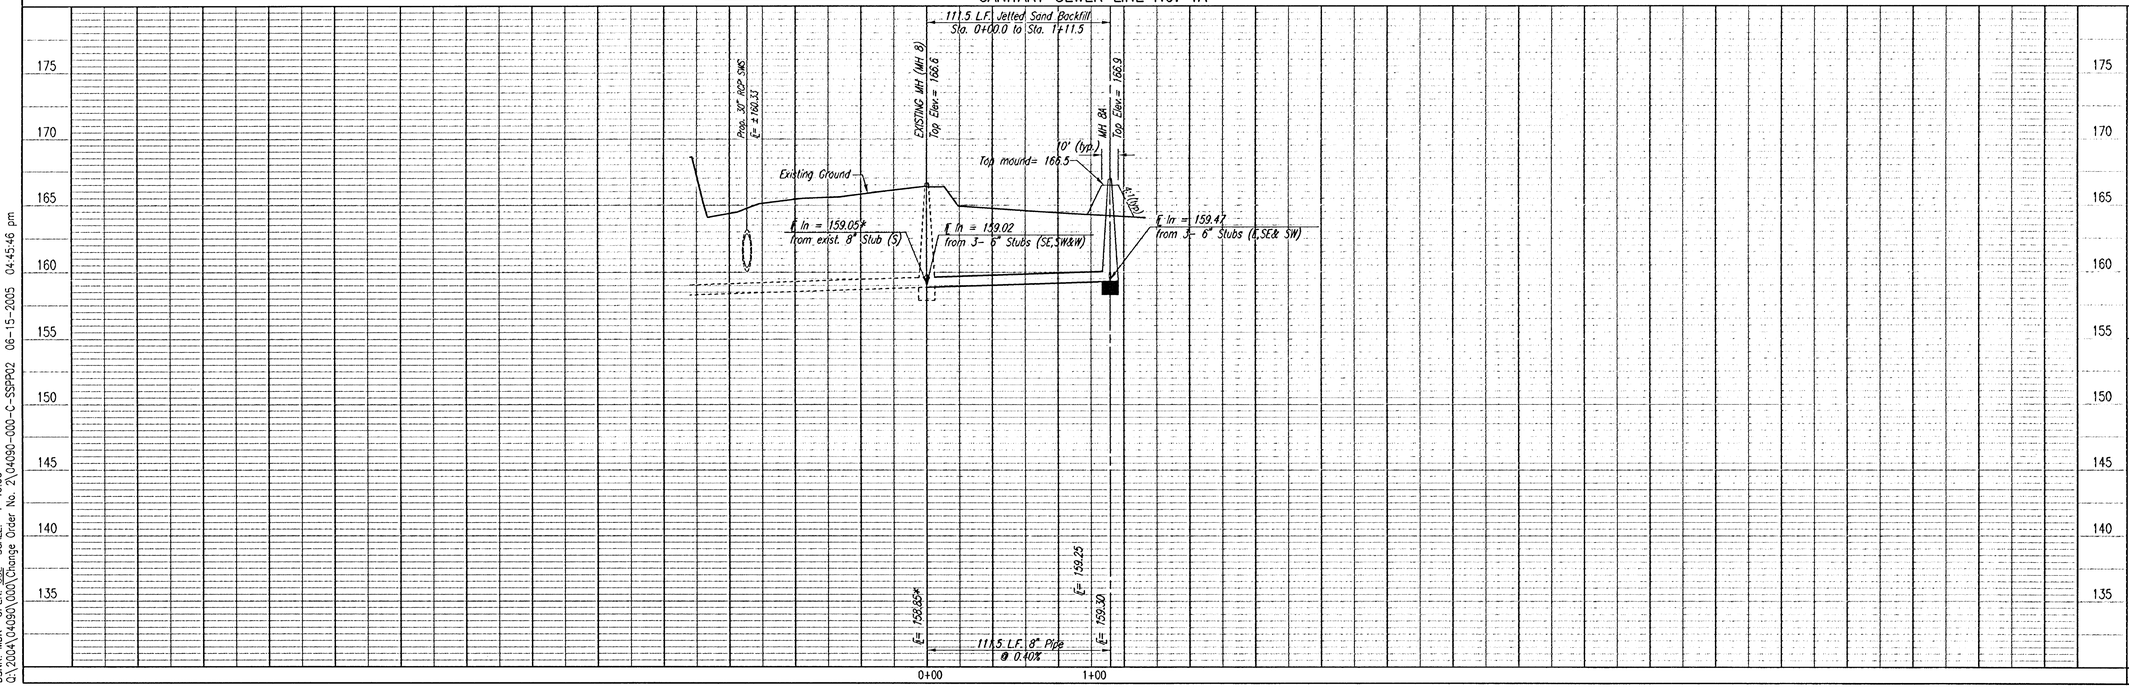

No.	Revision	By	Date
1	CHANGE ORDER #2- ADD LINE NO. 1A	MDK	06/15/05

LATERAL 1, MAIN 6 OF THE
NORTHWEST INTERCEPTOR SEWER
SANITARY SEWER LINE NO. 1A
JAMES L. ARMOUR, P.E.- CITY ENGINEER
CITY OF WICHITA PROJECT NO. 468-83969

Professional Engineering Consultants, P.A.
303 S. TOPEKA • WICHITA, KANSAS 67202
316-262-2691 • FAX 316-262-5063

Designed By	MDK	Job No.	35-04090-5054
Drawn By	JGA	Date	January 2005

Sheet 7A of 18

PLAN: CHECKED / CHECKED — BY / DATE

PROFILE: CHECKED / CHECKED — BY / DATE

DSNR: MDK OPER: CSL SCALE: 1=40.00
Q:\2004\04090\000\Change Order No. 2\04090-000-C-SSPP02 06-15-2005 04:45:46 pm