
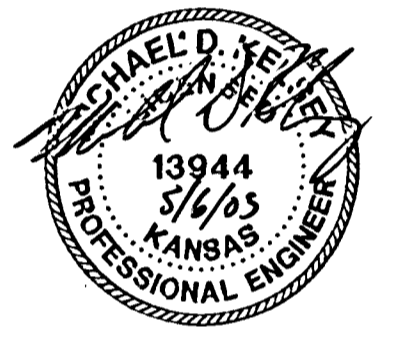


DATE	
BY	
CHECKED	
PLAN	

DATE	
BY	
CHECKED	
PROFILE	

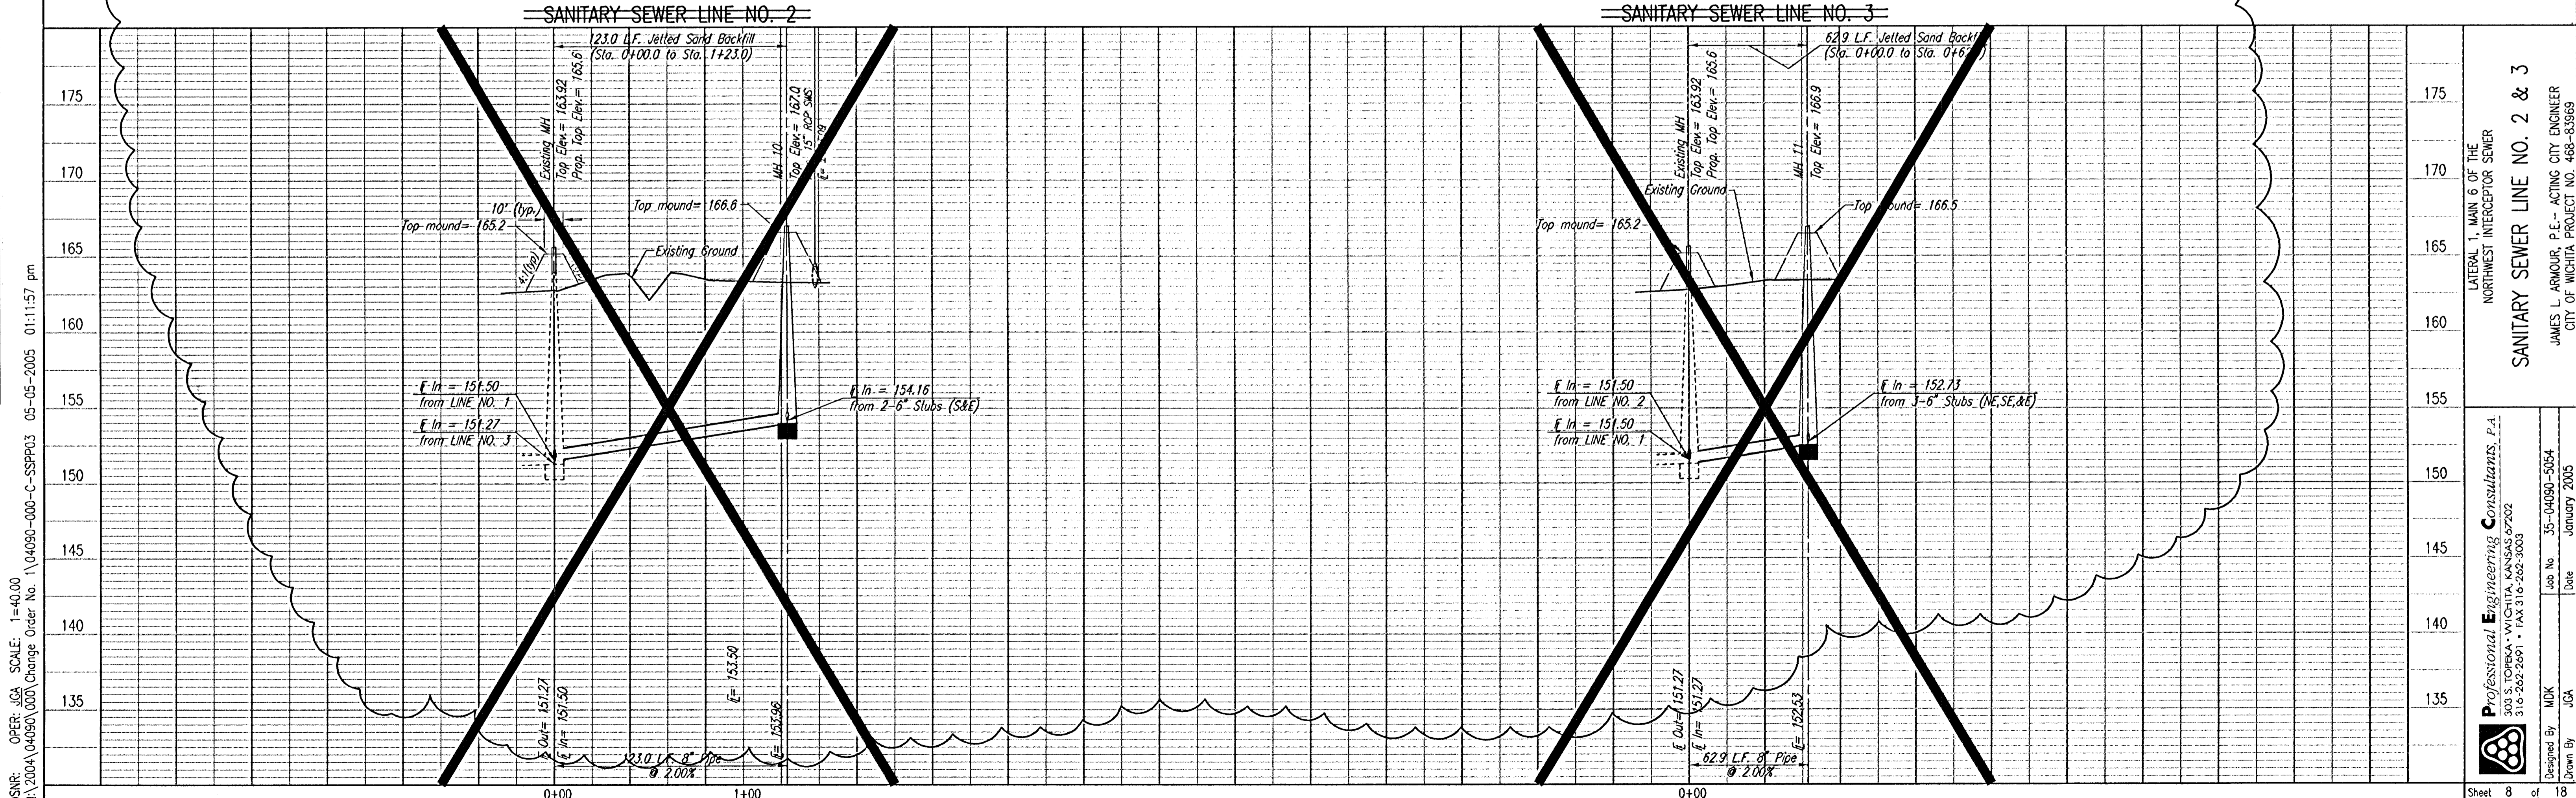

LATERAL 1, MAIN 6 OF THE
 NORTHWEST INTERCEPTOR SEWER
SANITARY SEWER LINE NO. 2 & 3
 JAMES L. ARMOUR, P.E. - ACTING CITY ENGINEER
 CITY OF WICHITA PROJECT NO. 468-83669

Professional Engineering Consultants, P.A.
 303 S. TOPSICA • WICHITA, KANSAS 67202
 316-262-2691 • FAX 316-262-3003

Designed By: MDK
 Drawn By: JCA
 Job No. 35-04090-5054
 Date: January 2005

DSNR: OPER. JCA SCALE: 1=40.00
 C:\2004\04090\001\Change Order No. 1\04090-000-C-SSPP03 05-05-2005 01:11:57 pm