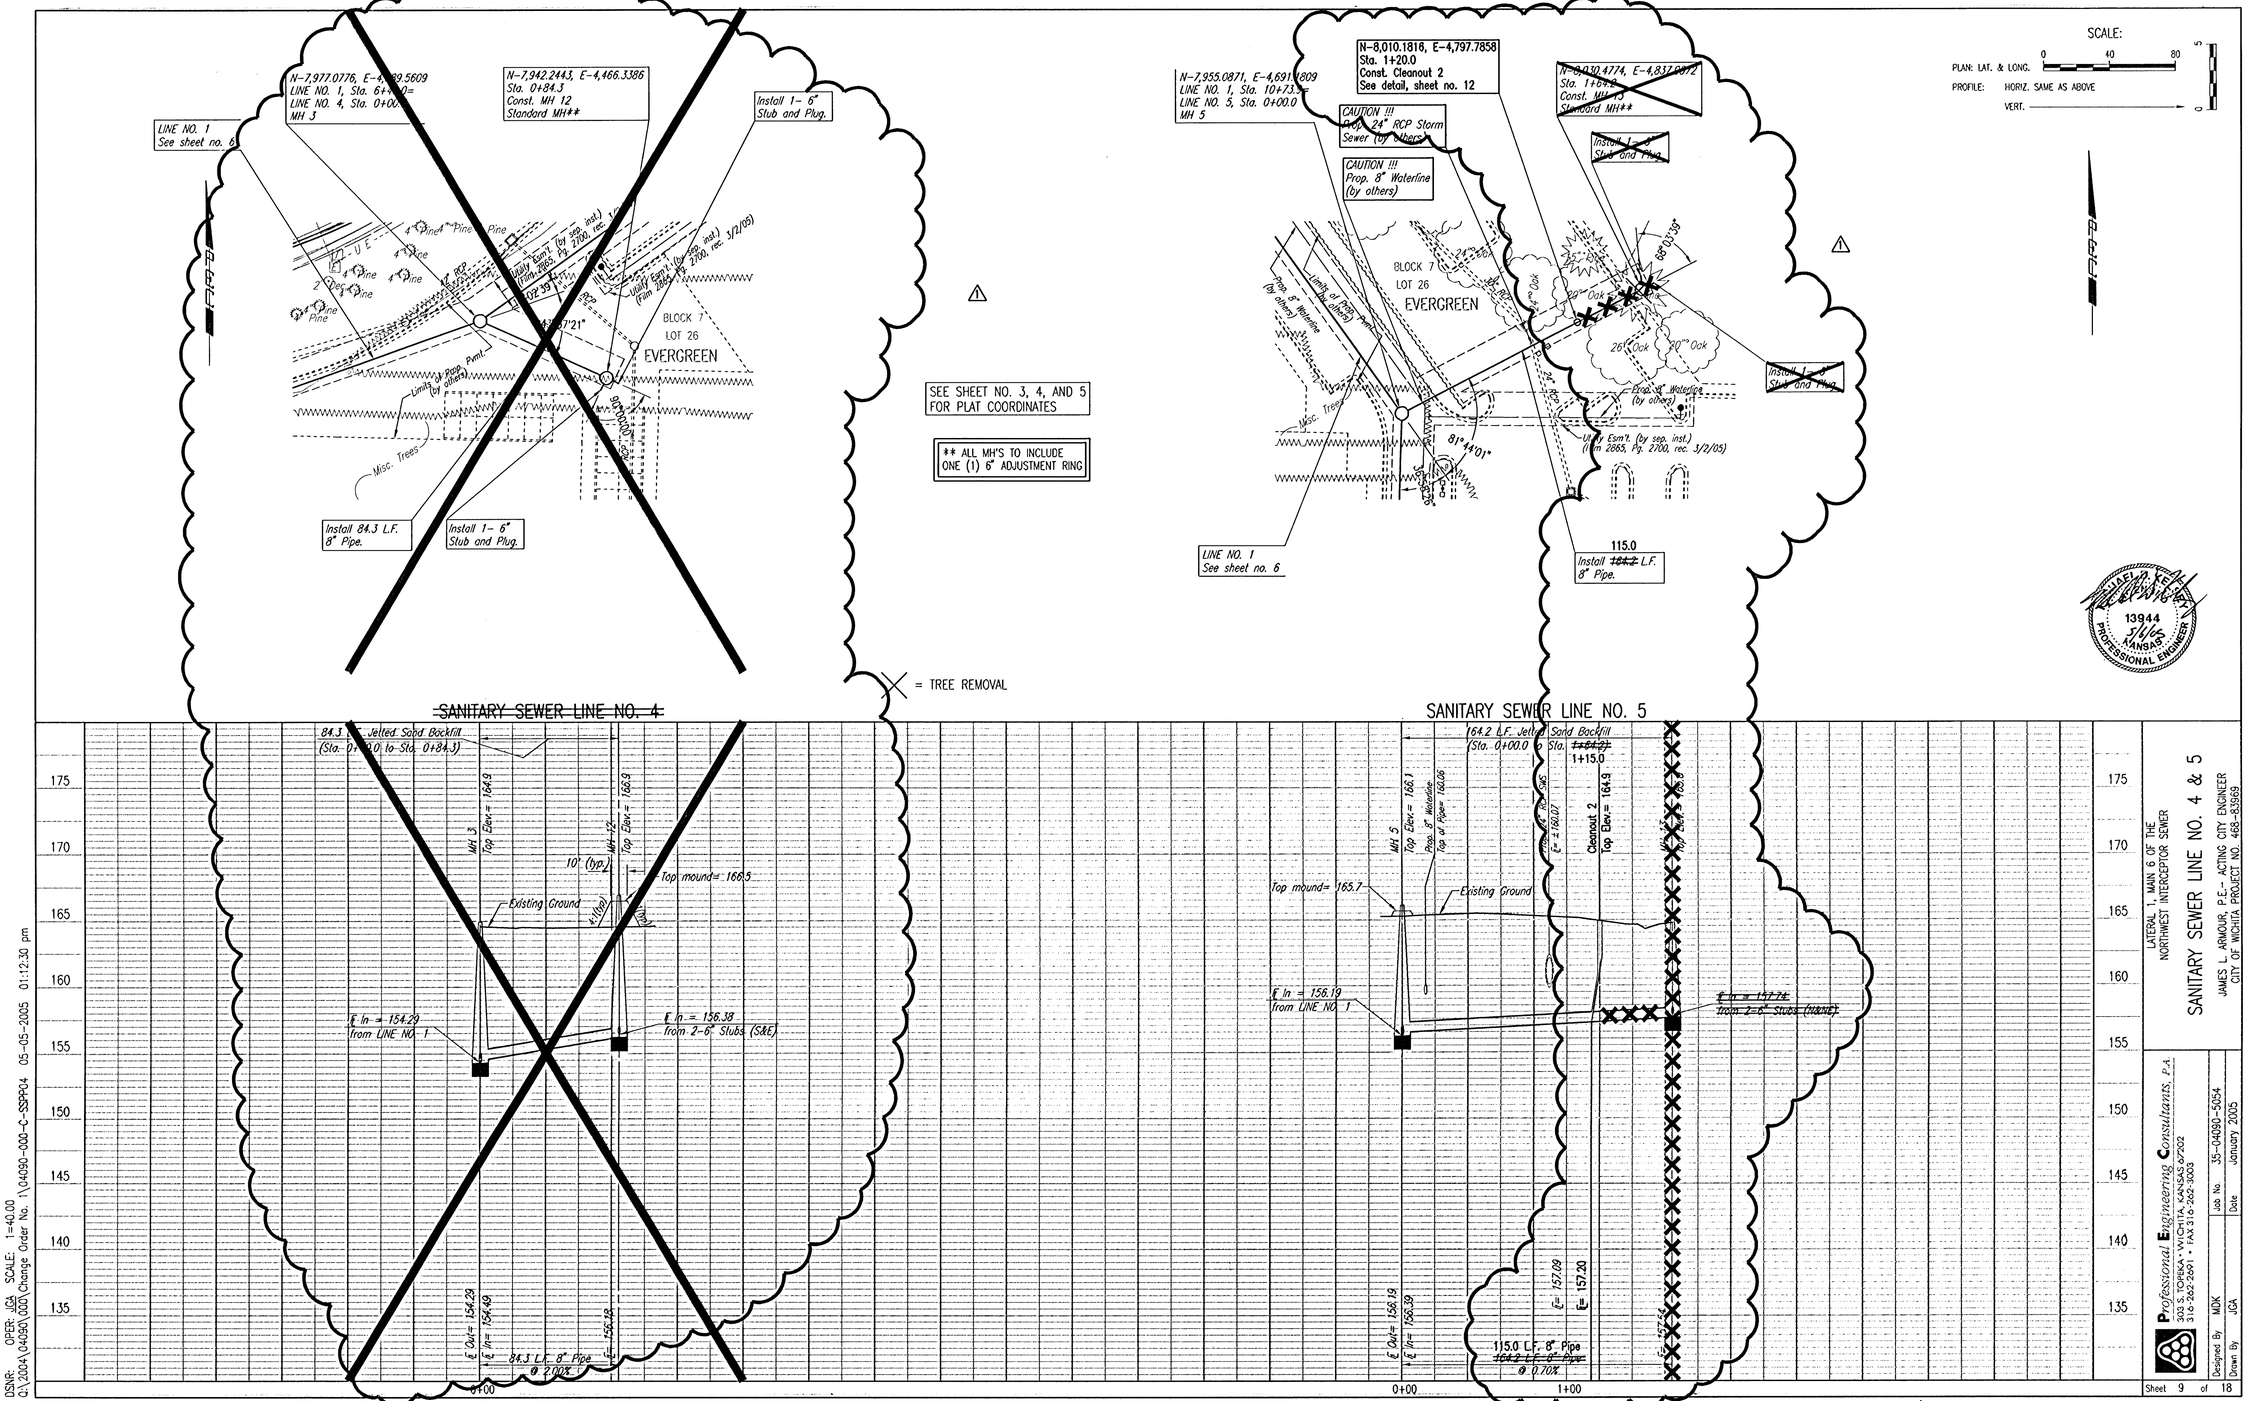

⚠ CHANGE ORDER NO. 1 5-02-05