


BENCHMARK:

City Disc In T.C. Adj. to F.H.
17.5' North of Monterey. At the
South West Corner of Lot 10
Block C Auburn Hills 15th
Addition.
Elev. = 177.39 (City Datum)


City Disc In T.C. Adj. to F.H.
27' North of Monterey. At the
Intersection of Monterey and
Auburn Hills.
Elev. = 179.40 (City Datum)



Scale: 1" = 40' Horizontal
1" = 5' Vertical
• = Iron

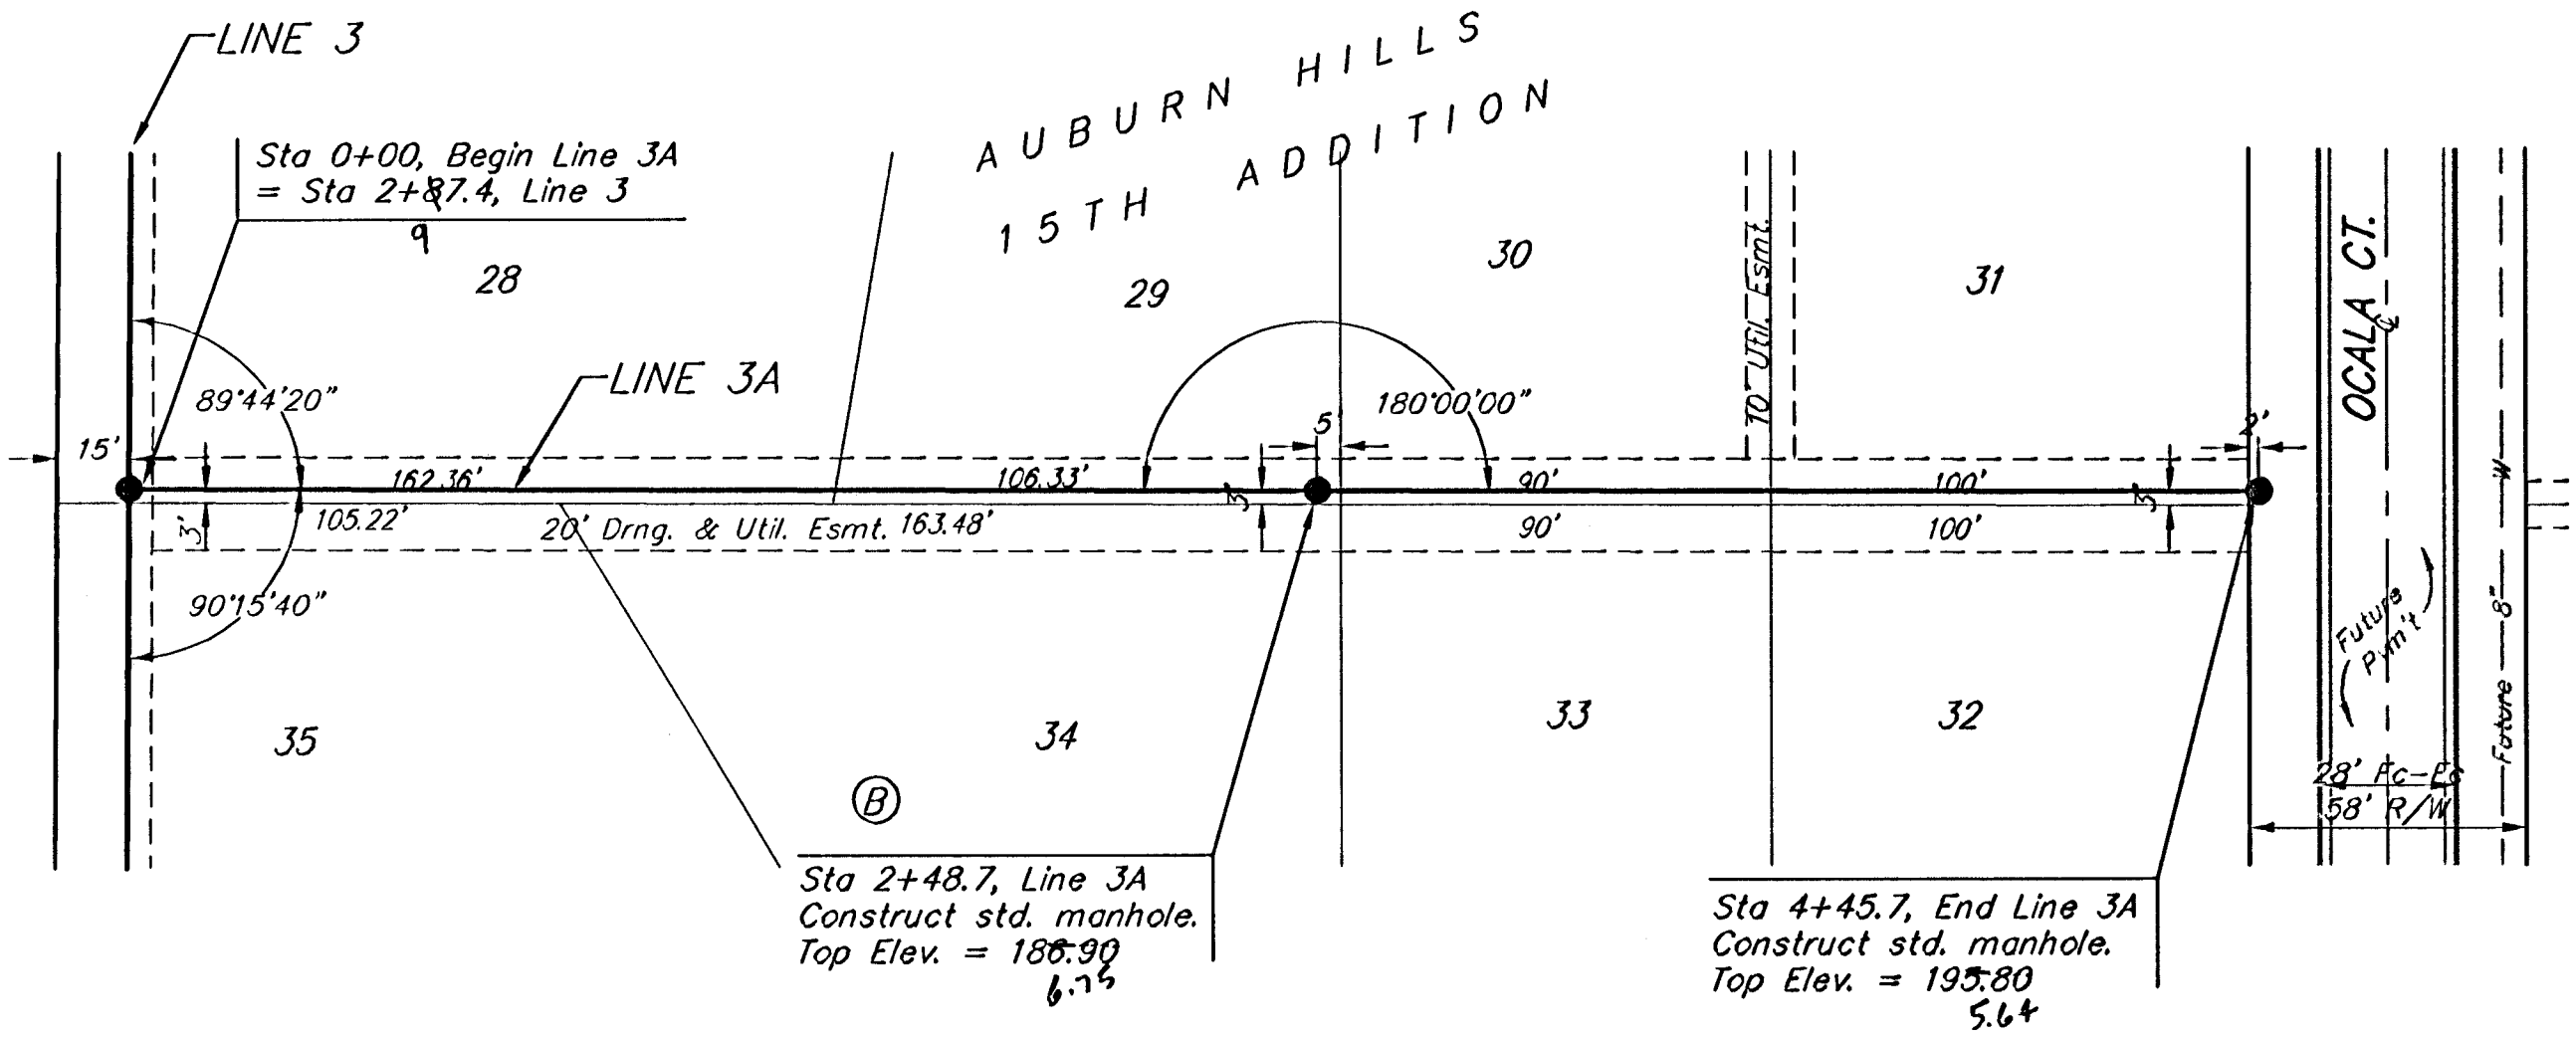

Remove trees only as necessary
for sanitary sewer construction
and only with permission of
Developer or Baughman Co.
Cost of removal to be incidental
to lump sum bid item "Site
Clearing & Restoration".

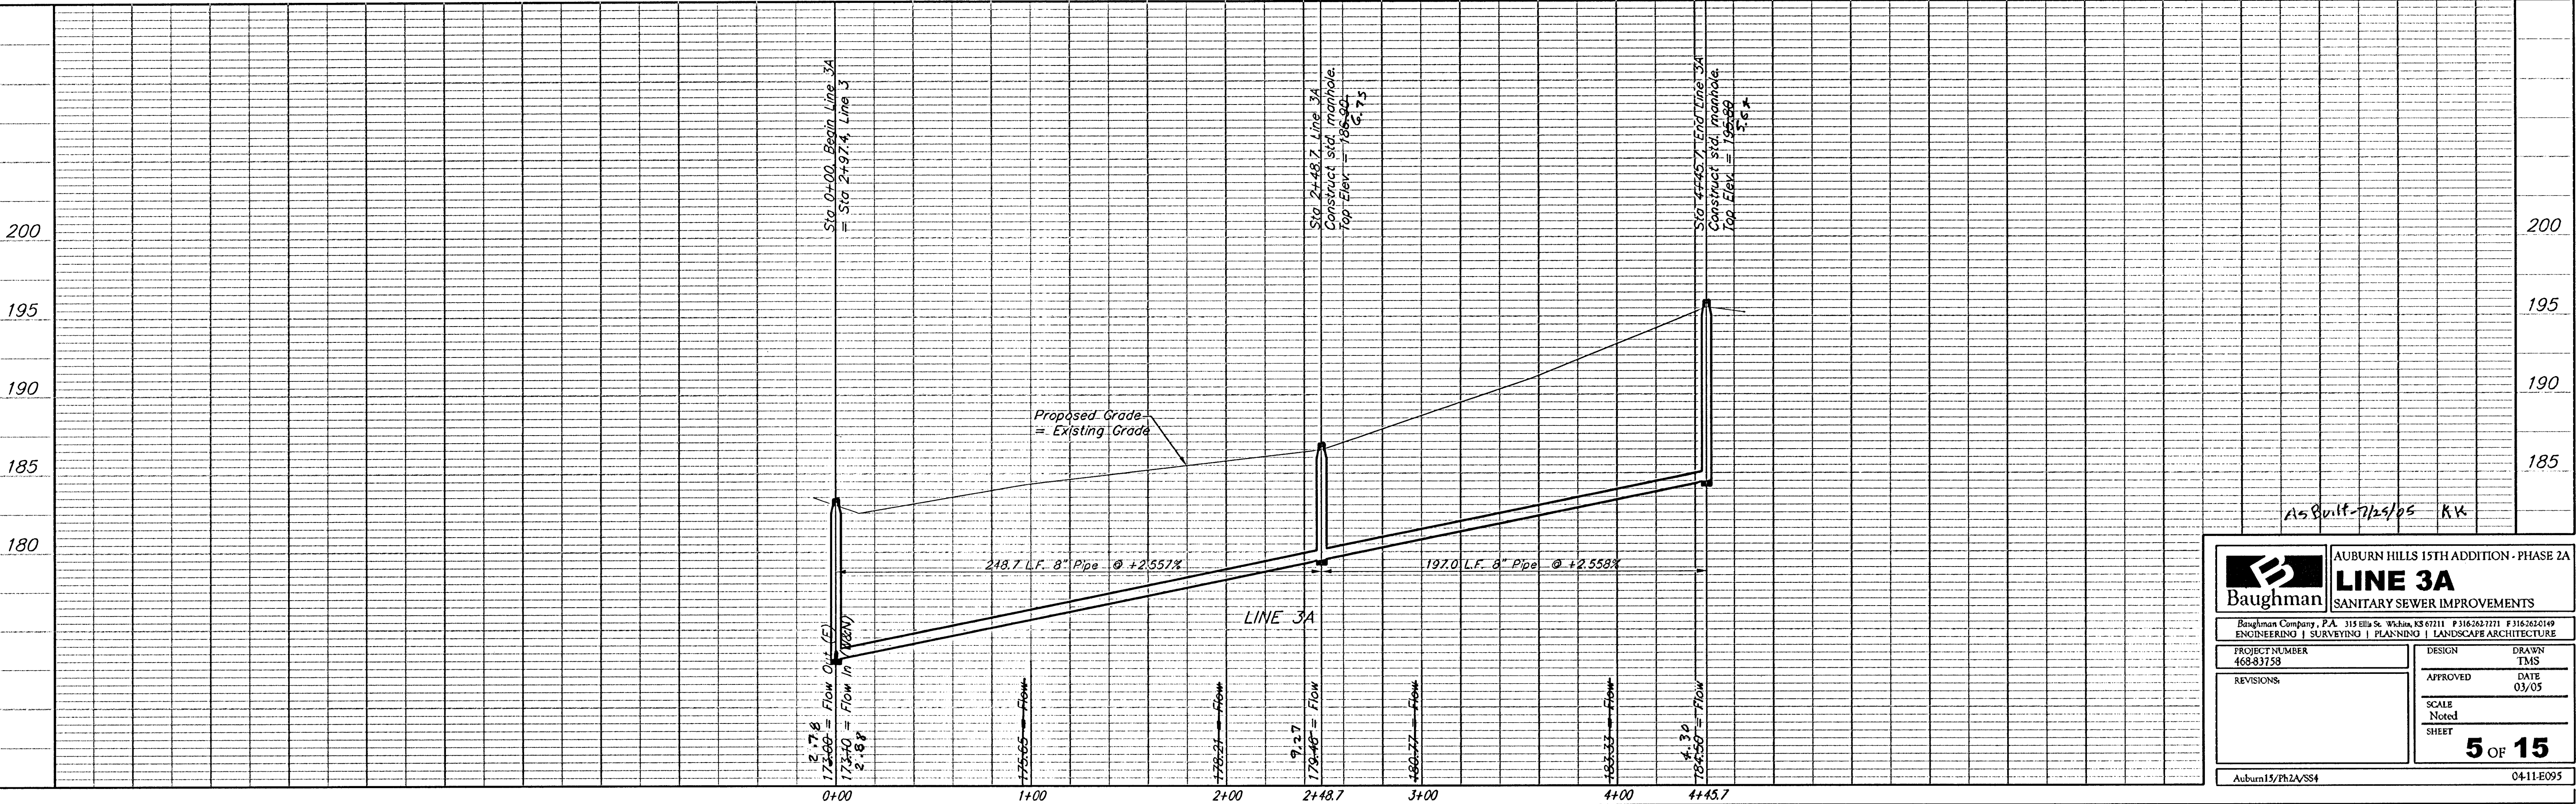

Baughman		AUBURN HILLS 15TH ADDITION - PHASE 2A	
LINE 3A		SANITARY SEWER IMPROVEMENTS	
ENGINEERING SURVEYING PLANNING LANDSCAPE ARCHITECTURE			
PROJECT NUMBER 468-83758		DESIGN DRAWN TMS	
REVISIONS:		APPROVED DATE 03/05	
		SCALE Noted	
		SHEET 5 OF 15	
Auburn15/Ph2A/SS4		0411-E095	