


LINE NO. 1

SANITARY SEWER RISER SUMMARY										
No.	Line	Sta./Dir.	Lot No.	Block No.	Saddle Size	8" Main FL	Approx. Length 4" Pipe		Coordinates at End of 4" Pipe	
							Vert.	Horiz.	Northing	Eastng
1	1	7+10 Rt.	21		8" x 4"	1384.63	12'	66'	10322.23	18014.31
2	1	9+90 Rt.	23		8" x 4"	1385.86	13'	39'	10445.53	18271.48
3	1	11+00 Rt.	24		8" x 4"	1386.30	13'	28'	10511.82	18359.41

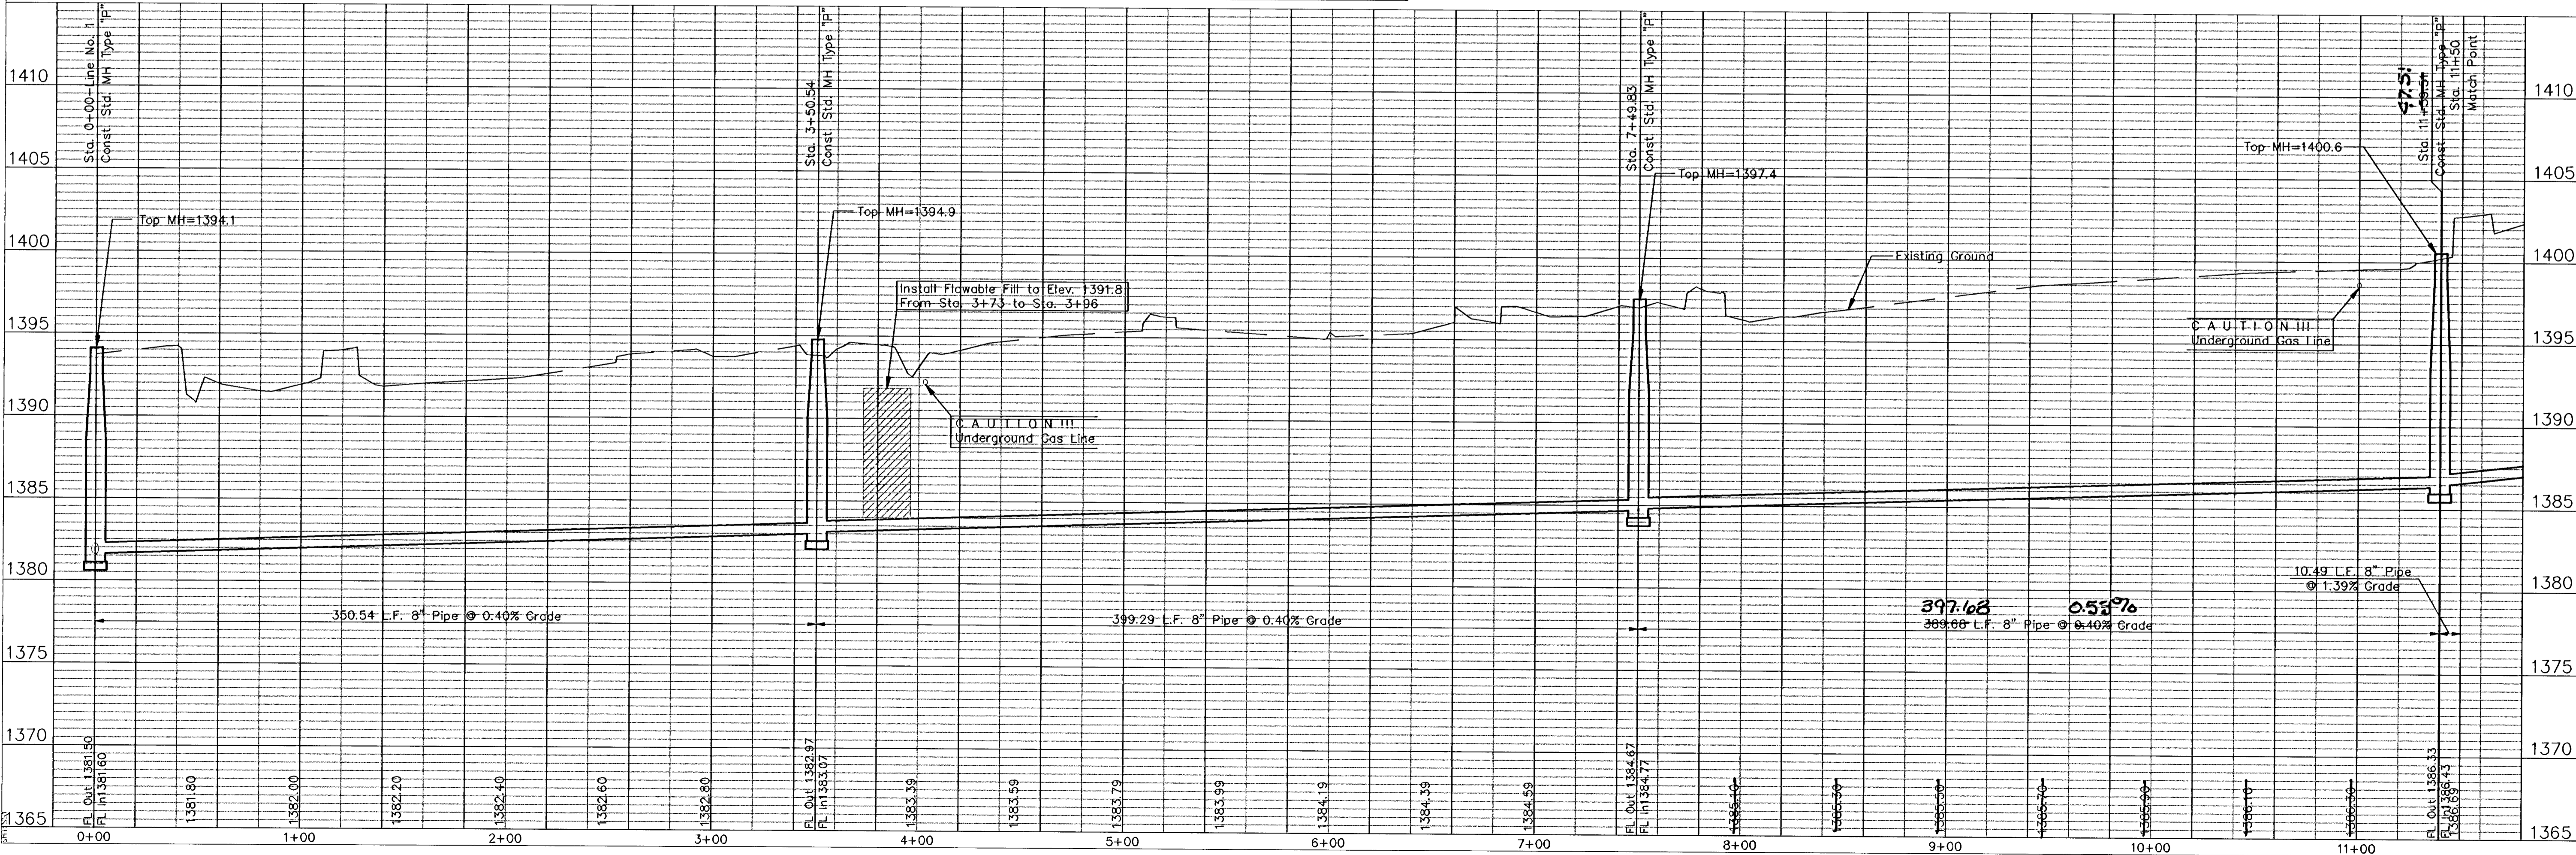

SAN- AIR ADDITION
SEWER LINE NO. 1

CITY OF WICHITA, KANSAS
JAMES ARMOUR, P.E. - CITY ENGINEER
Proj.# 468-53922 O.C.A.# 744073

POE & ASSOCIATES, INC.
CONSULTING ENGINEERS
5940 E. Central, Suite 200 • Wichita, KS 67208-4242
Phone 316/685-4114 • FAX 316/665-4444

FINAL

Designed By: T. Austin
Drawn By: S. Schmitt
Poe Job No.: 02153-03
Date: December, 2004

Sheet
2 of 14

021 02153-03 Base-ss.dwg Tue Jan 04 08:03:39 2005 Steve Schmitt-Poe & Associates of Kansas, Inc.