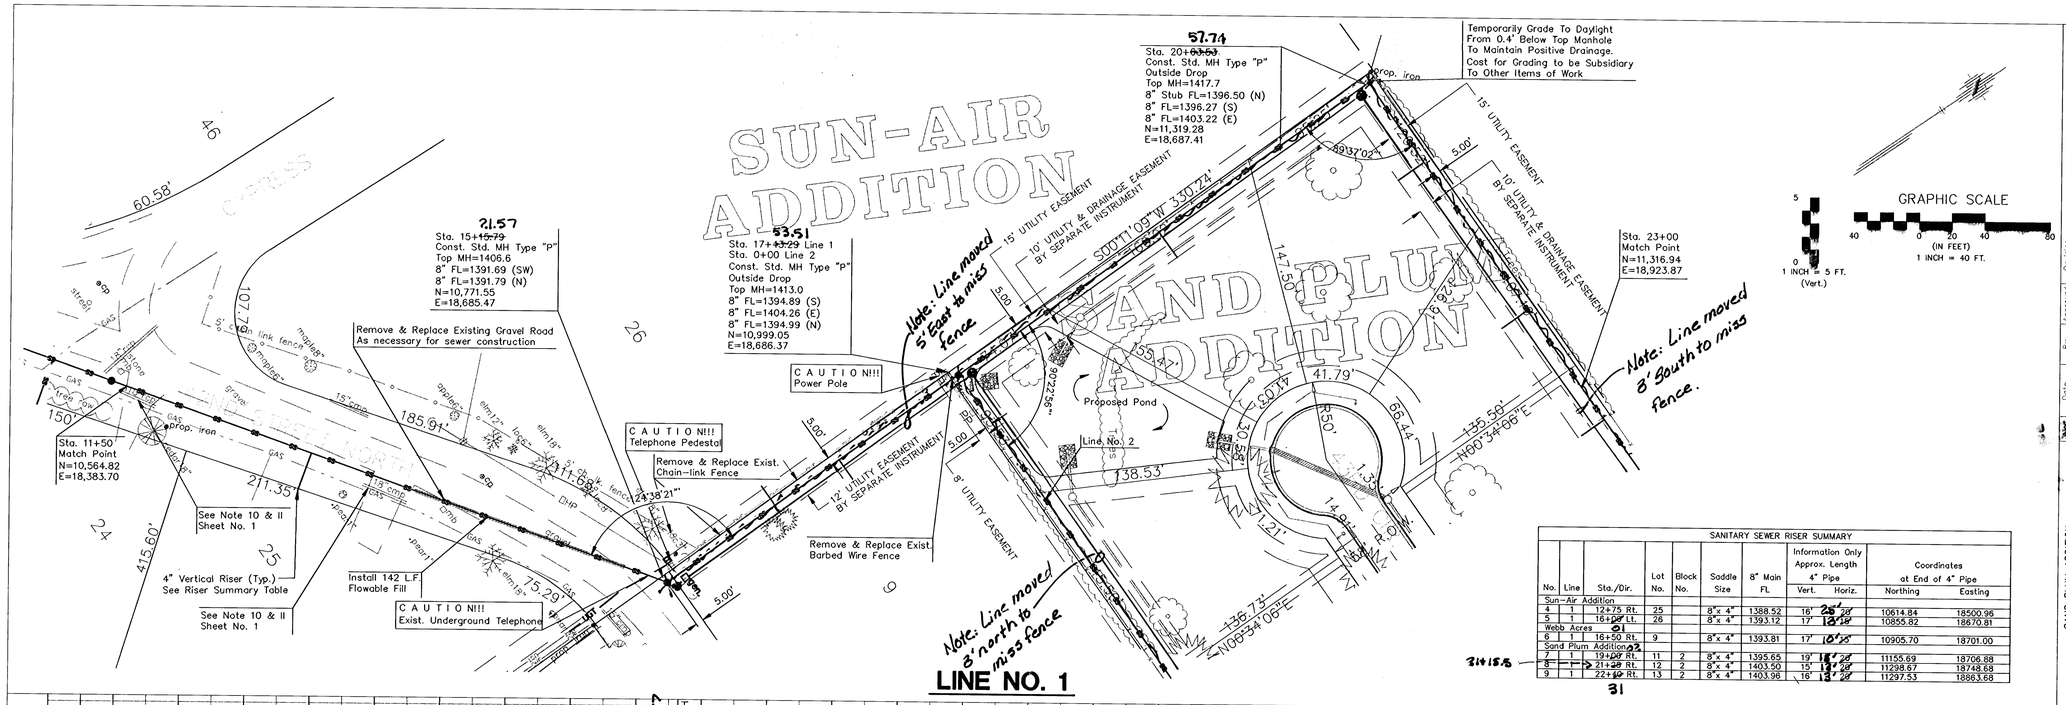

LINE NO. 1

SANITARY SEWER RISER SUMMARY

No.	Line	Sta./Dir.	Lot No.	Block No.	Saddle Size	8" Main FL	Information Only Approx. Length 4" Pipe Vert.	Horiz.	Coordinates at End of 4" Pipe Northing	Easting
Sun-Air Addition										
4	1	12+75 Rt.	25		8"x 4"	1388.52	16' 25'	28'	10614.84	18500.96
5	1	16+~~07~~ Lt.	26		8"x 4"	1393.12	17' 18'	28'	10855.82	18670.81
Webb Acres										
6	1	18+50 Rt.	9		8"x 4"	1393.81	17' 10'	28'	10905.70	18701.00
Sand Plum Addition										
7	1	19+~~28~~ Rt.	11	2	8"x 4"	1395.65	19' 18'	28'	11155.69	18706.88
8	1	21+~~28~~ Rt.	12	2	8"x 4"	1403.50	15' 12'	28'	11298.67	18748.68
9	1	22+~~10~~ Rt.	13	2	8"x 4"	1403.96	16' 13'	28'	11297.53	18863.68

31

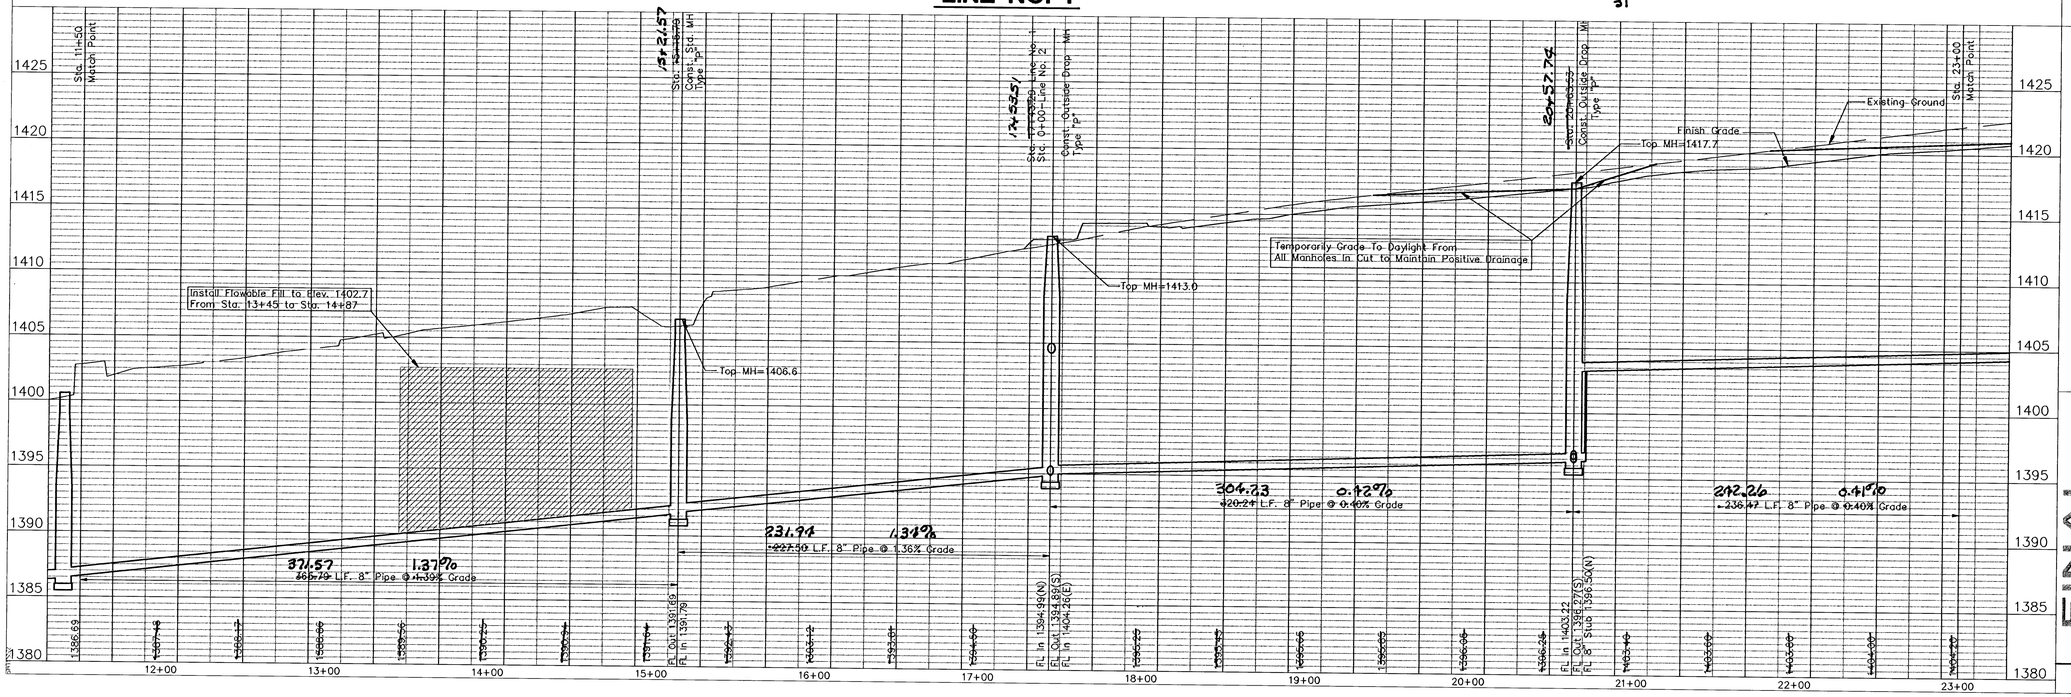

SAND PLUM ADDITION
SANITARY SEWER IMPROVEMENTS
SEWER LINE NO. 1

CITY OF WICHITA, KANSAS

JAMES ARMOUR, P.E. - CITY ENGINEER
Proj# 468-83822 O.C.A.# 744073

POE & ASSOCIATES, INC.
CONSULTING ENGINEERS
3840 E. Central, Suite 200 ■ Wichita, KS 67208-4242
Phone 316/685-4114 ■ FAX 316/685-4444

FINAL

Designed By: T. Austin
Drawn By: S. Schmidt
Poe Job No.: 02153-03
Date: December 2004

Sheet 3 of 14

Mark	Date	By	Approved	Revision

021\02153\02153-03\base-ss.dwg Tue Jan 04 08:03:42 2005 Steve Schmidt-Poe & Associates of Kansas, Inc.