FOX RIDGE ADDITION - PHASE 10
SANITARY SEWER PLANS
PROJ. NO. 468-84021

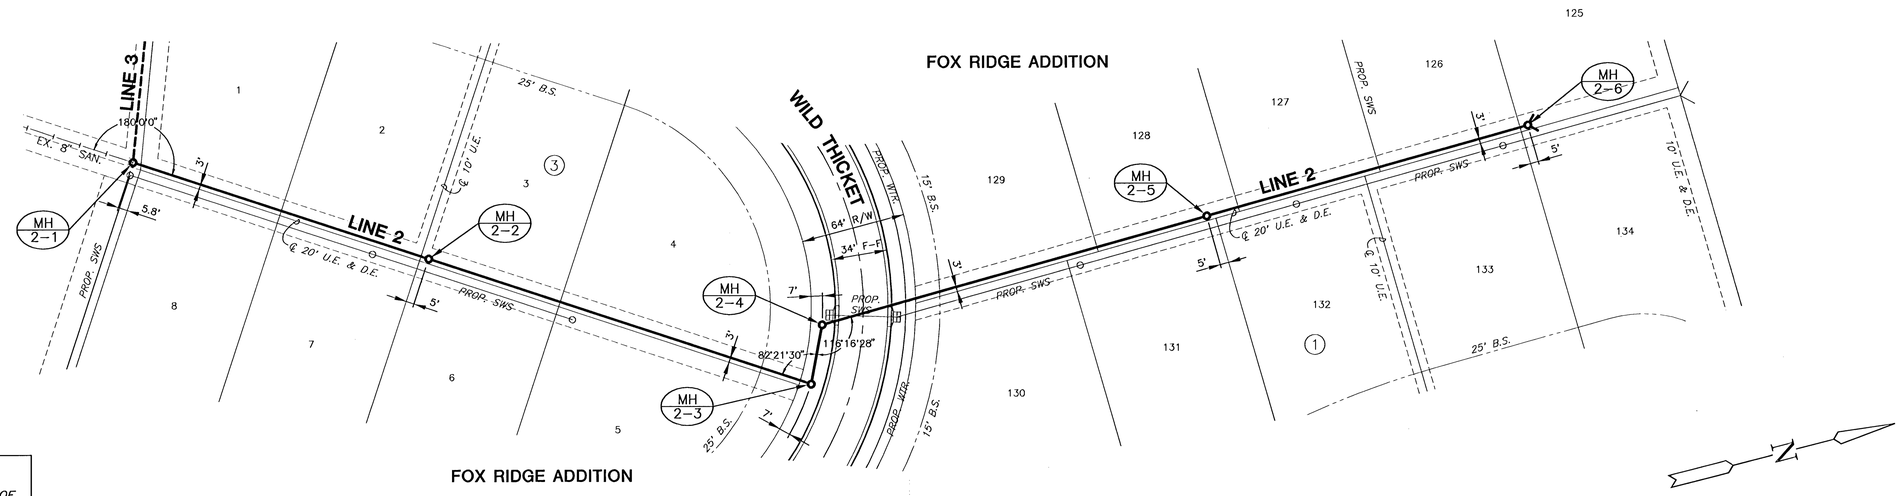

NOTE:
CONTRACTOR TO VERIFY LOCATION AND ELEVATION OF EXIST. 8" SANITARY SEWER LINE PRIOR TO CONSTRUCTION.

FLOWABLE FILL

SCALE: 1" = 40'
0 20 40 80

PLAN LINE 2

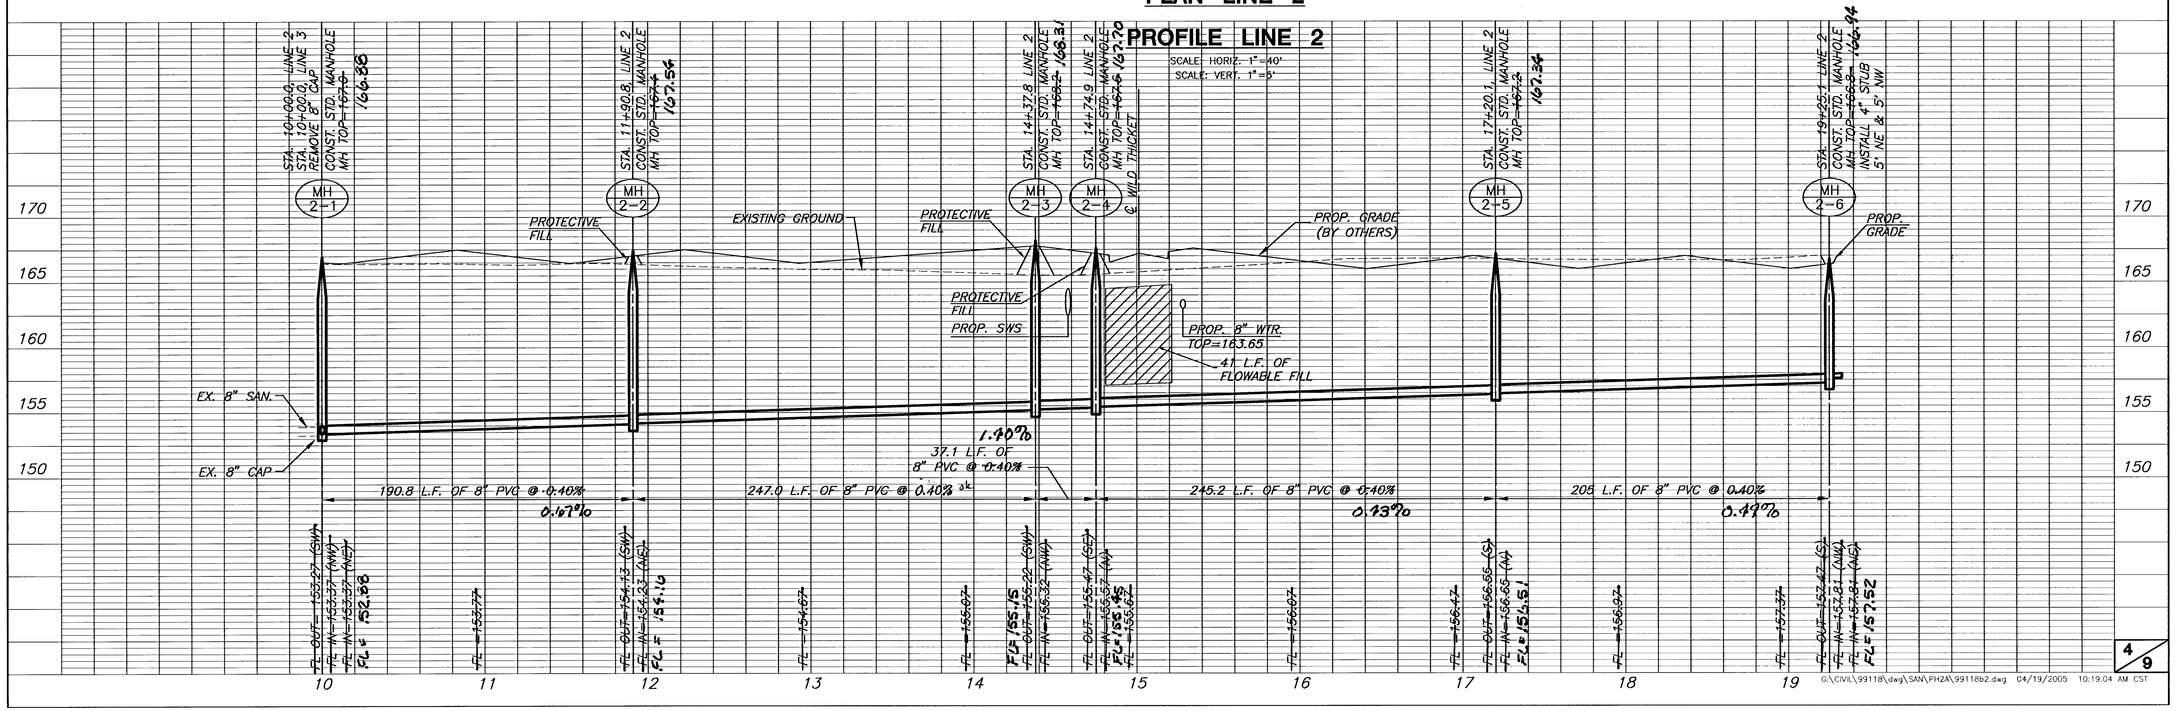

G:\CIVIL\99118\dwg\SAN\PH2A\99118b2.dwg 04/19/2005 10:19:04 AM CST