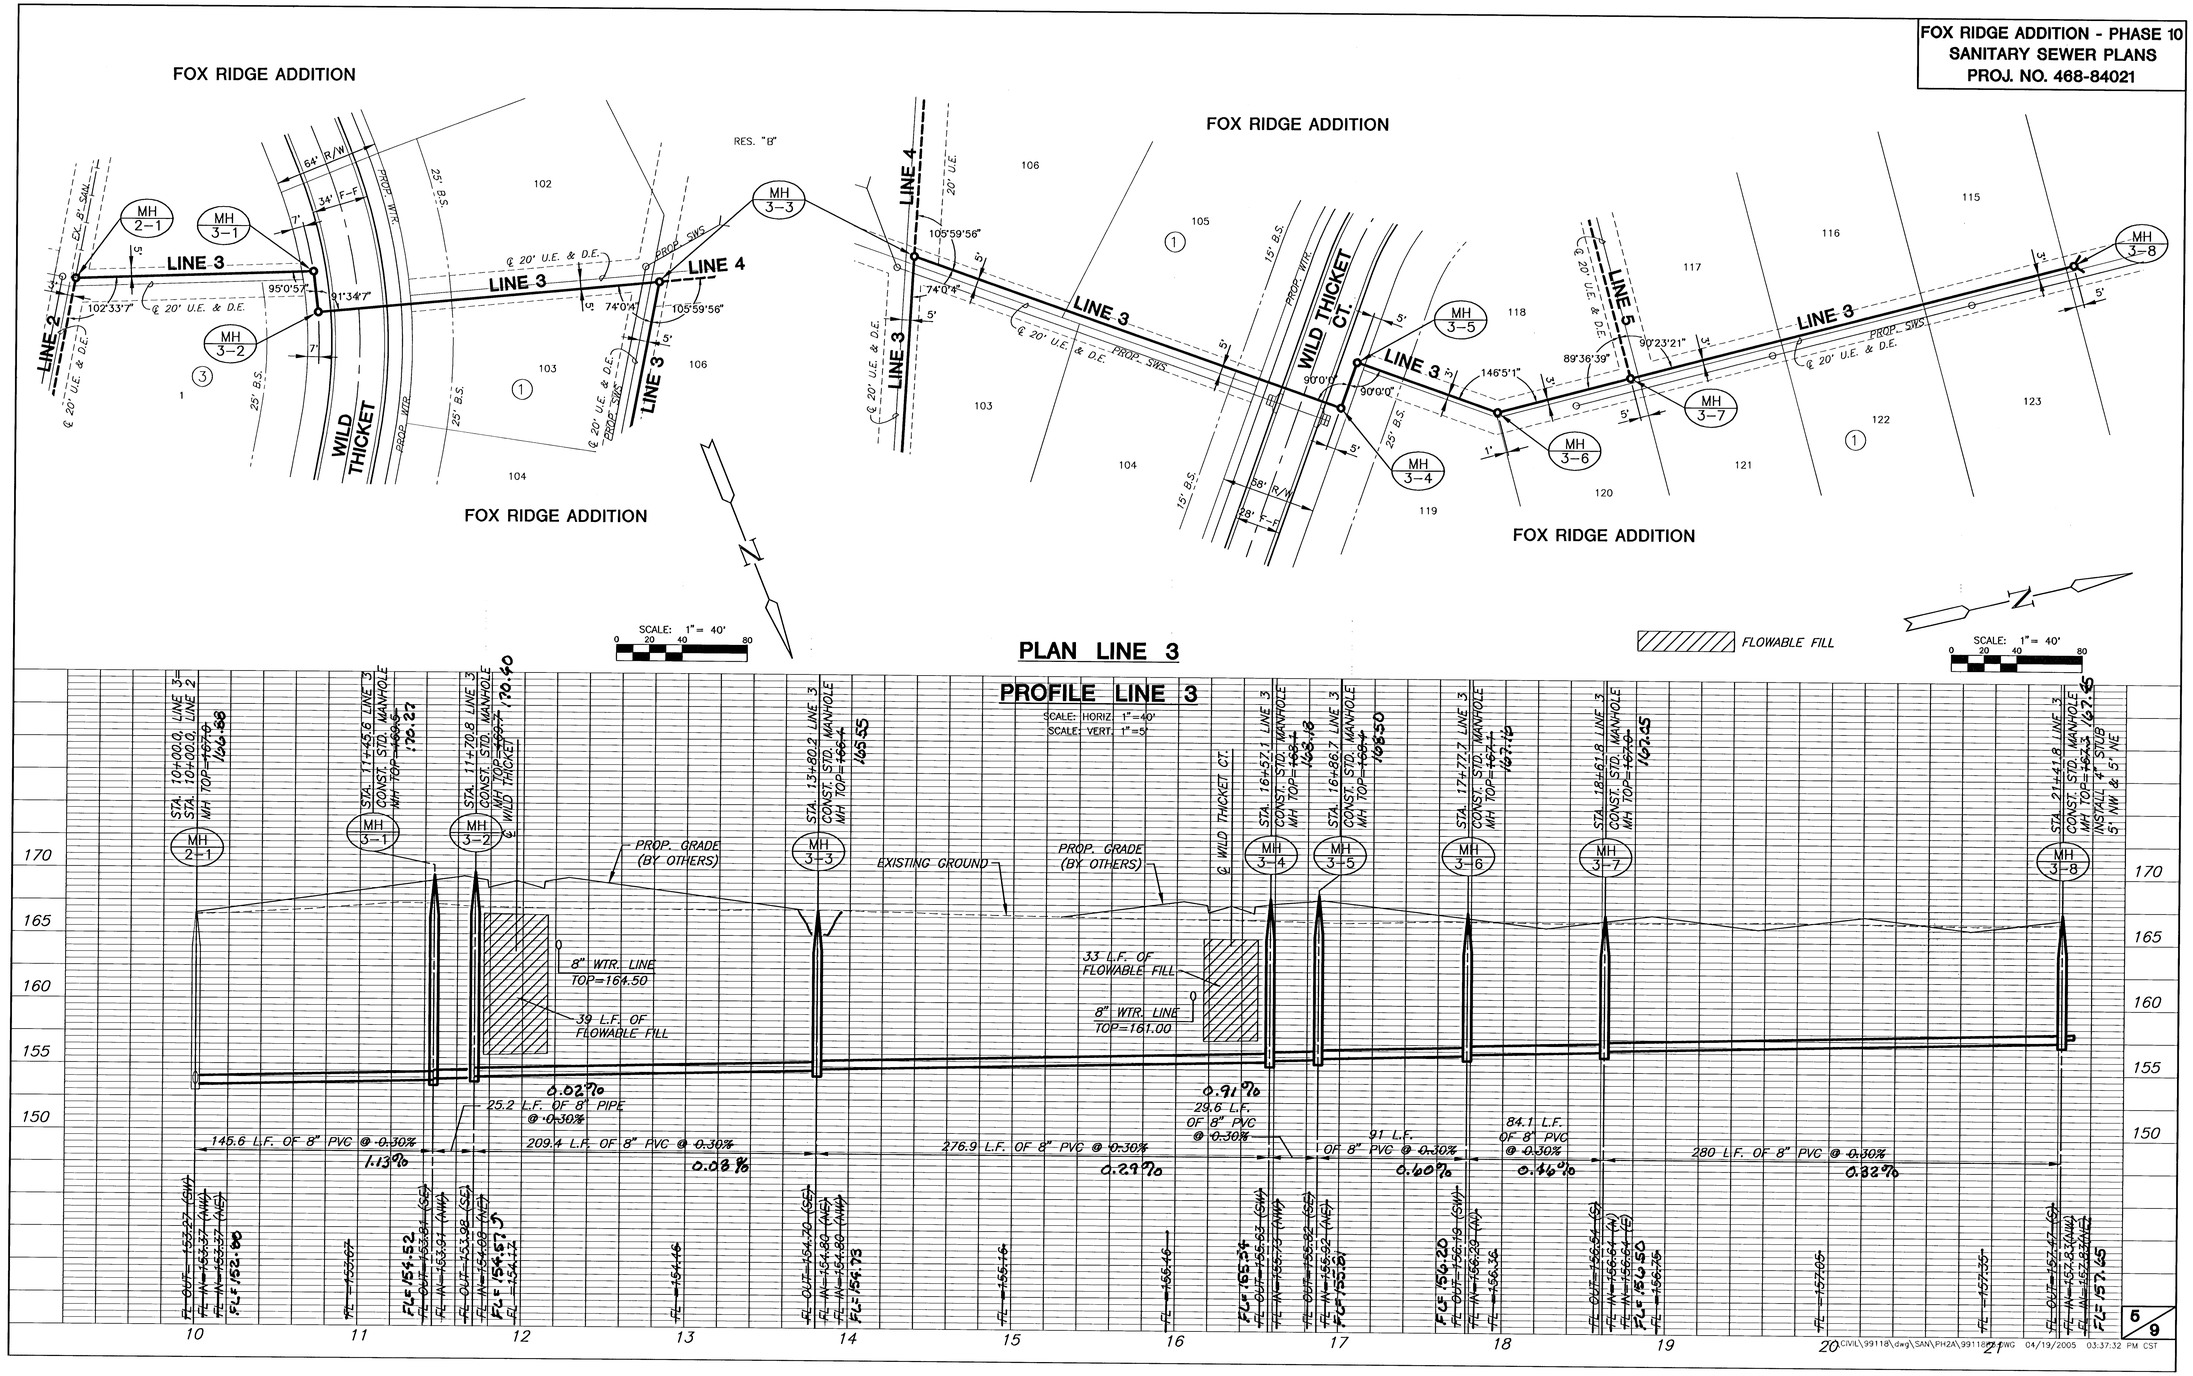FOX RIDGE ADDITION - PHASE 10
SANITARY SEWER PLANS
PROJ. NO. 468-84021