


BENCHMARK:
 R.R. SPIKE IN 1/4P, 150' E. & 30'
 S. OF THE S.W. COR., S.E. 1/4,
 SEC. 12-26-1W.
 ELEV. = 1338.96 M.S.L.
 ELEV. = 151.56 City Datum

"0" IN OPEN, TOP FLANGE OF
 FIRE HYDRANT AT THE S.W.
 CORNER OF 61ST. ST. N. &
 MERIDIAN AVE.
 ELEV. = 1339.16 M.S.L.
 ELEV. = 151.76 City Datum

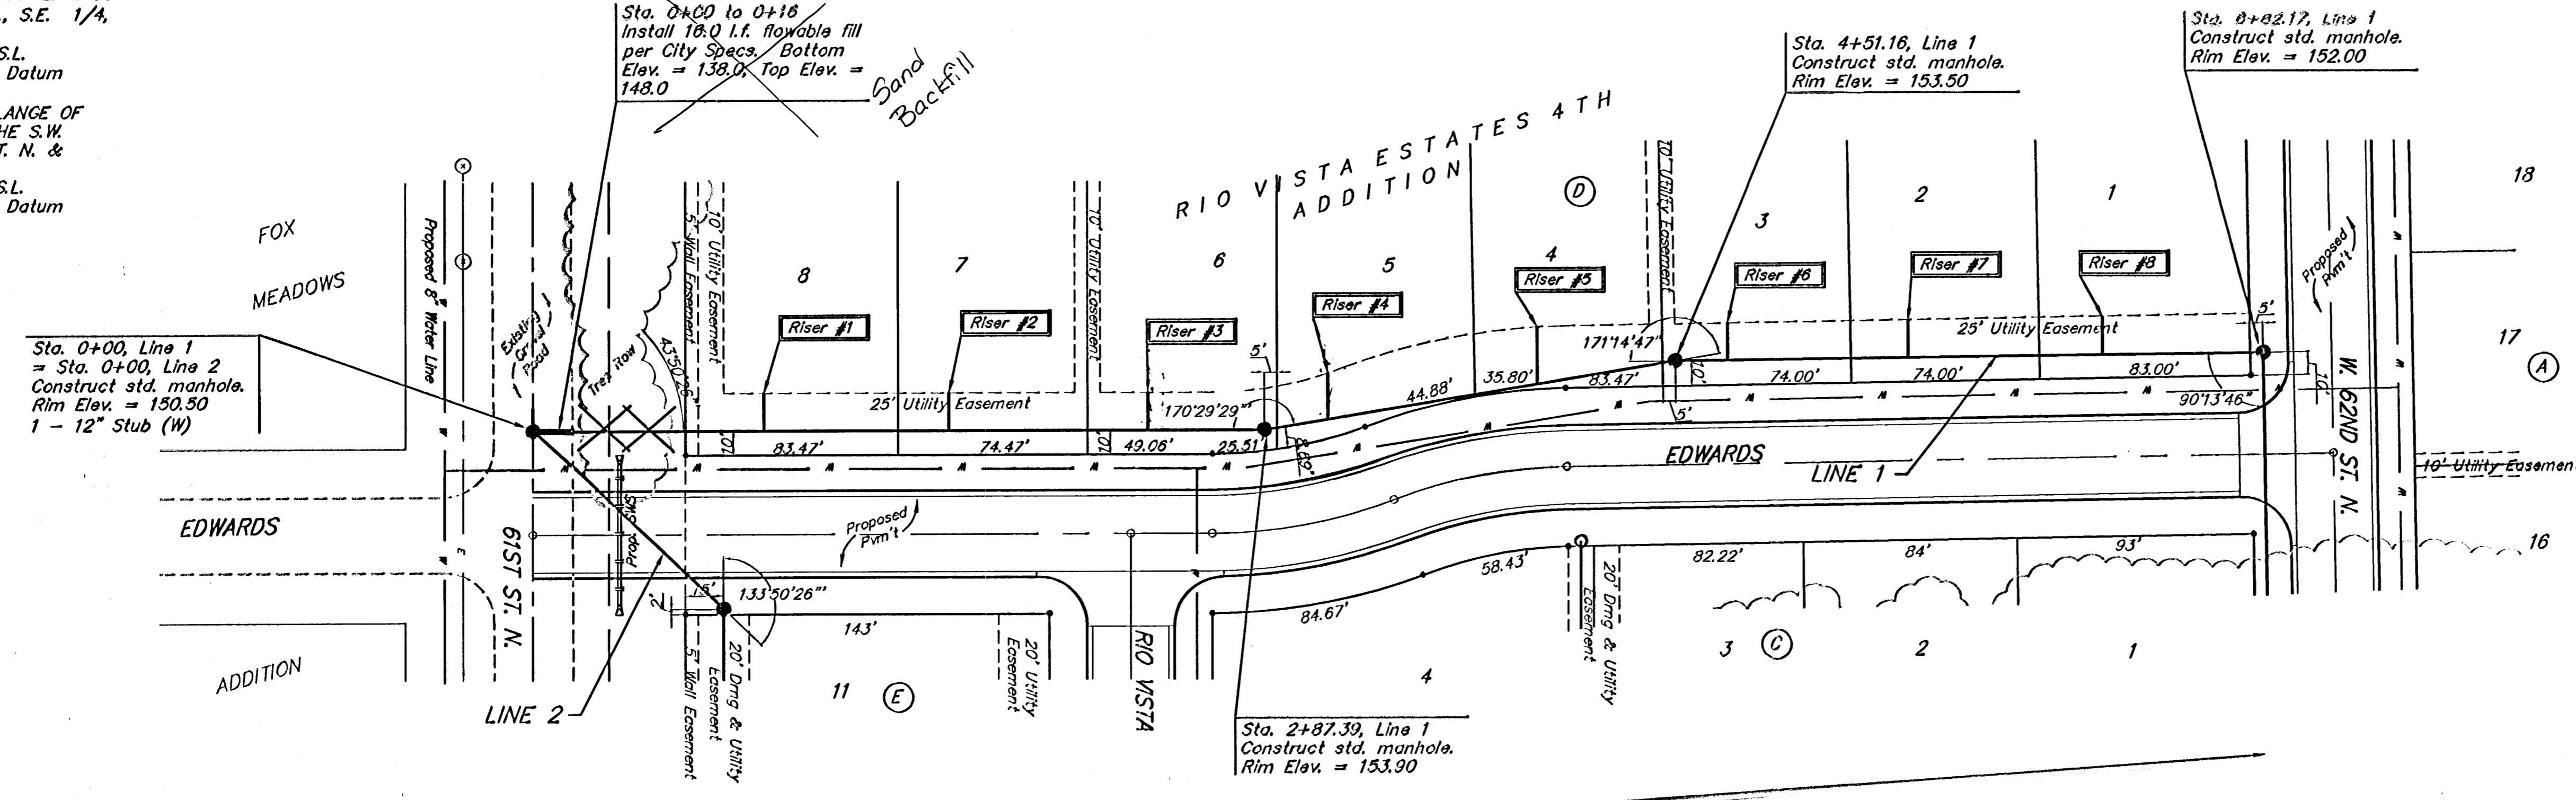


Scale: 1" = 40' Horizontal
 1" = 5' Vertical
 = Iron

Sta. 0+00 to Sta. 6+82.17, Line 1,
 Sanitary Sewer trench shall be sand
 backfilled and flushed. Cost
 incidental to cost of new sewer pipe.

Denotes Trees to be
 Removed by the
 Sanitary Sewer Contractor

SEWER SERVICE TABLE - See Sheet 6

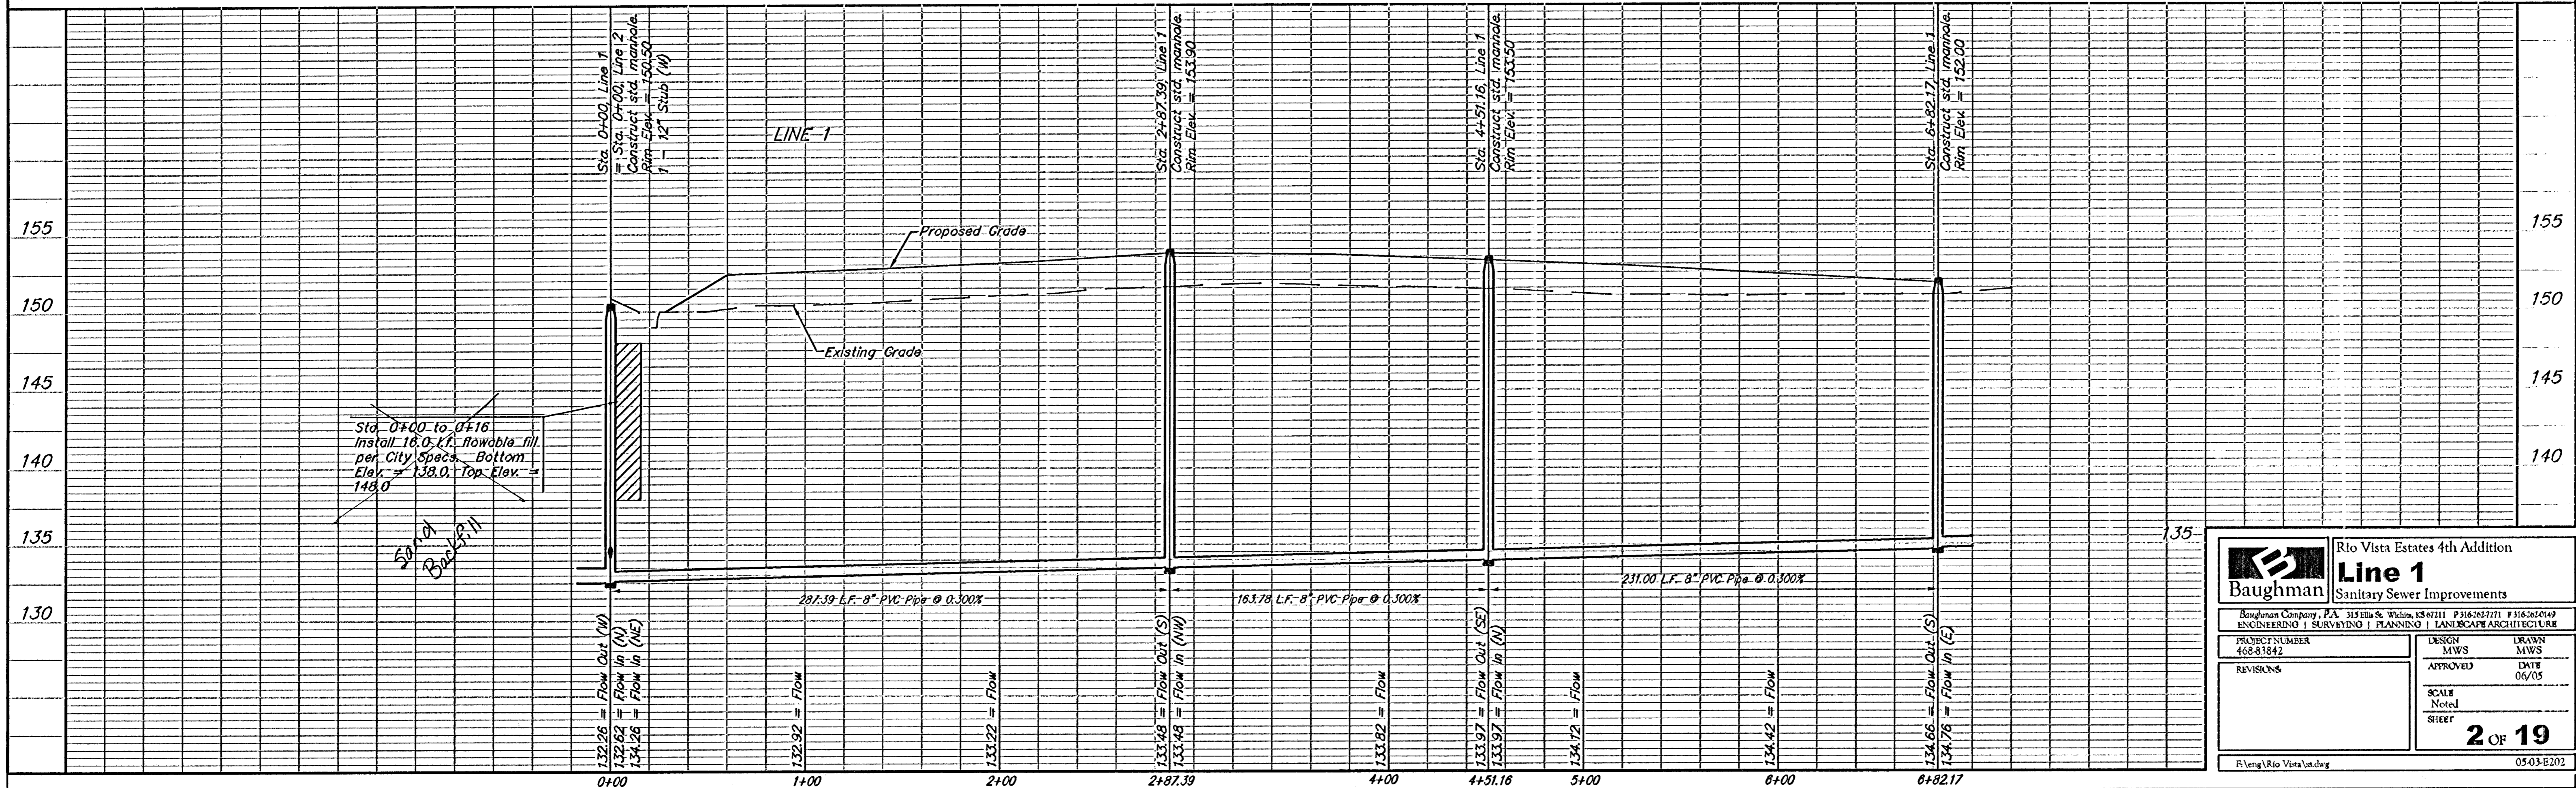

Rio Vista Estates 4th Addition Line 1 Sanitary Sewer Improvements	
Baughman Company, P.A. 315 Elm St. Wichita, KS 67211 P316-262-7771 F316-262-0149 ENGINEERING SURVEYING PLANNING LANDSCAPE ARCHITECTURE	
PROJECT NUMBER 468-83842	DESIGN MVS DRAWN MVS
REVISIONS	APPROVED DATE 06/05
SCALE Noted SHEET 2 OF 19	
Rio Vista Sanitary Sewer Improvements 05-03-B202	