BENCHMARK:
R.R. SPIKE IN HLP, 150' E. & 30' S. OF THE S.W. COR., S.E. 1/4, SEC. 12-26-1W.
ELEV. = 1338.96 M.S.L.
ELEV. = 151.56 City Datum

"O" IN OPEN, TOP FLANGE OF FIRE HYDRANT AT THE S.W. CORNER OF 61ST. ST. N. & MERIDIAN AVE.
ELEV. = 1339.16 M.S.L.
ELEV. = 151.76 City Datum

Sta. 6+82.17 to Sta. 11+20.48, Line 1, Sanitary Sewer trench shall be sand backfilled and flushed. Cost incidental to cost of new sewer pipe.

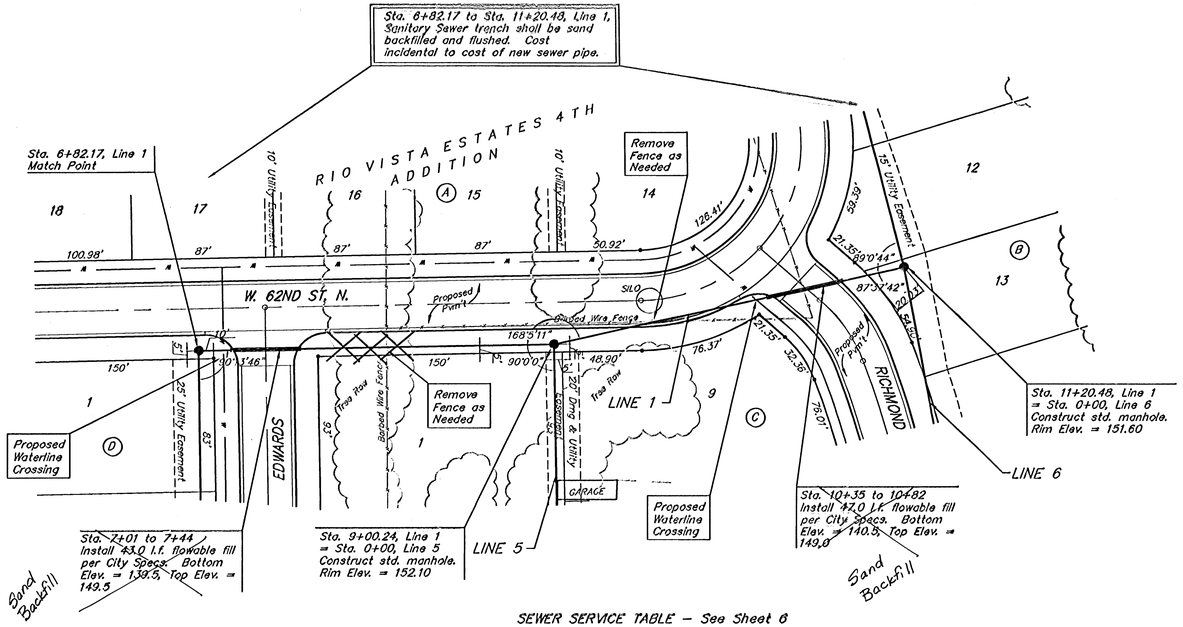

Denotes Trees to be Removed by the Sanitary Sewer Contractor

SEWER SERVICE TABLE – See Sheet 6

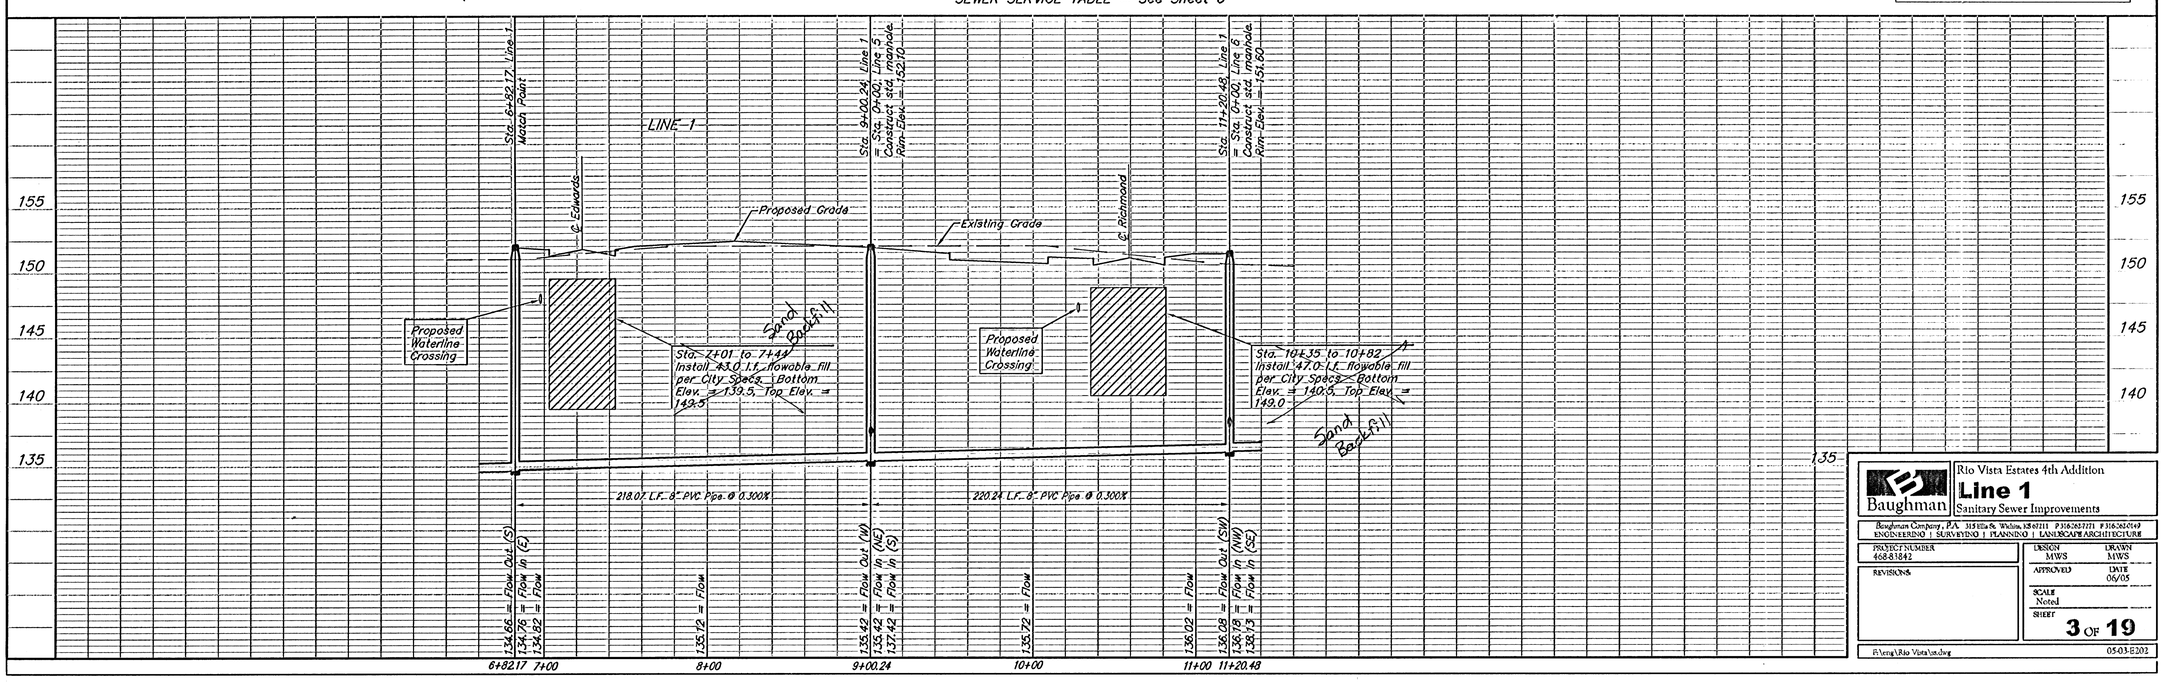

Baughman

Rio Vista Estates 4th Addition

Line 1

Sanitary Sewer Improvements

Baughman Company, P.A. 315 Ella St. Wichita, KS 67211 P 316.263.7171 F 316.263.6149
ENGINEERING | SURVEYING | PLANNING | LANDSCAPE ARCHITECTURE

PROJECT NUMBER	DESIGN	DRAWN
468-81842	MWS	MWS
REVISIONS	APPROVED	DATE 06/05
	SCALE Noted	
	SHEET 3 OF 19	

F:\eng\Rio Vista\us.dwg 05-03-E202