


**BENCHMARK:**  
 R.R. SPIKE IN H.L.P. 150' E. & 30'  
 S. OF THE S.W. COR., S.E. 1/4,  
 SEC. 12-26-1W  
 ELEV. = 1338.98 M.S.L.  
 ELEV. = 151.56 City Datum

"0" IN OPEN, TOP FLANGE OF  
 FIRE HYDRANT AT THE S.W.  
 CORNER OF 61ST ST. N. &  
 MERIDIAN AVE.  
 ELEV. = 1339.16 M.S.L.  
 ELEV. = 151.76 City Datum

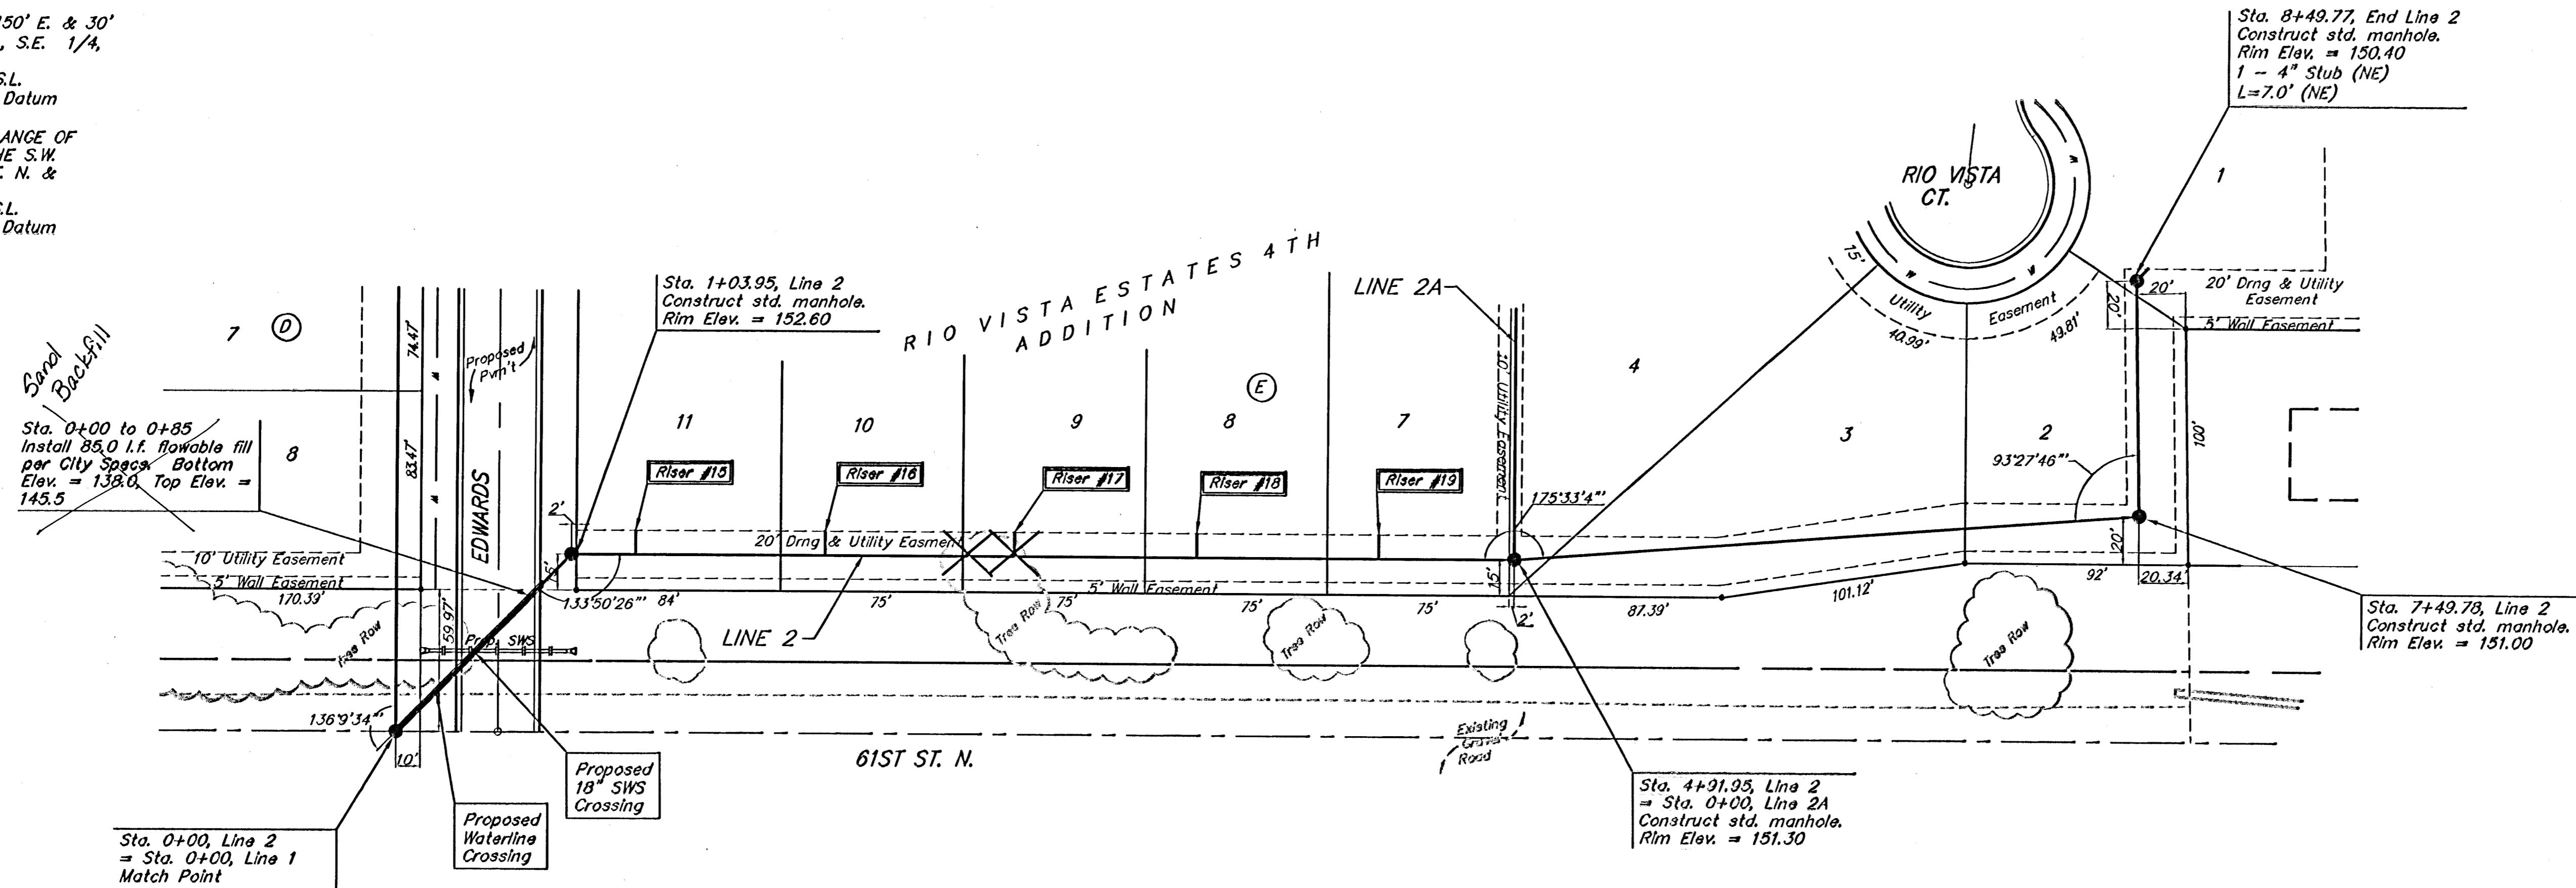

Scale: 1" = 40' Horizontal  
 1" = 5' Vertical  
 • = Iron

Denotes Trees to be  
 Removed by the  
 Sanitary Sewer Contractor



Proposed Grade  
 Existing Grade

103.95 L.F. 8" Pvc @ 3.333%

388.00 L.F. 8" PVC Pvc @ 0.300%

297.85 L.F. 8" PVC Pvc @ 0.300%

100.00 L.F. PVC Pvc @ 0.300%

**Baughman** Rio Vista Estates 4th Addition  
**Line 2**  
 Sanitary Sewer Improvements

 ENGINEERING | SURVEYING | PLANNING | LANDSCAPE ARCHITECTURE

PROJECT NUMBER 468-81842	DESIGN MWS	DRAWN MWS
APPROVED	DATE 06/05	
REVISIONS	SCALE Noted	SHEET 5 OF 19

R:\eng\Rio Vista\dwg 05-03-E202