


SEWER SERVICE TABLE

NUMBER	TYPE	LOCATION			FOR INFORMATION ONLY		
		LOT NO.	BLOCK NO.	LINE NO.	STATION / DIRECTION	APPROXIMATE LENGTH 4" PIPE	
1	8" x 4" Tee Saddle	8	D	1	0+20/LL 94	17'	18' 11.6'
2	8" x 4" Tee Saddle	7	D	1	1+03/LL 68.3	17'	18' 16.4'
3	8" x 4" Tee Saddle	6	D	1	2+41/LL 51.3	17'	15'
4	8" x 4" Tee Saddle	5	D	1	3+12/LL 14.7	18'	19'
5	8" x 4" Tee Saddle	4	D	1	3+26/LL 97.3	18'	23'
6	8" x 4" Tee Saddle	3	D	1	4+71/LL 78.2	15'	18' 17'
7	8" x 4" Tee Saddle	2	D	1	5+12/LL 46.2	15'	18' 16'
8	8" x 4" Tee Saddle	1	D	1	6+18/LL 19.4	15'	18' 16.3'
9	8" x 4" Tee Saddle	12	B	1	11+43/RL 40.3	11'	14' 13.5'
10	8" x 4" Tee Saddle	11	B	1	12+19/RL 15.9	11'	10' 9.6'
11	8" x 4" Tee Saddle	10	B	1	12+07/RL 9.0	10'	8' 5.5'
12	8" x 4" Tee Saddle	9	B	1	13+70/RL 70.8	8'	8' 6'
13	8" x 4" Tee Saddle	5	B	1	18+84/RL 83.5	9'	8' 5'
14	8" x 4" Tee Saddle	4	B	1	17+93/RL 58.9	9'	8' 7'
15	8" x 4" Tee Saddle	11	E	2	1+30/LL 28.9	11'	10' 11.3'
16	8" x 4" Tee Saddle	10	E	2	2+08/LL 10.9	10'	10' 11.9'
17	8" x 4" Tee Saddle	9	E	2	2+28/LL 83.6	10'	10' 9.7'
18	8" x 4" Tee Saddle	8	E	2	3+01/LL 68.1	10'	10' 10.8'
19	8" x 4" Tee Saddle	7	E	2	4+38/LL 31.5	10'	10' 9.6'
20	8" x 4" Tee Saddle	13	A	3	1+01/RL 81.2	8'	18' 14'
21	8" x 4" Tee Saddle	12	A	3	2+24/RL 22.2	8'	18' 14'
22	8" x 4" Tee Saddle	11	A	3	3+05/RL 03.3	6'	18' 14'
23	8" x 4" Tee Saddle	10	A	3	4+04/RL 01.3	6'	15'
24	8" x 4" Tee Saddle	5	A	4	1+13/RL 10.1	8'	18' 11.0'
25	8" x 4" Tee Saddle	4	A	4	2+58/RL 61.1	6'	15'
26	8" x 4" Tee Saddle	3	A	4	4+00/RL 00.1	5'	15'
27	8" x 4" Tee Saddle	9	C	5	0+20/LL 27.3	11'	18' 14.8'
28	8" x 4" Tee Saddle	1	C	5	0+40/RL 32.4	10'	8' 7.4'
29	8" x 4" Tee Saddle	13	B	6	0+14/LL 22.0	10'	18' 16'
30	8" x 4" Tee Saddle	14	B	6	0+88/LL 90.2	10'	18' 19'
31	8" x 4" Tee Saddle	8	B	1	14+22/RL 22.3	10'	8' 6'
32	8" x 4" Tee Saddle	7	B	1	13+30/RL 32.3	10'	8' 6'
33	8" x 4" Tee Saddle	6	B	1	16+03/RL 03.3	10'	8' 6'
34	4" Riser Assy.	3	B	1	18+13.37/RL 8.2	10'	8' 6' (N.E.)
35	8" x 4" Tee Saddle	2	B	1	19+32/RL 32.1	9'	28' 2.6'
36	8" x 4" Tee Saddle	1	B	1	20+34/RL 34.7	9'	18' 15'

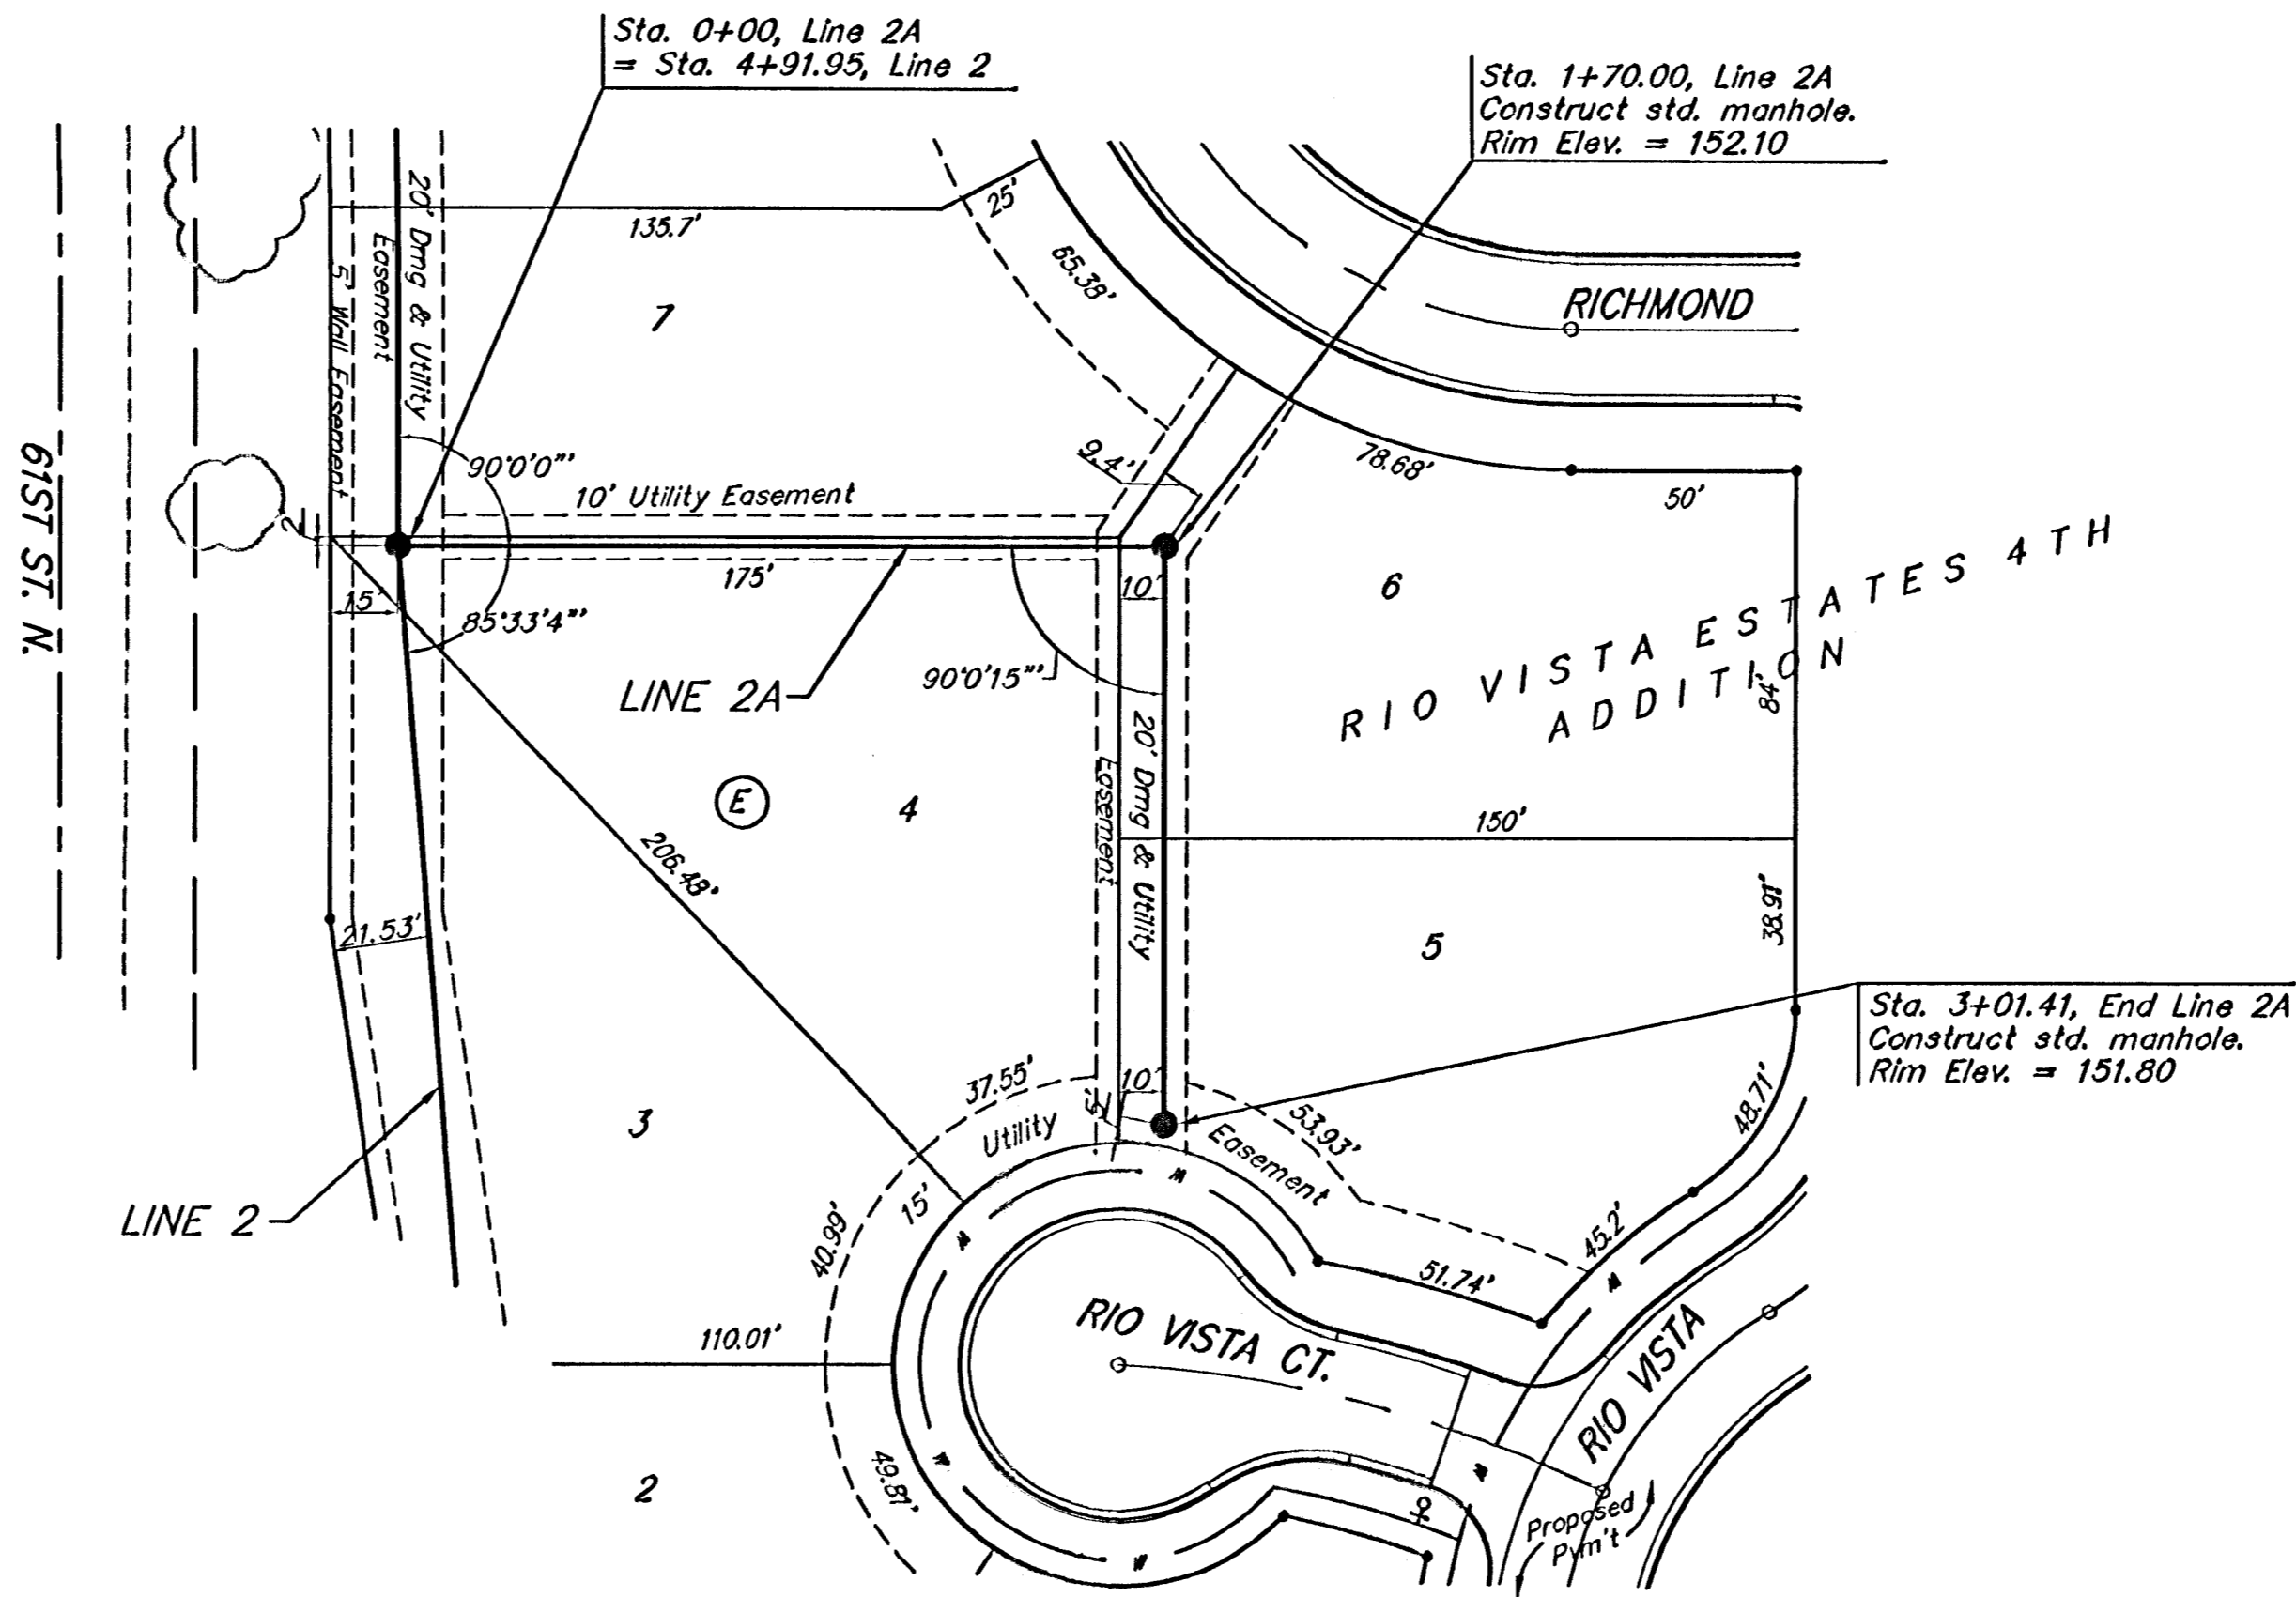

Scale: 1" = 40' Horizontal
1" = 5' Vertical
= Iron


BENCHMARK:
R.R. SPIKE IN HLP, 150' E. & 30'
S. OF THE S.W. COR., S.E. 1/4,
SEC. 12-28-11W.
ELEV. = 1338.98 M.S.L.
ELEV. = 151.58 City Datum

"0" IN OPEN, TOP FLANGE OF
FIRE HYDRANT AT THE S.W.
CORNER OF 61ST ST. N. &
MERIDIAN AVE.
ELEV. = 1339.16 M.S.L.
ELEV. = 151.78 City Datum

Denotes Trees to be
Removed by the
Sanitary Sewer Contractor

SEWER SERVICE TABLE - See Sheet 6

NOTE: Vertical Riser Pipe shall be extended to 2' minimum above ground water elevation and 4' maximum below proposed ground elevation.

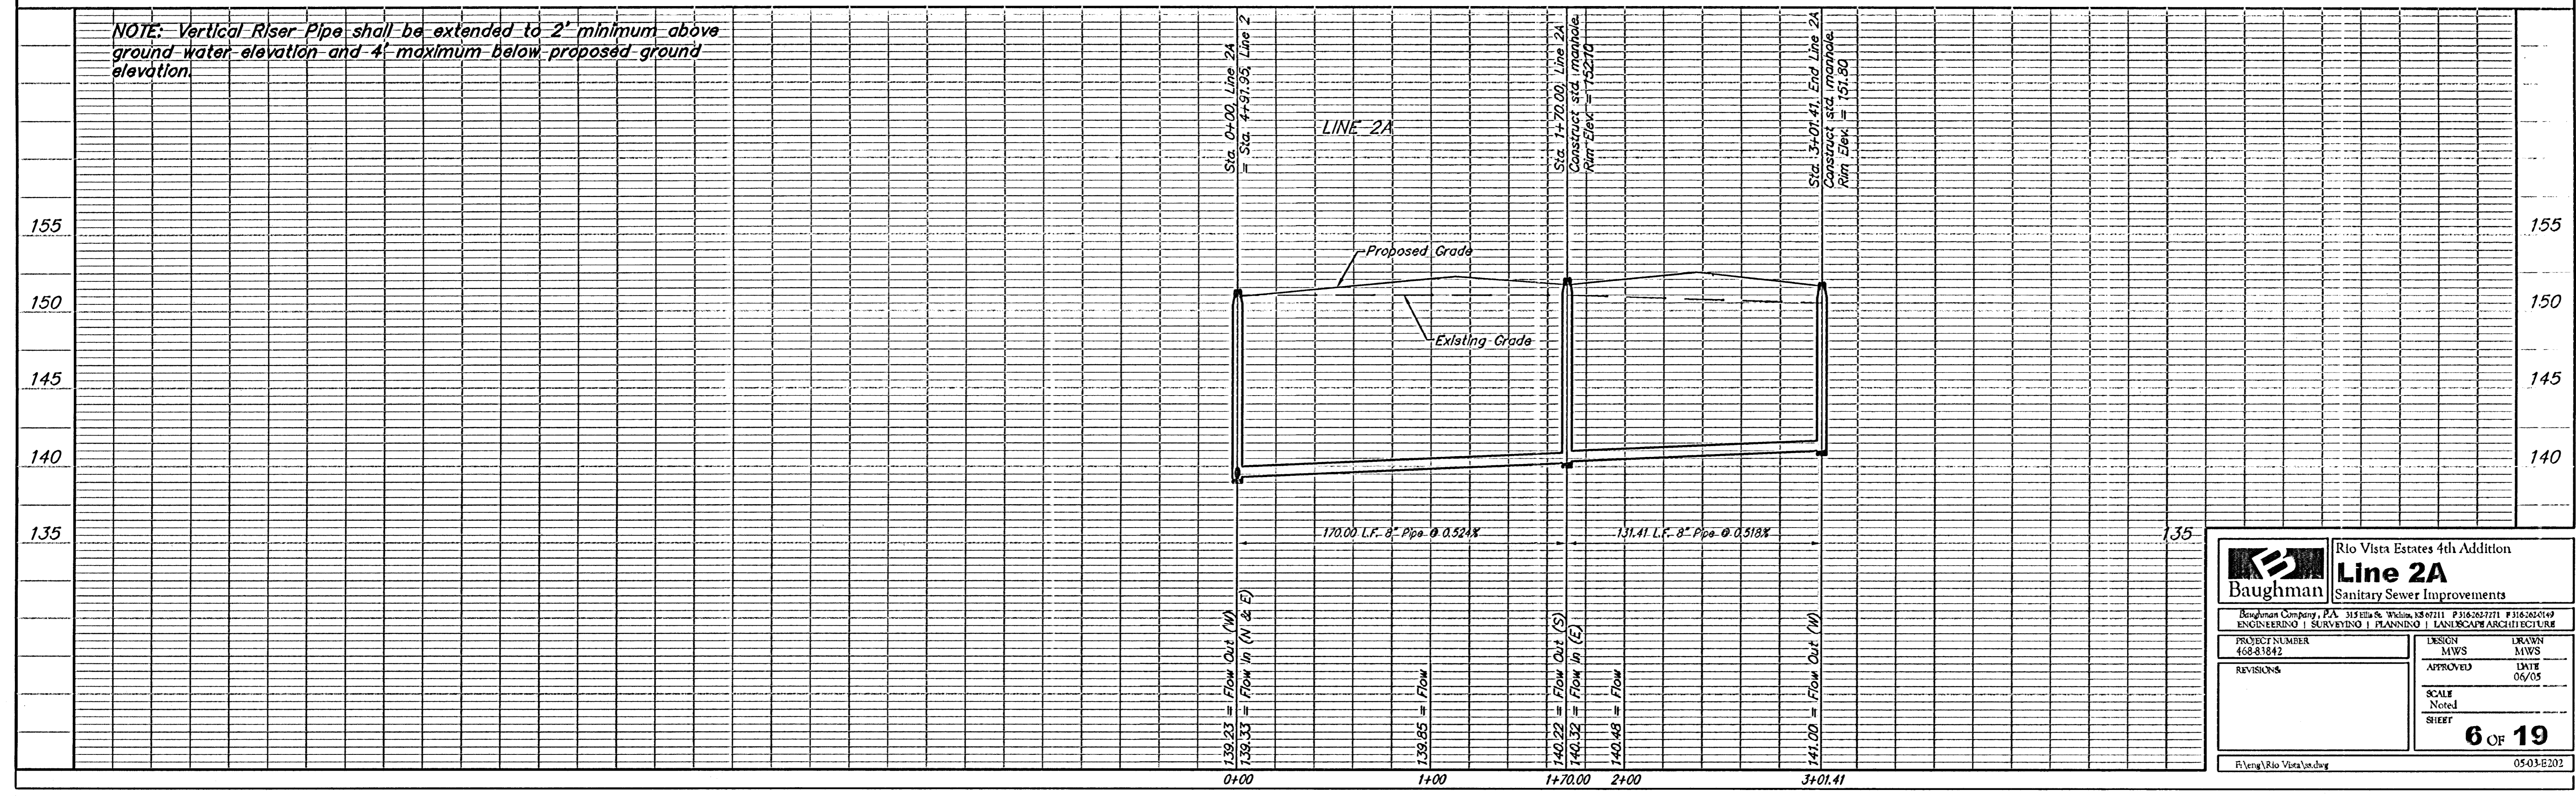

Baughman Rio Vista Estates 4th Addition
Line 2A
Sanitary Sewer Improvements

Baughman Company, P.A. 315 E. 11th St., Wichita, KS 67211 P: 316.262.7171 F: 316.262.0149
ENGINEERING | SURVEYING | PLANNING | LANDSCAPE ARCHITECTURE

PROJECT NUMBER: 458-81842
DESIGN: MVS
DRAWN: MVS
APPROVED: [Signature]
DATE: 06/05

SCALE: Noted
SHEET: **6 OF 19**

F:\eng\Rio Vista\en.dwg 05-03-2021