
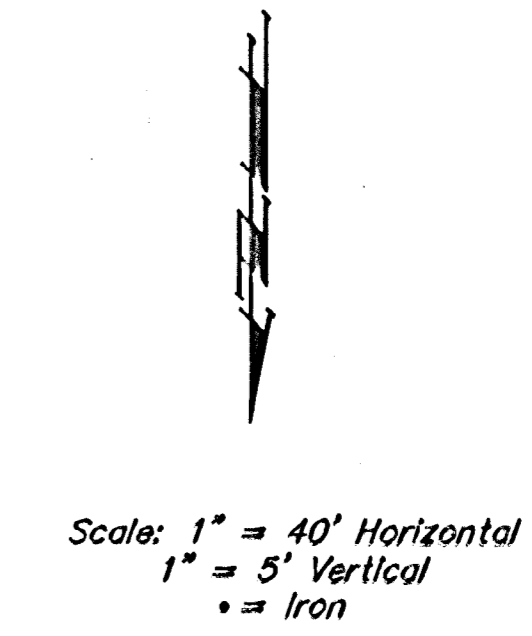



BENCHMARK:
 R.R. SPIKE IN HLP, 150' E. & 30'
 S. OF THE S.W. COR., S.E. 1/4,
 SEC. 12-26-1W.
 ELEV. = 1338.96 M.S.L.
 ELEV. = 151.56 City Datum

"0" IN OPEN, TOP FLANGE OF
 FIRE HYDRANT AT THE S.W.
 CORNER OF 61ST. ST. N. &
 MERIDIAN AVE.
 ELEV. = 1339.16 M.S.L.
 ELEV. = 151.76 City Datum

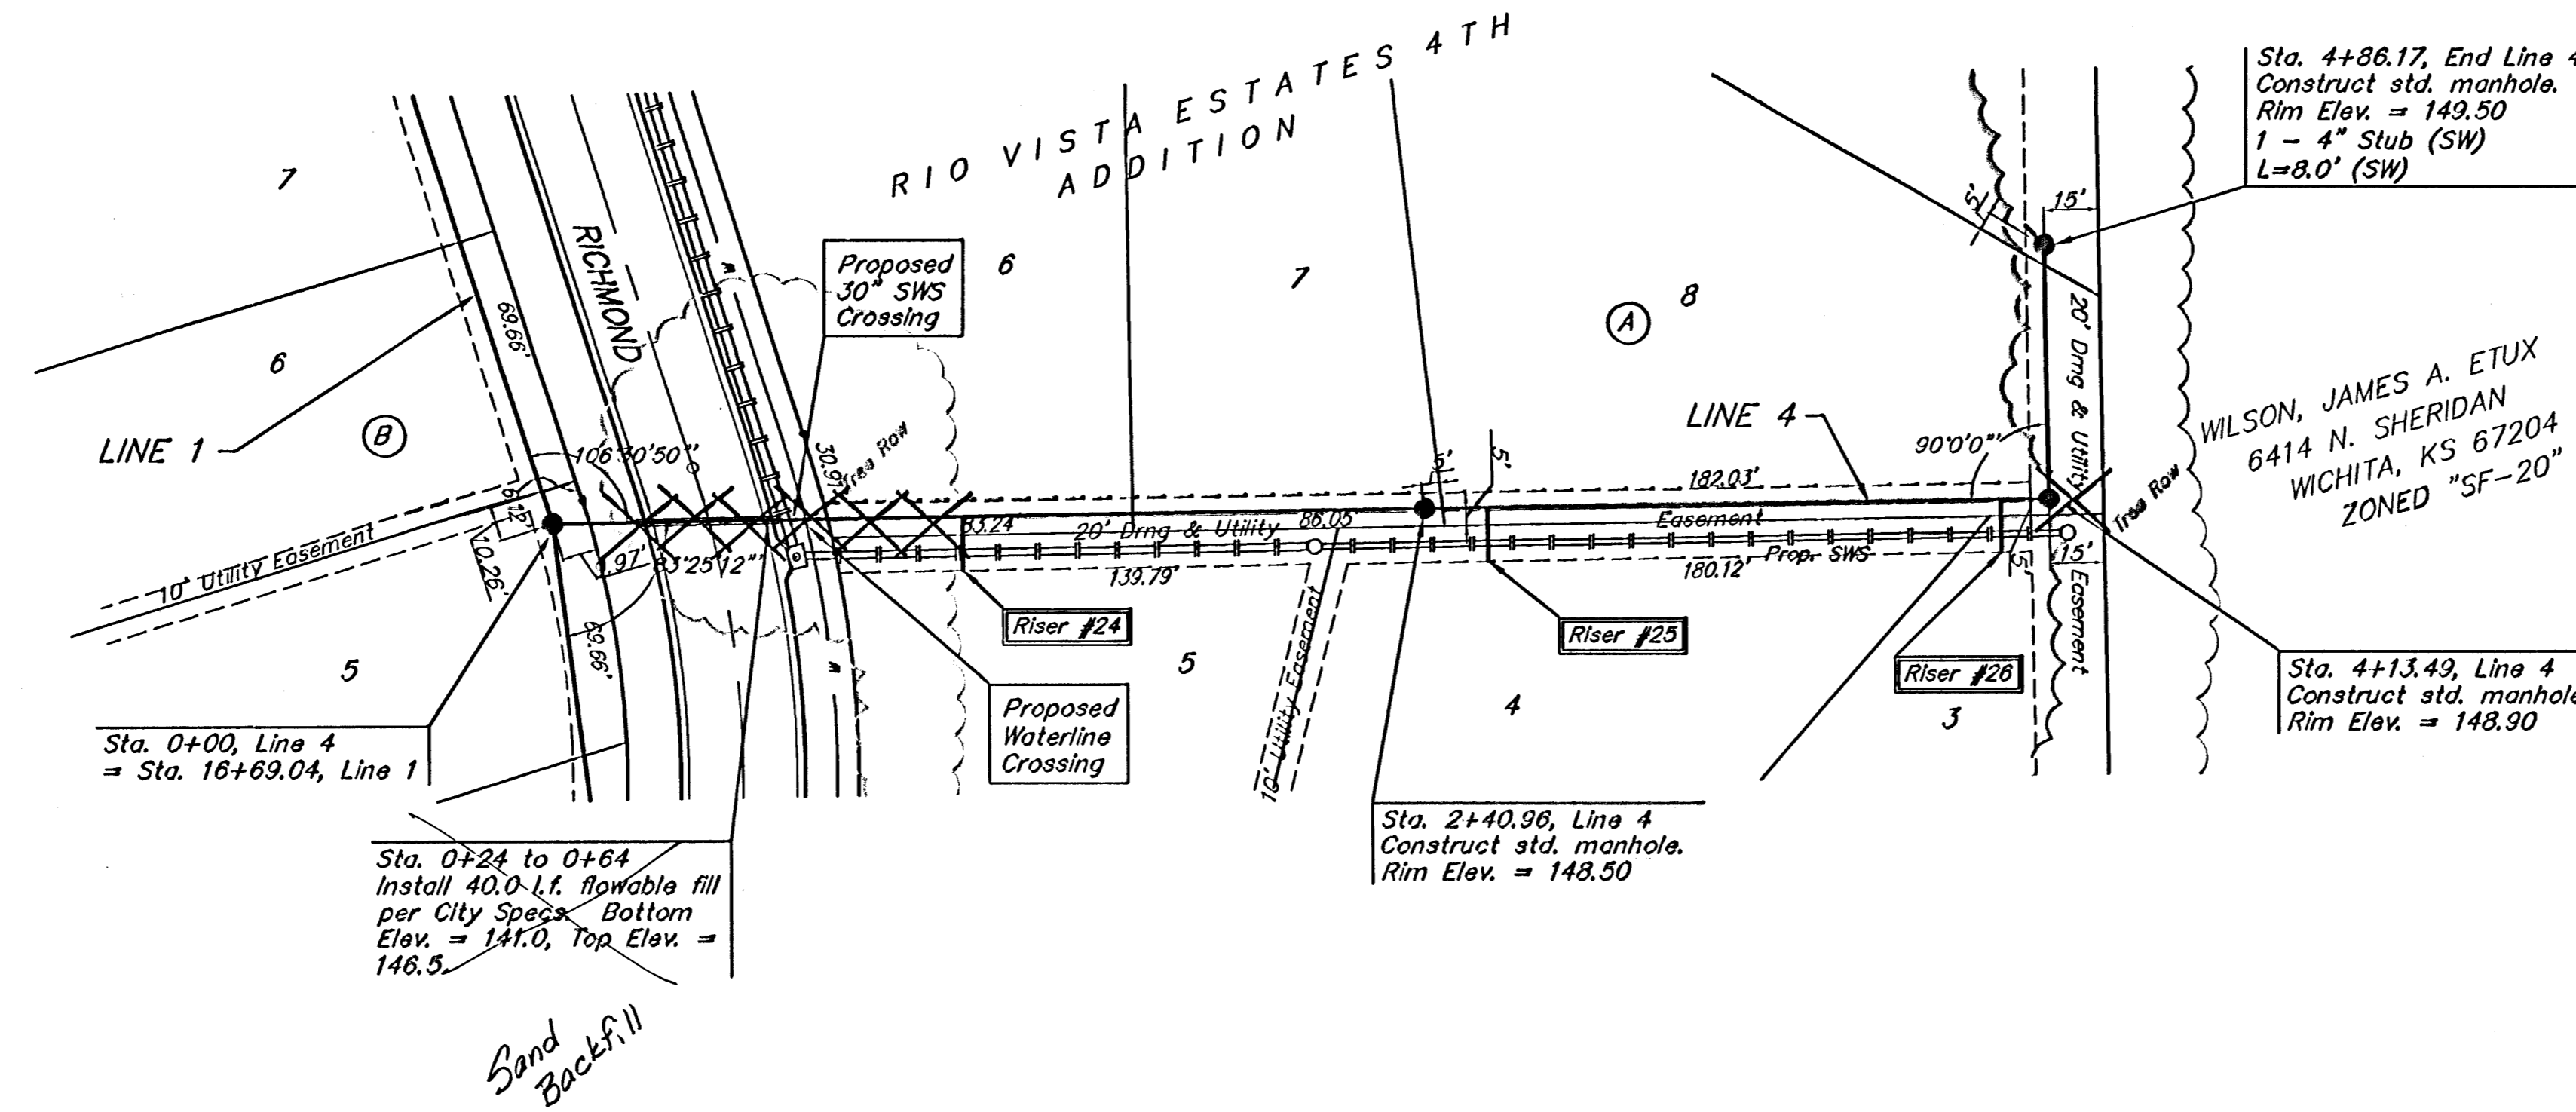

Denotes Trees to be
 Removed by the
 Sanitary Sewer Contractor

SEWER SERVICE TABLE - See Sheet 6

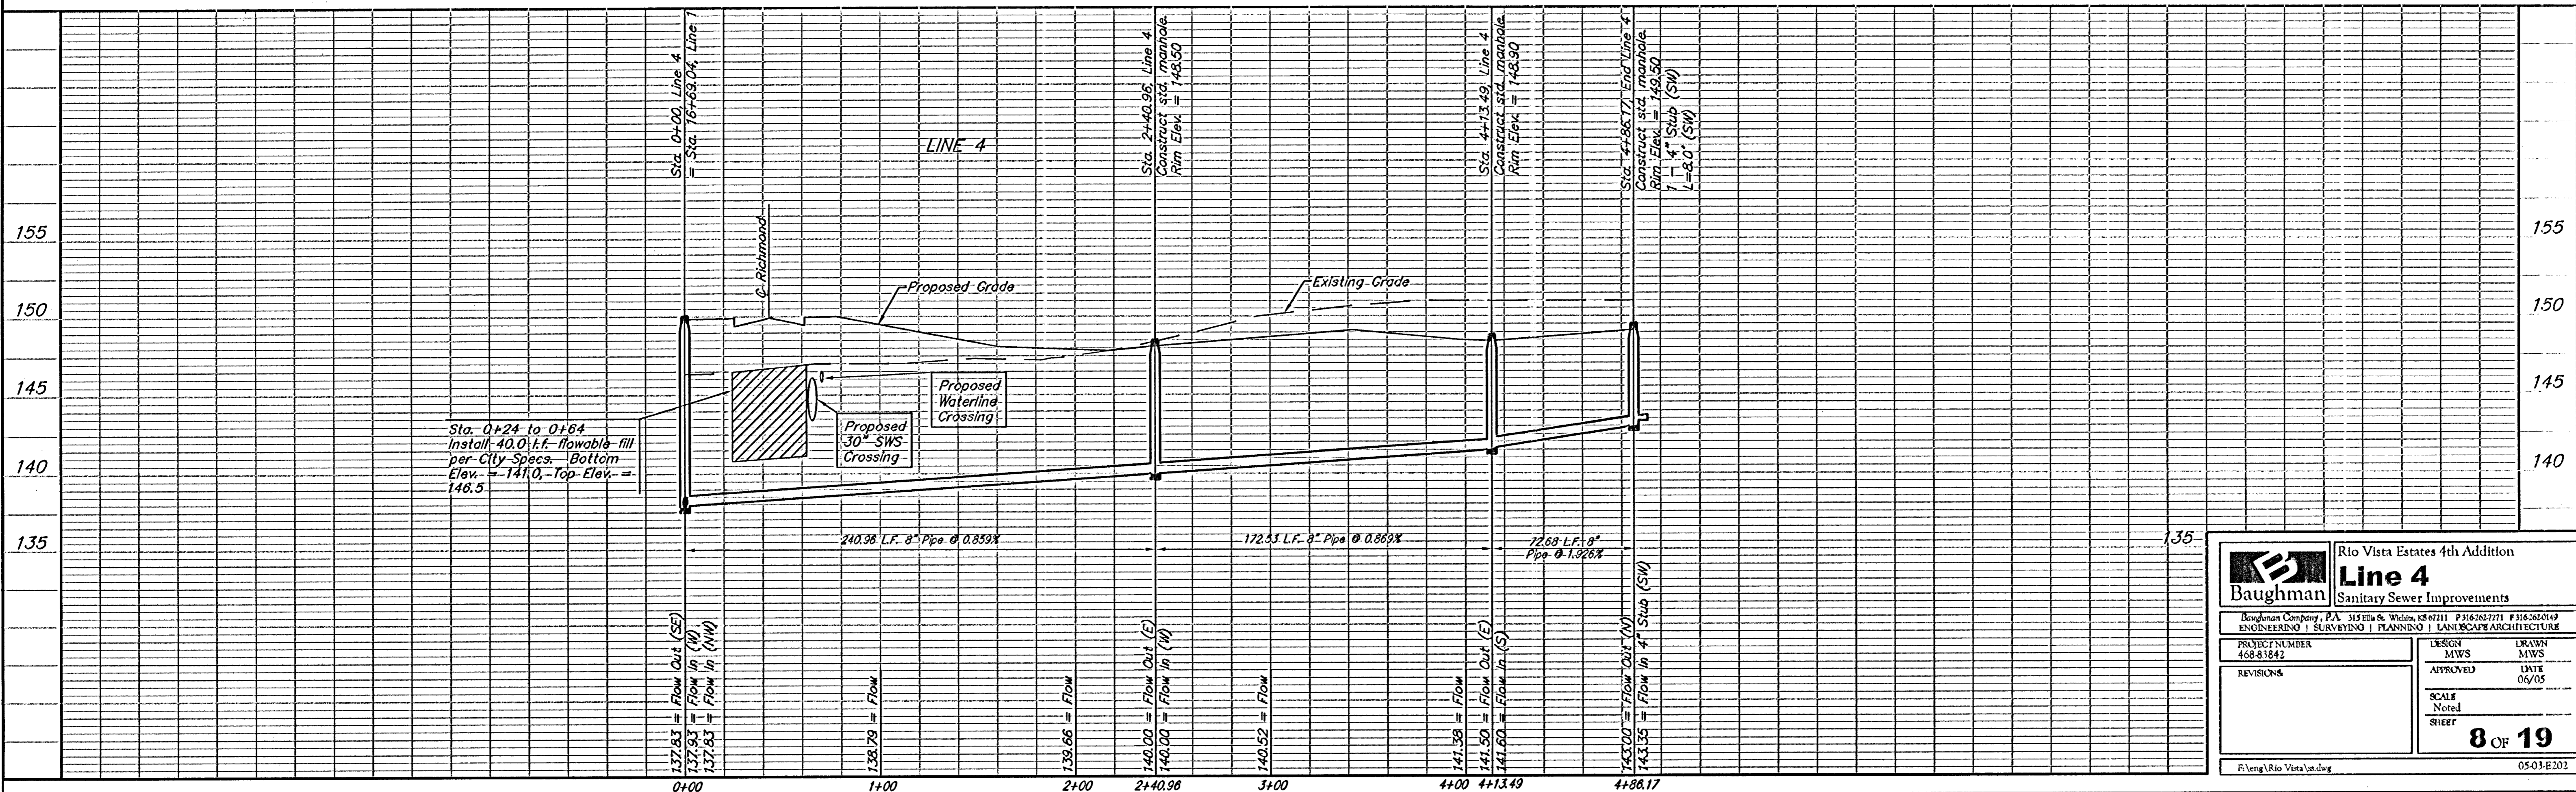

		Rio Vista Estates 4th Addition	
		Line 4 Sanitary Sewer Improvements	
Baughman Company, P.A. 315 E. 11th St. Wichita, KS 67211 P 316-262-7771 F 316-262-0149 ENGINEERING SURVEYING PLANNING LANDSCAPE ARCHITECTURE		DESIGN	DATE
PROJECT NUMBER	468-81542	MWS	06/05
REVISIONS		APPROVED	
		SCALE	Noted
		SHEET	8 OF 19
F:\eng\Rio Vista\ss.tbl		0503-E202	