SCALE:
PLAN: LAT. & LONG. 0 40 80
PROFILE: HORIZ. SAME AS ABOVE
VERT.

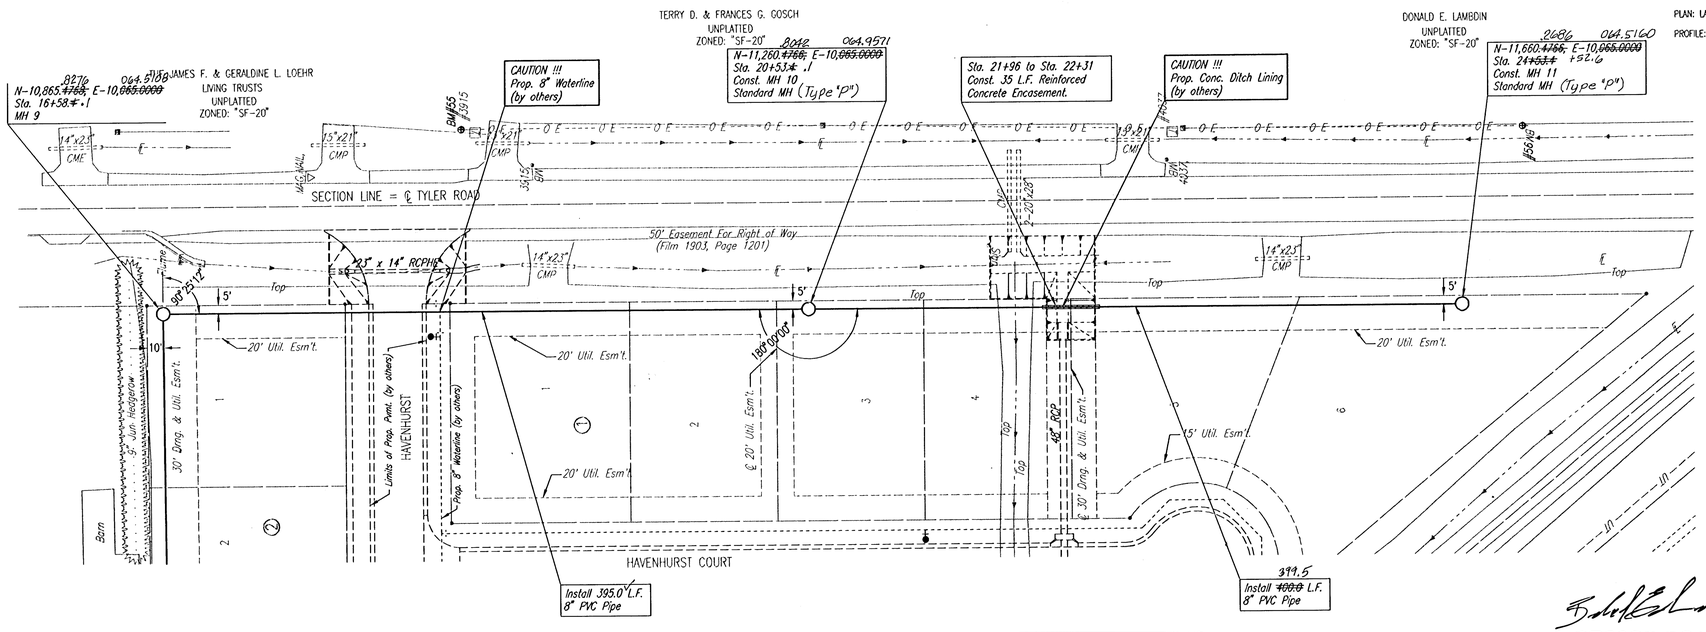

RECORD DRAWING

23 JUL 05

SANITARY SEWER LINE NO. 2

SANITARY SEWER PIPE SLOPES HAVE NOT BEEN REVISED TO REFLECT AS CONSTRUCTED CONDITIONS.

ALL PIPE INSTALLED IS PVC PIPE.

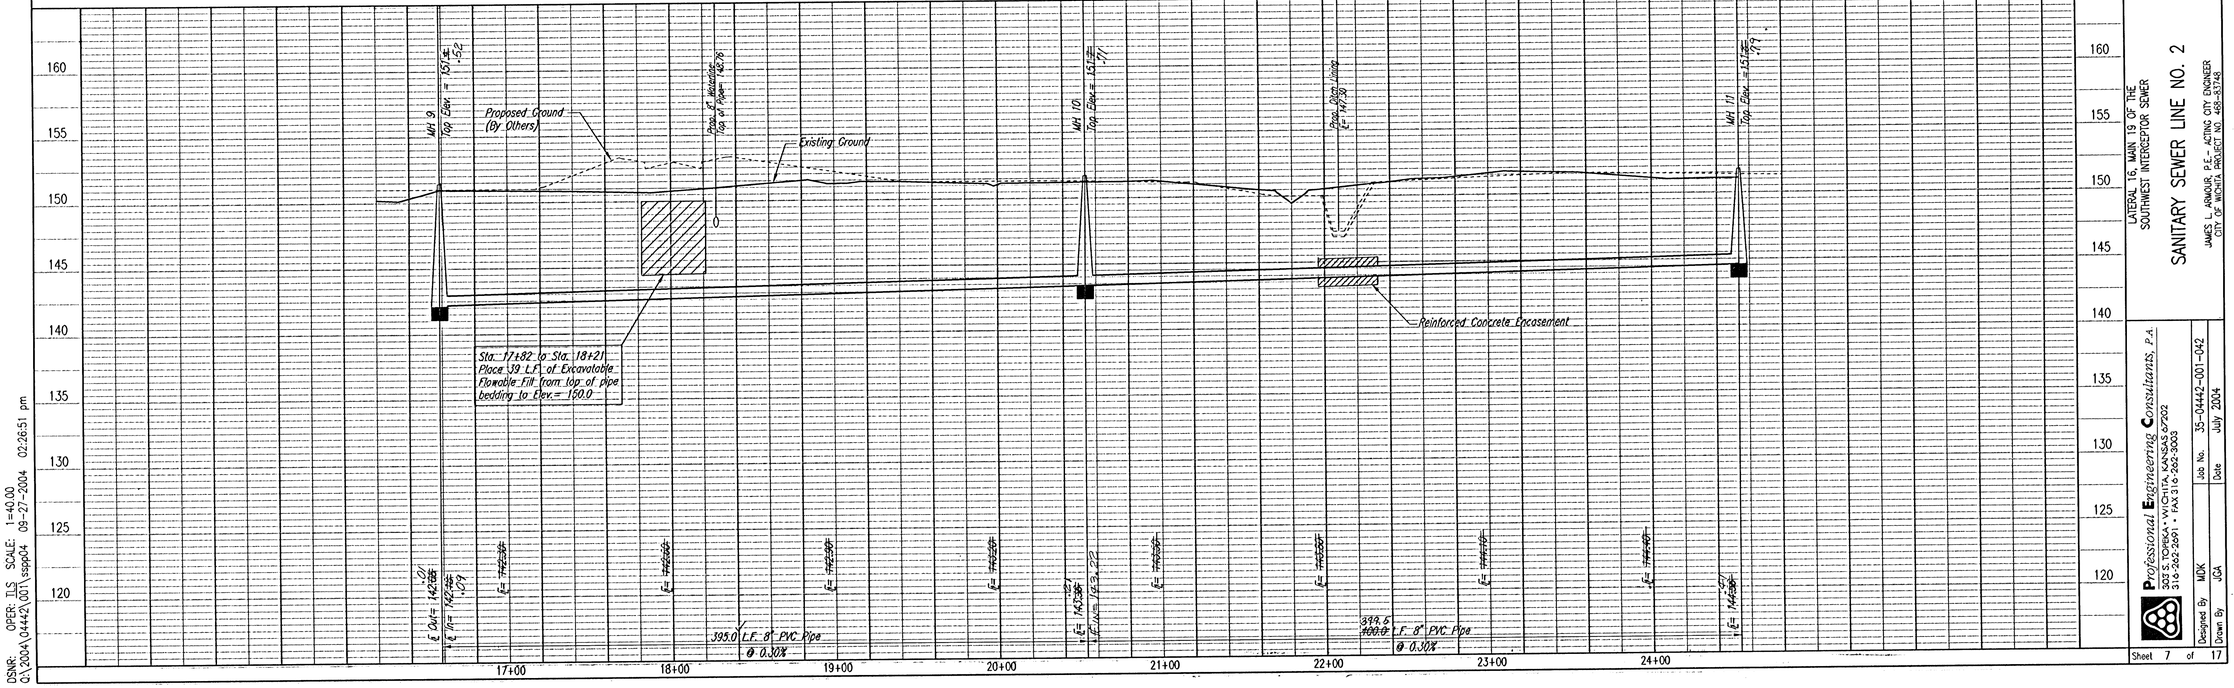

LATERAL 16, MAIN 19 OF THE SOUTHWEST INTERCEPTOR SEWER

SANITARY SEWER LINE NO. 2

JAMES L. ARMOUR, P.E. – ACTING CITY ENGINEER
CITY OF WICHITA, PROJECT NO. 468-87746

Professional Engineering Consultants, P.A.
303 S. TOPEKA • WICHITA, KANSAS 67202
316-262-2691 • FAX 316-262-3003

Designed By MDK | Job No. 35-04442-001-042
Drawn By JGA | Date July 2004

Sheet 7 of 17

PLAN CHECKED CHECKED | BY | DATE | 8Y

PROFILE CHECKED CHECKED | BY | DATE

DSWG: OPER: TLS SCALE: 1=40.00
C:\2004\04442\001\ssp004 09-27-2004 02:26:51 pm