

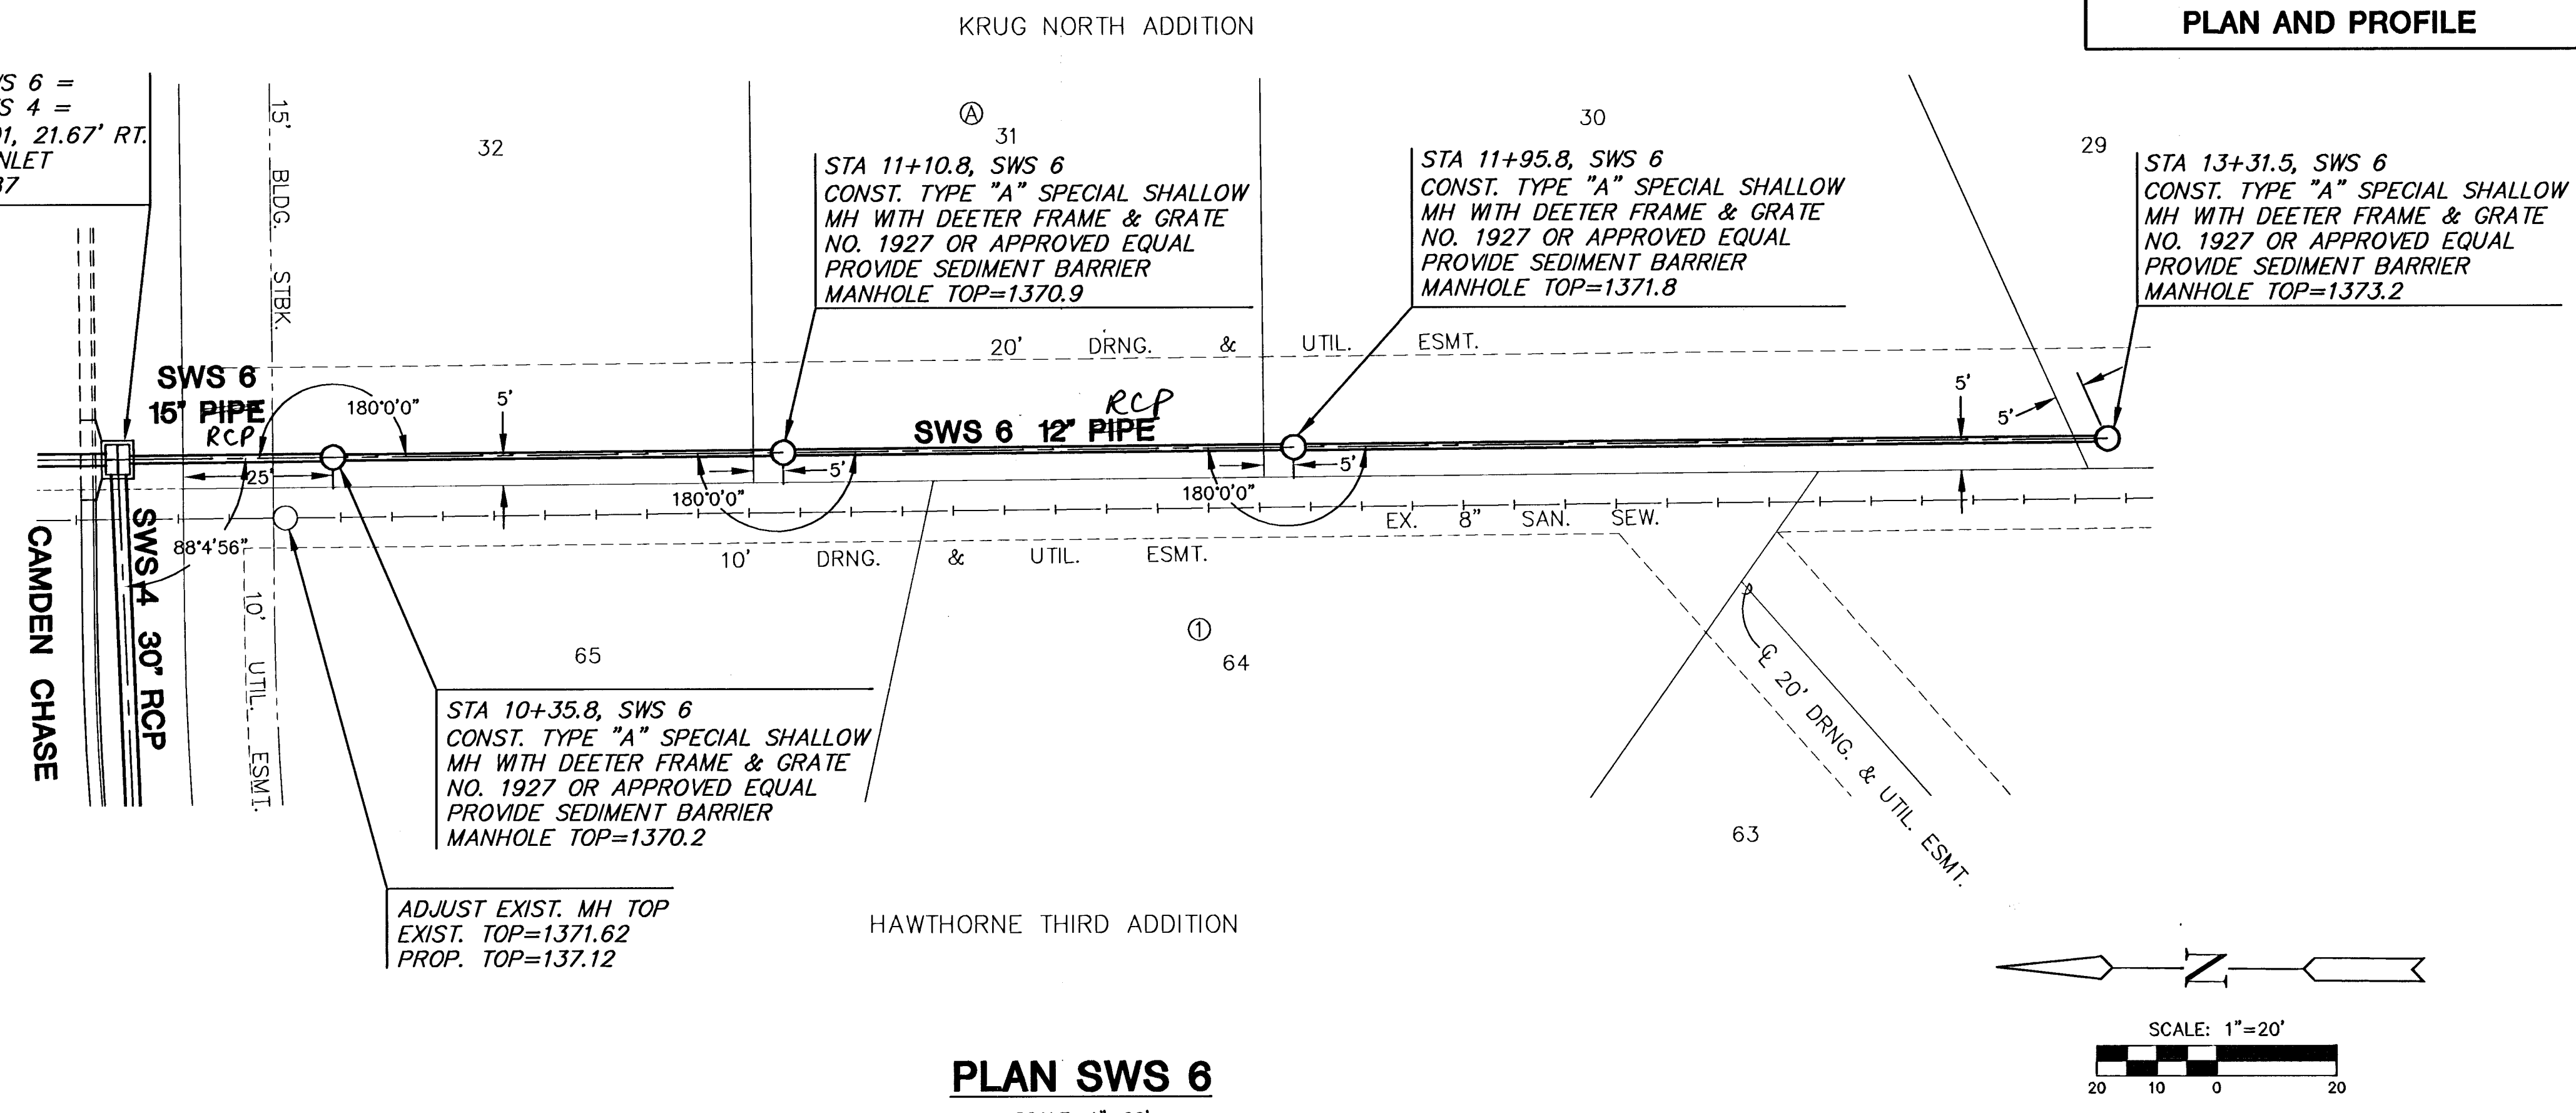


HAWTHORNE PHASE 1
STORM WATER SEWER PLANS
PLAN AND PROFILE

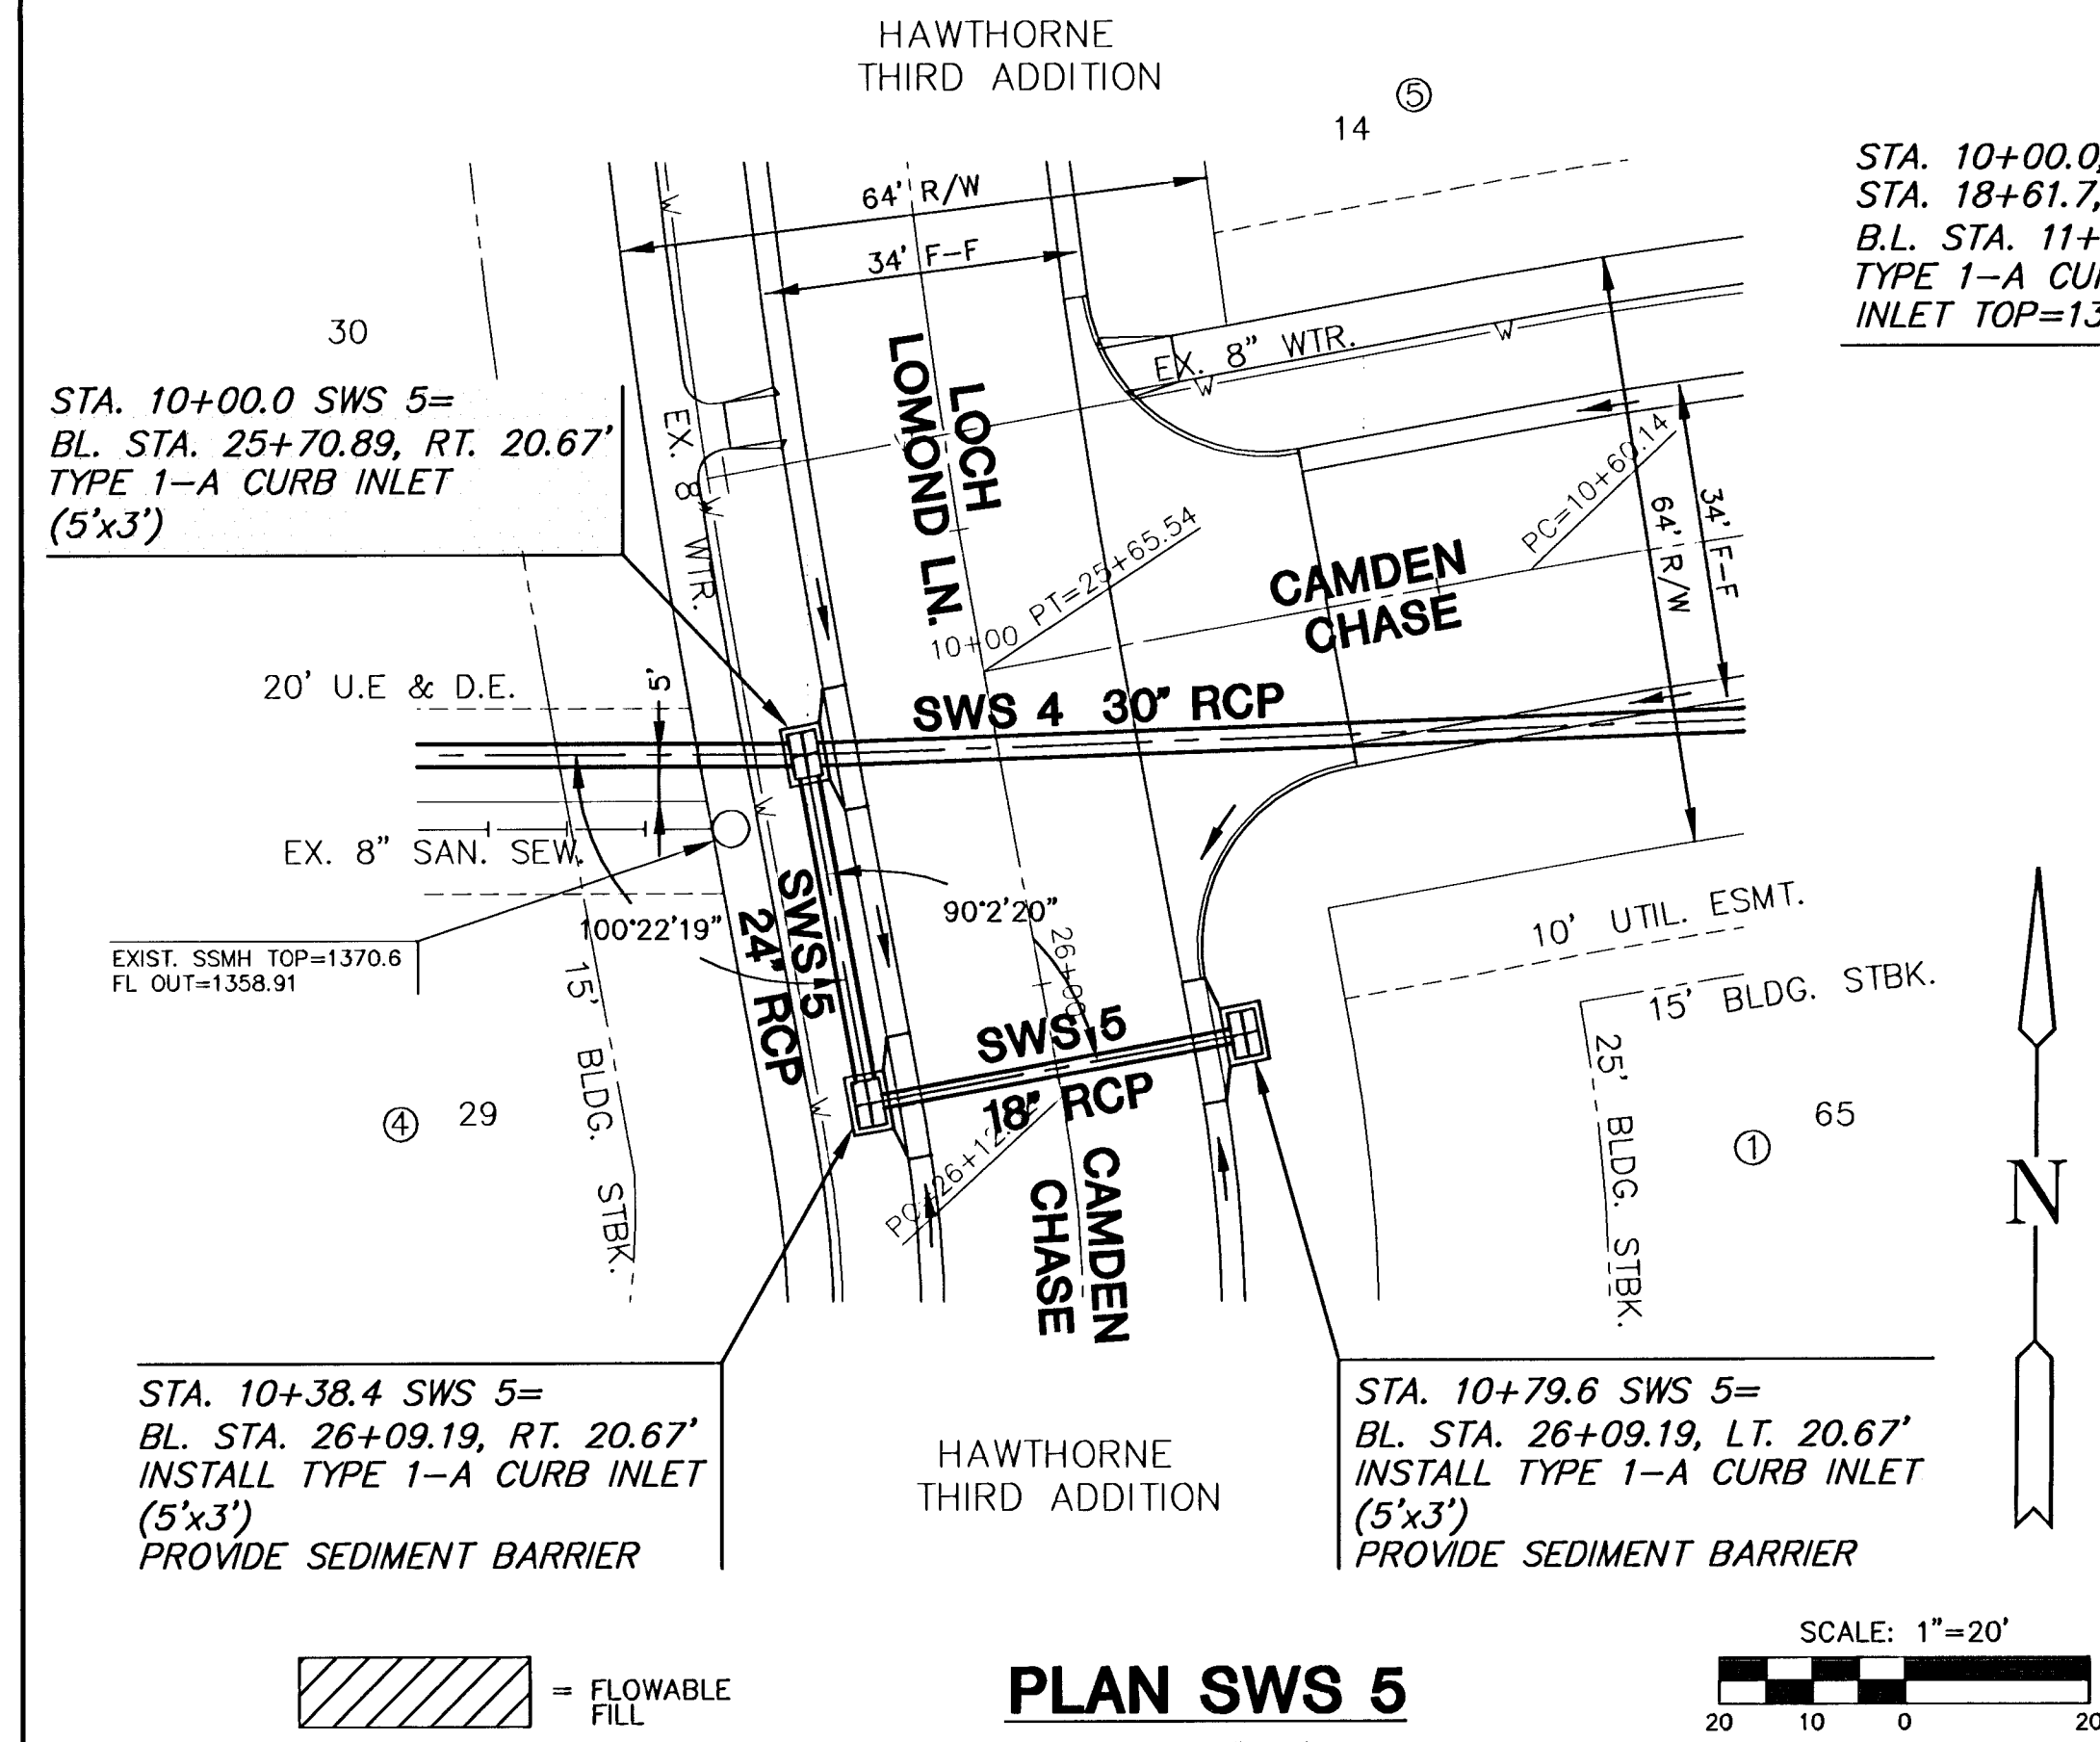

PROFILE SWS 5

SCALE: HORIZ. 1"=20'
SCALE: VERT. 1"=5'

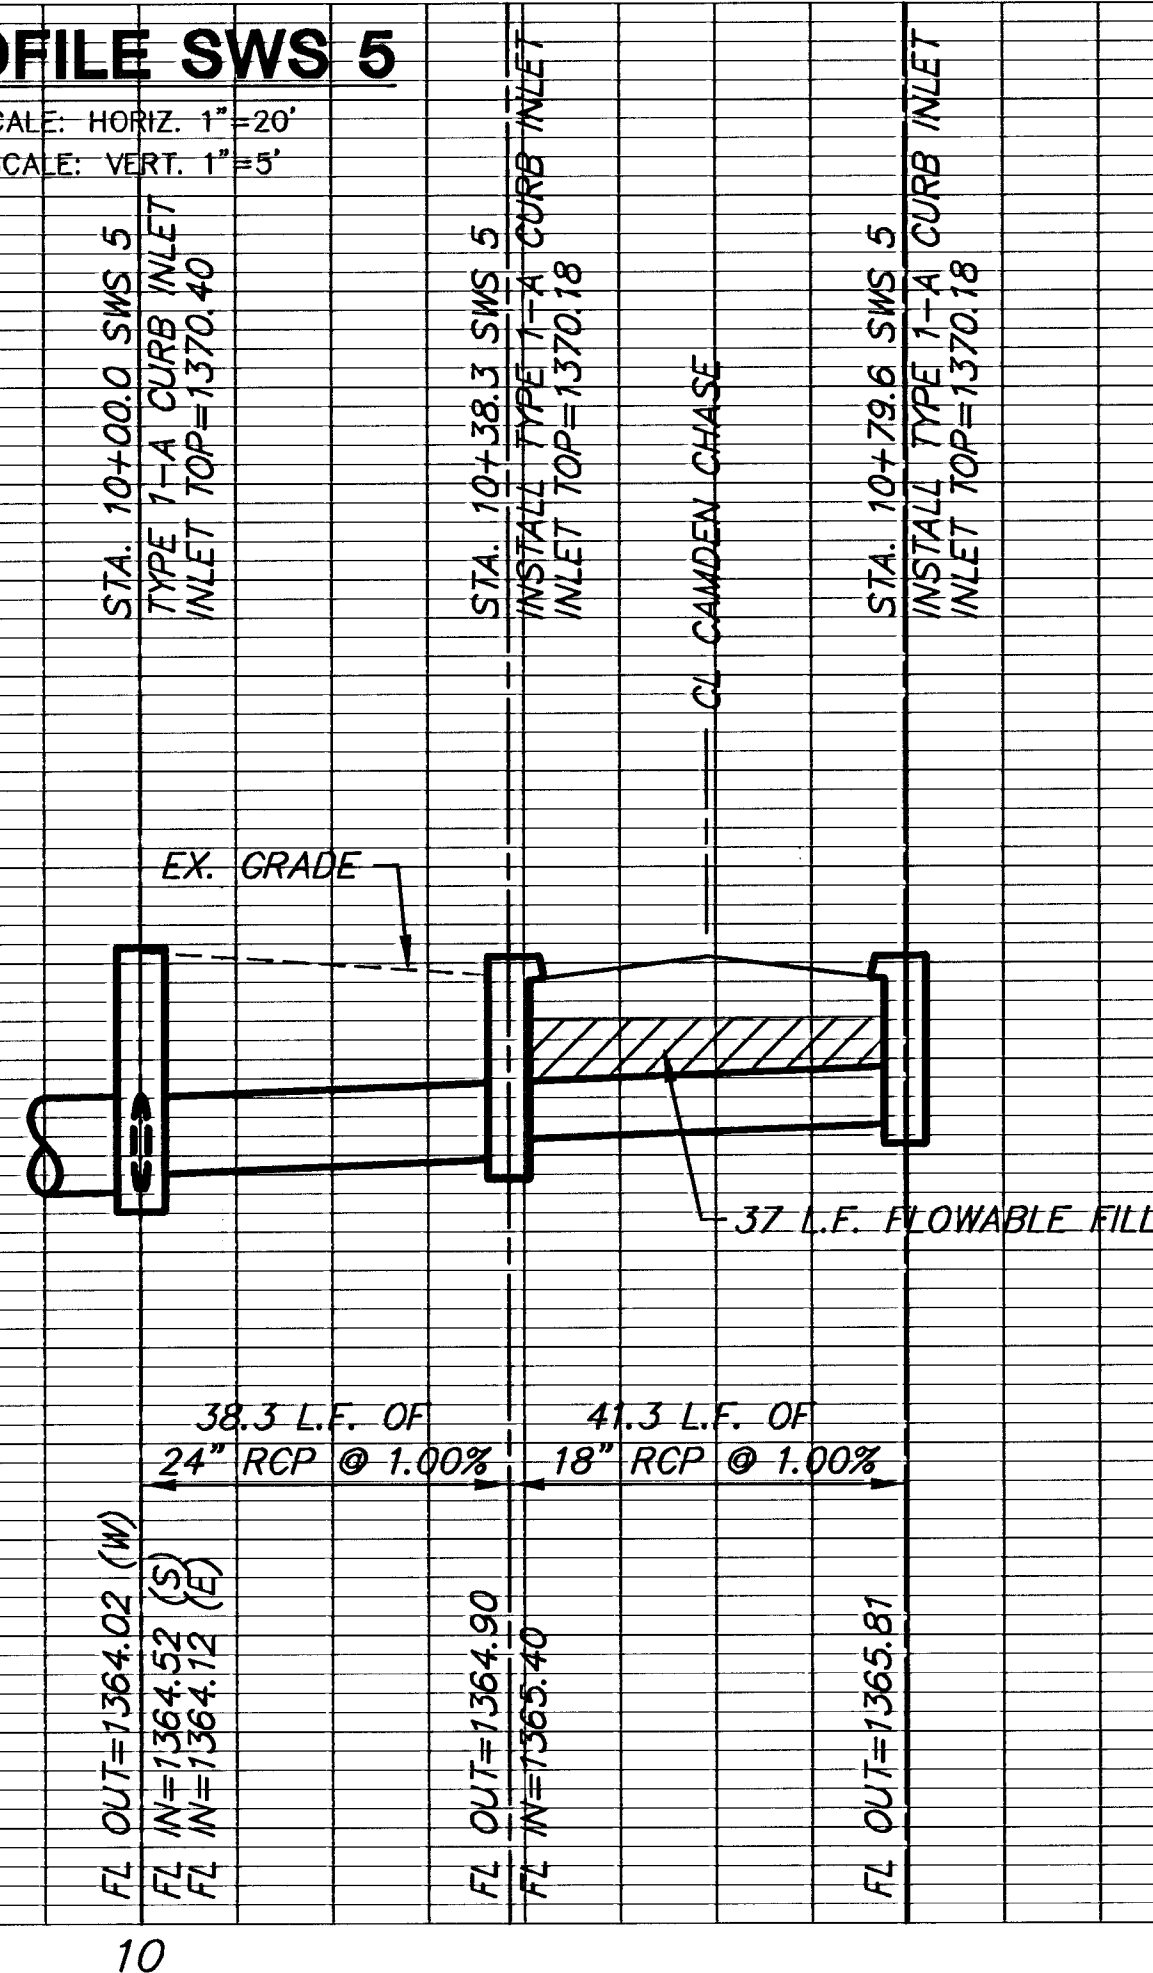

PROFILE SWS 6

SCALE: HORIZ. 1"=20'
SCALE: VERT. 1"=5'

