


## MEDIAN DETAIL (A)

For Section Location, See Plan Sheets.

Not to Scale

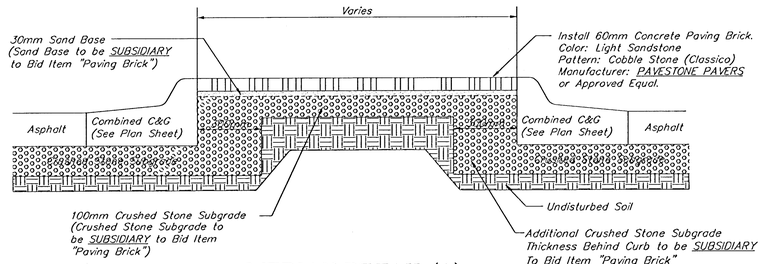


## MEDIAN DETAIL (B)

For Section Location, See Plan Sheets.

Not to Scale

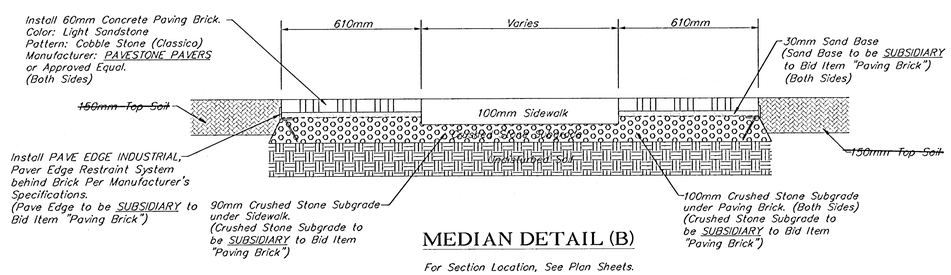


## MEDIAN DETAIL (C)

For Section Location, See Plan Sheets.

Not to Scale

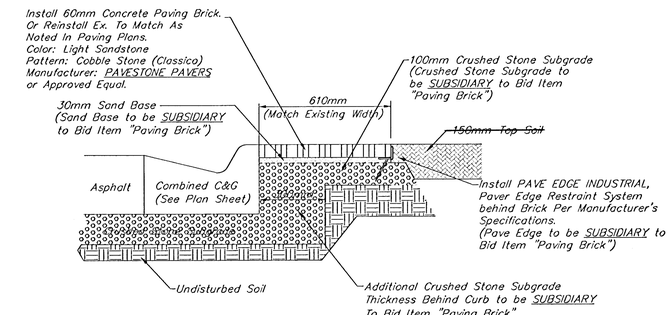


## MEDIAN DETAIL (D)

For Section Location, See Plan Sheets.

Not to Scale

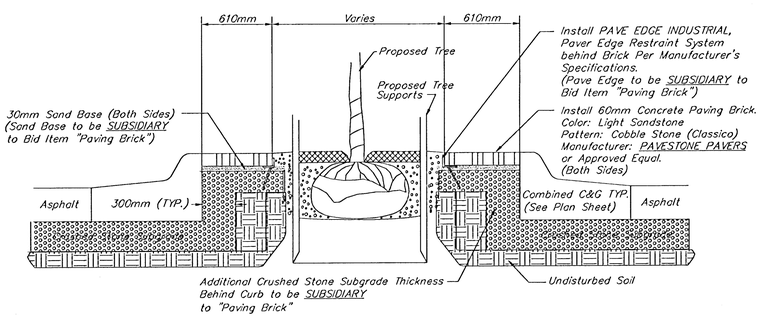


## PAVER DETAIL (A)

CENTRAL AND ZOO BLVD. MEDIAN

Not to Scale

| DESIGN | DATE | CITY PROJECT NUMBER | BAUGHMAN PROJECT NUMBER: 98-01-E965 |
|---|---|---|---|
| STAFF | JULY99 | 472-78-245-82910 | DIRECTORY: P:\MCLNINT\DETAILS |
| DRAWN | SCALE | APPROVED | DRAWING NAME: |
| STAFF | NONE | JFB | MISCDTL2.DWG |

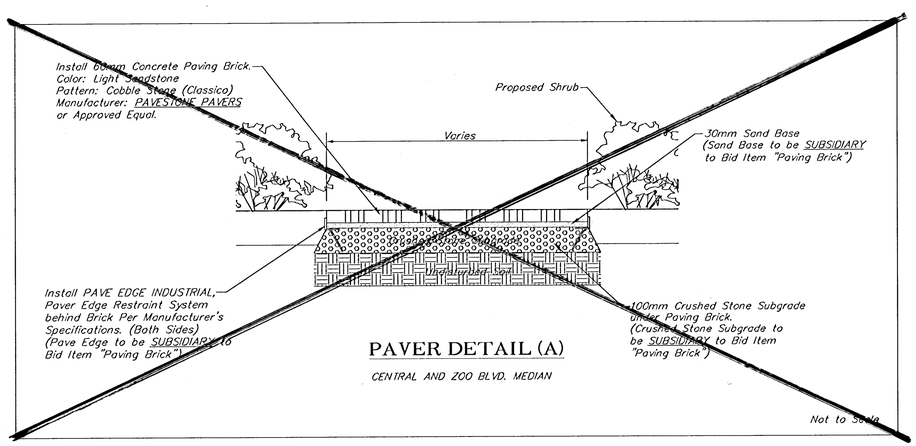CAPITAL IMPROVEMENT PROJECT
**MISCELLANEOUS PAVEMENT DETAILS**
CENTRAL & MCLEAN INTERSECTION IMPROVEMENTS

BAUGHMAN COMPANY P. A.
ENGINEERING, SURVEYING, & PLANNING
316-262-7271 • 315 ELLIS • WICHITA, KANSAS 67211

SHEET 14 OF 40