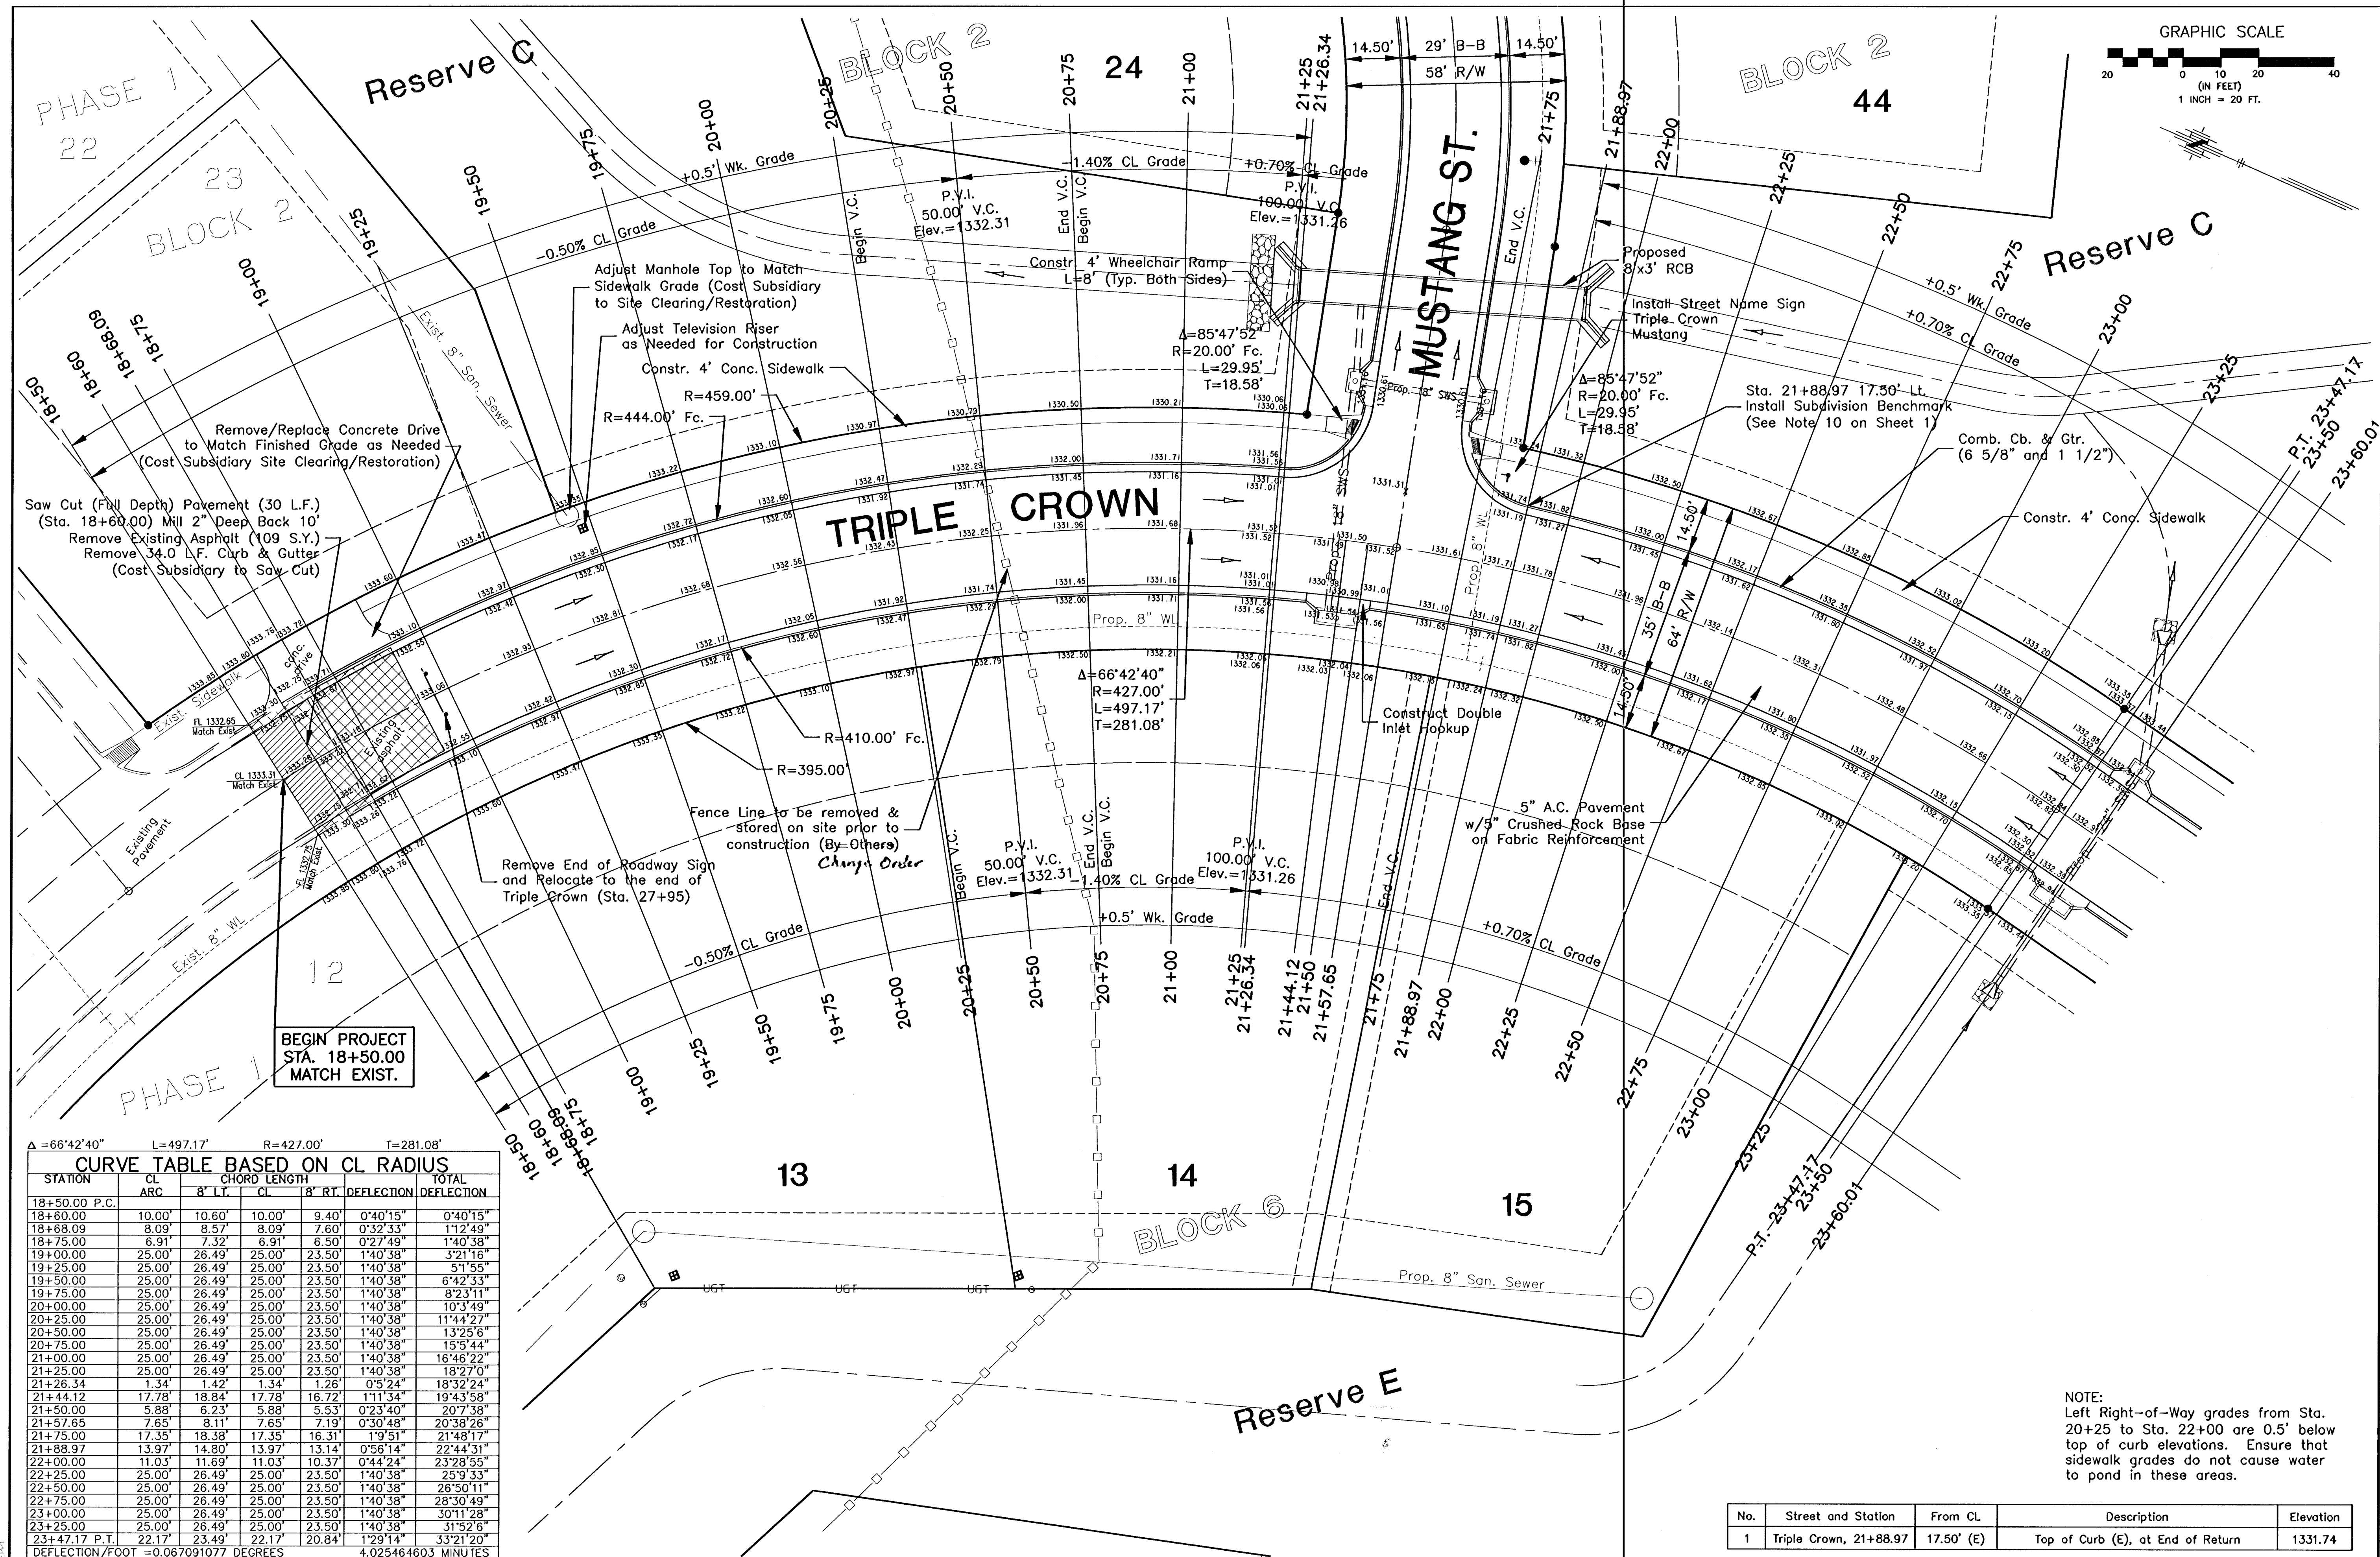


CURVE TABLE BASED ON CL RADIUS						
STATION	CL	CHORD LENGTH	8' RT.	DEFLECTION	TOTAL	DEFLECTION
19+00.00	25.00'	26.49'	25.00'	23.50'	1°40'38"	3°21'16"
19+25.00	25.00'	26.49'	25.00'	23.50'	1°40'38"	5°01'55"
19+50.00	25.00'	26.49'	25.00'	23.50'	1°40'38"	6°42'33"
19+75.00	25.00'	26.49'	25.00'	23.50'	1°40'38"	8°23'11"
20+00.00	25.00'	26.49'	25.00'	23.50'	1°40'38"	10°03'49"
20+25.00	25.00'	26.49'	25.00'	23.50'	1°40'38"	11°44'27"
20+50.00	25.00'	26.49'	25.00'	23.50'	1°40'38"	13°25'06"
20+75.00	25.00'	26.49'	25.00'	23.50'	1°40'38"	15°05'44"
21+00.00	25.00'	26.49'	25.00'	23.50'	1°40'38"	16°46'22"
21+25.00	25.00'	26.49'	25.00'	23.50'	1°40'38"	18°27'00"
