
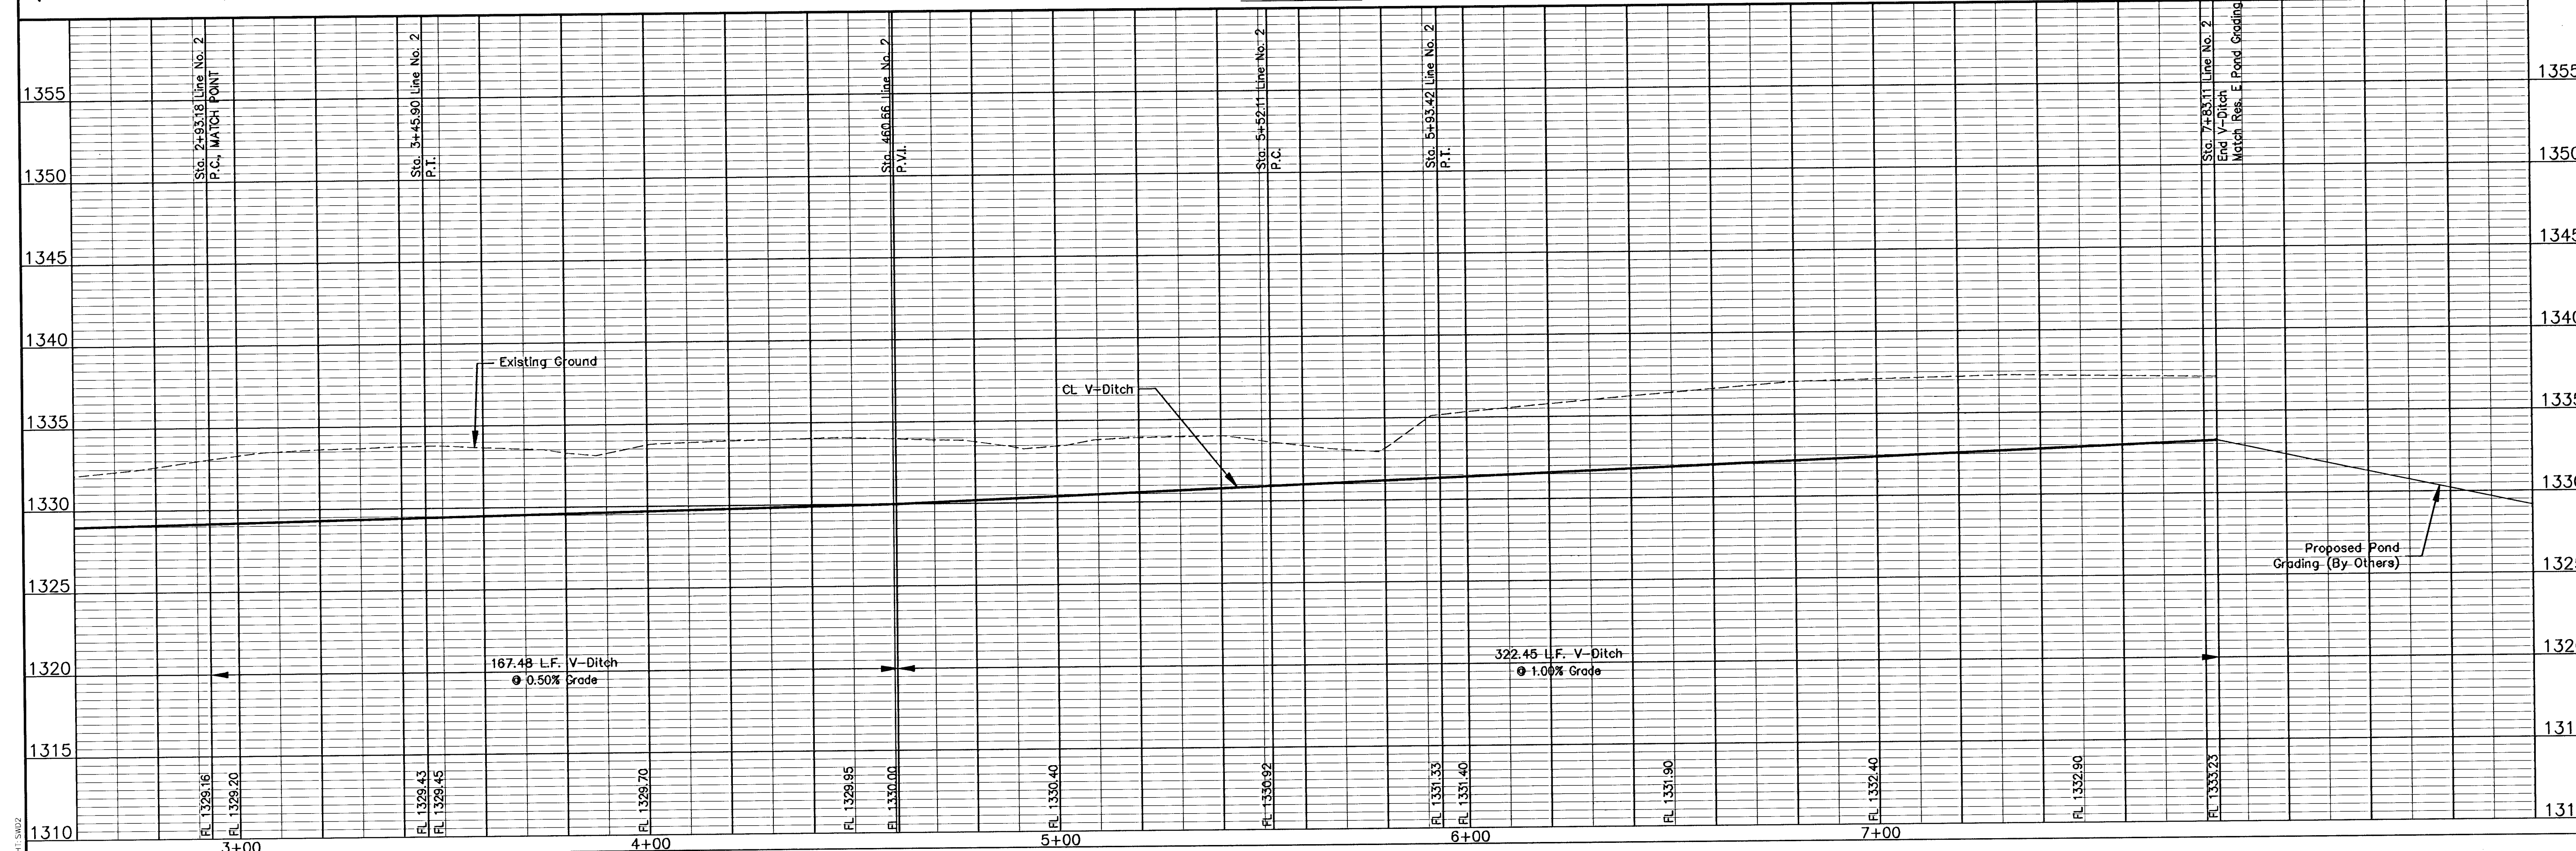
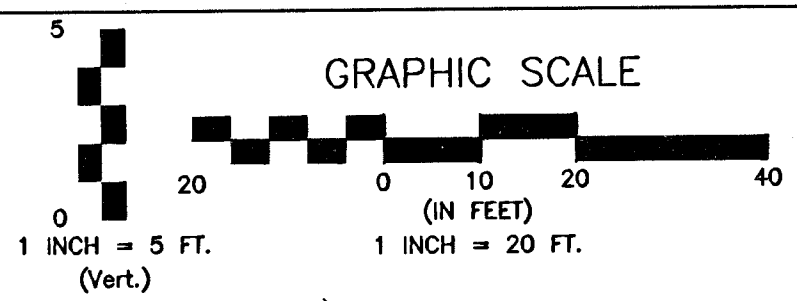


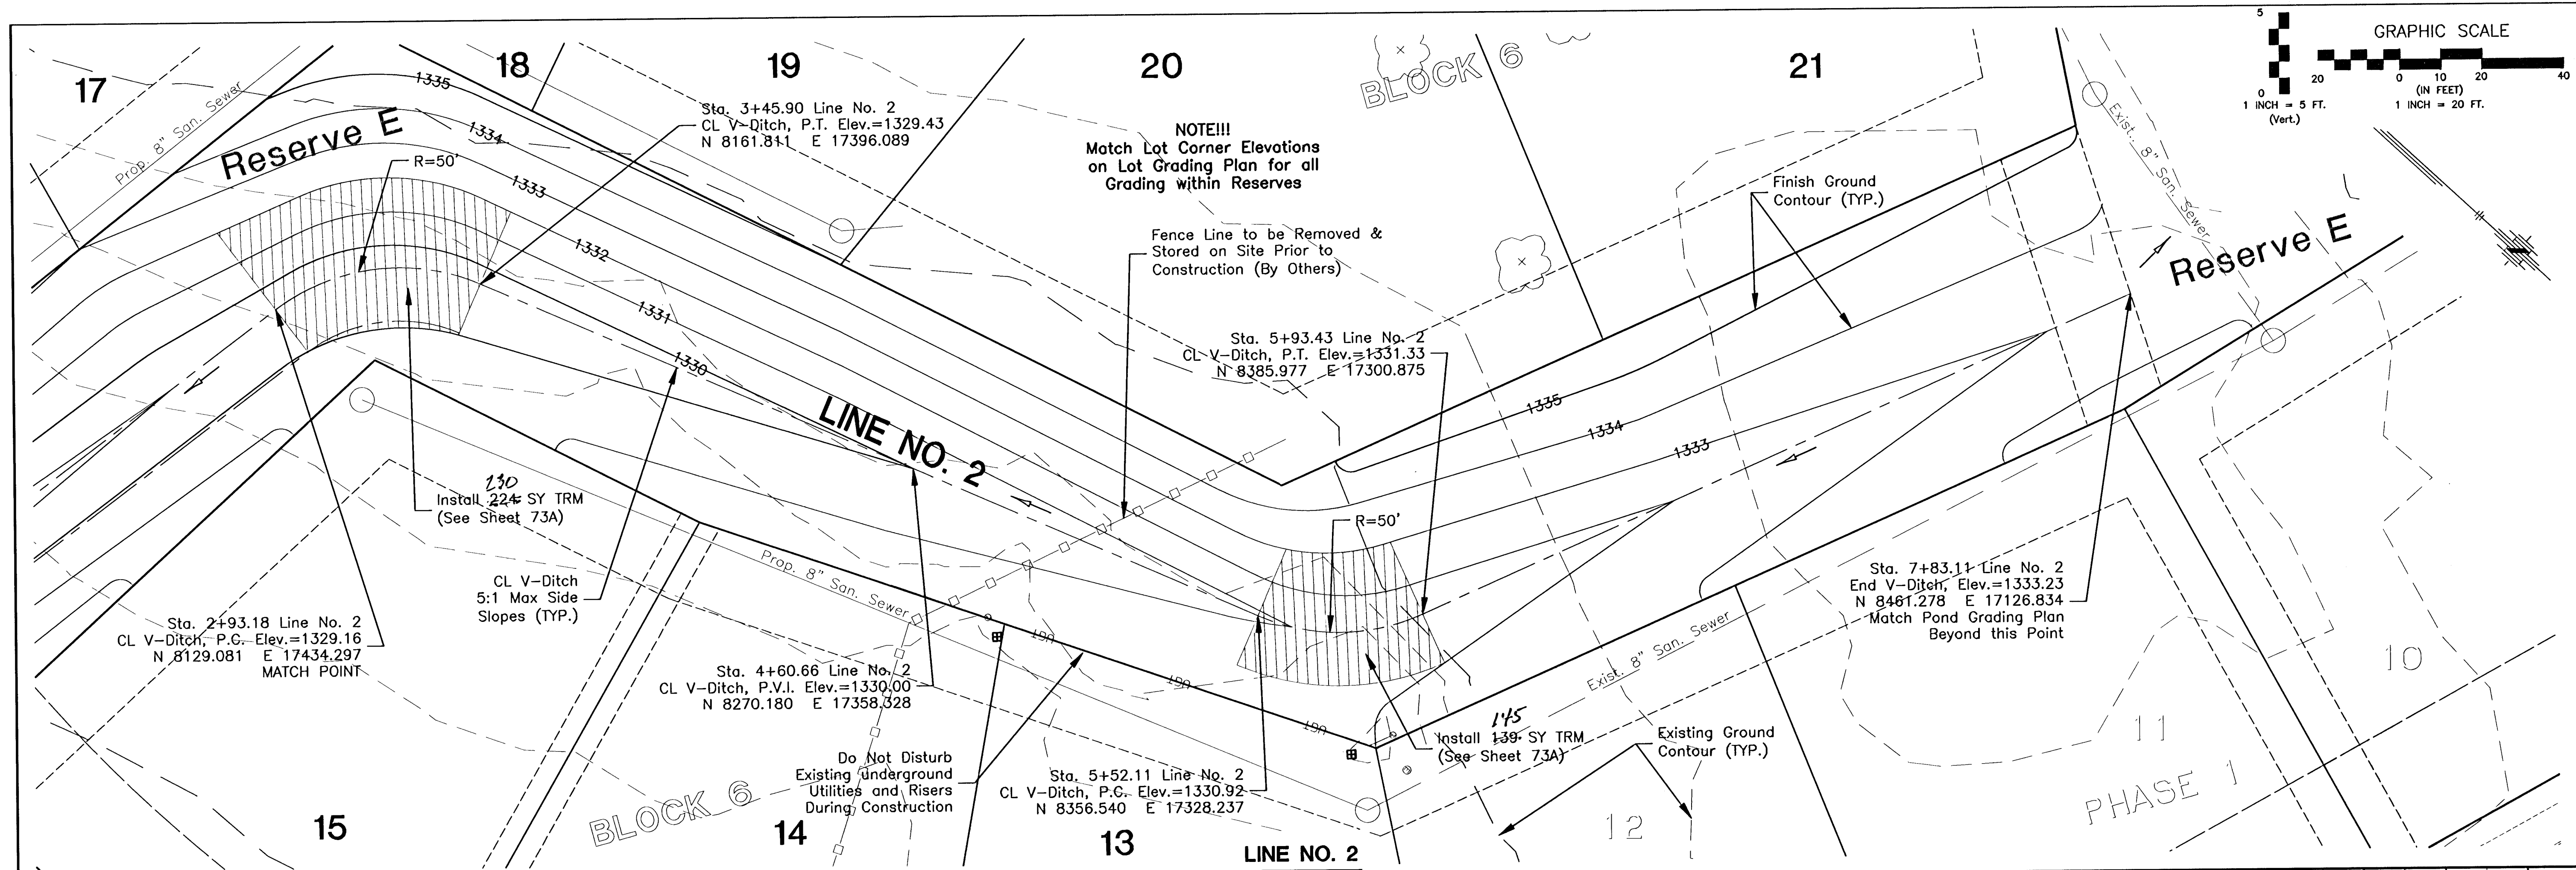

Revision	
No.	Date
1	
2	
3	
4	
5	

EQUESTRIAN ESTATES ADDITION - PHASE 2
STORM WATER SEWER
LINE NUMBER 2
CITY OF WICHITA, KANSAS
JAMES L. ARMOUR, P.E. - CITY ENGINEER
C.O.N. Proj# 472-83430 O.C.A.# 765869

POE & ASSOCIATES, INC.
CONSULTING ENGINEERS
5940 E. Central, Suite 200 - Wichita, KS 67208-4242
Phone 316/685-4114 FAX 316/685-4444

FINAL

Designed By: JMU/JPD
Drawn By: JPD
Poe Job No.: 1694J
Date: January 2006

Sheet
15 of 78