
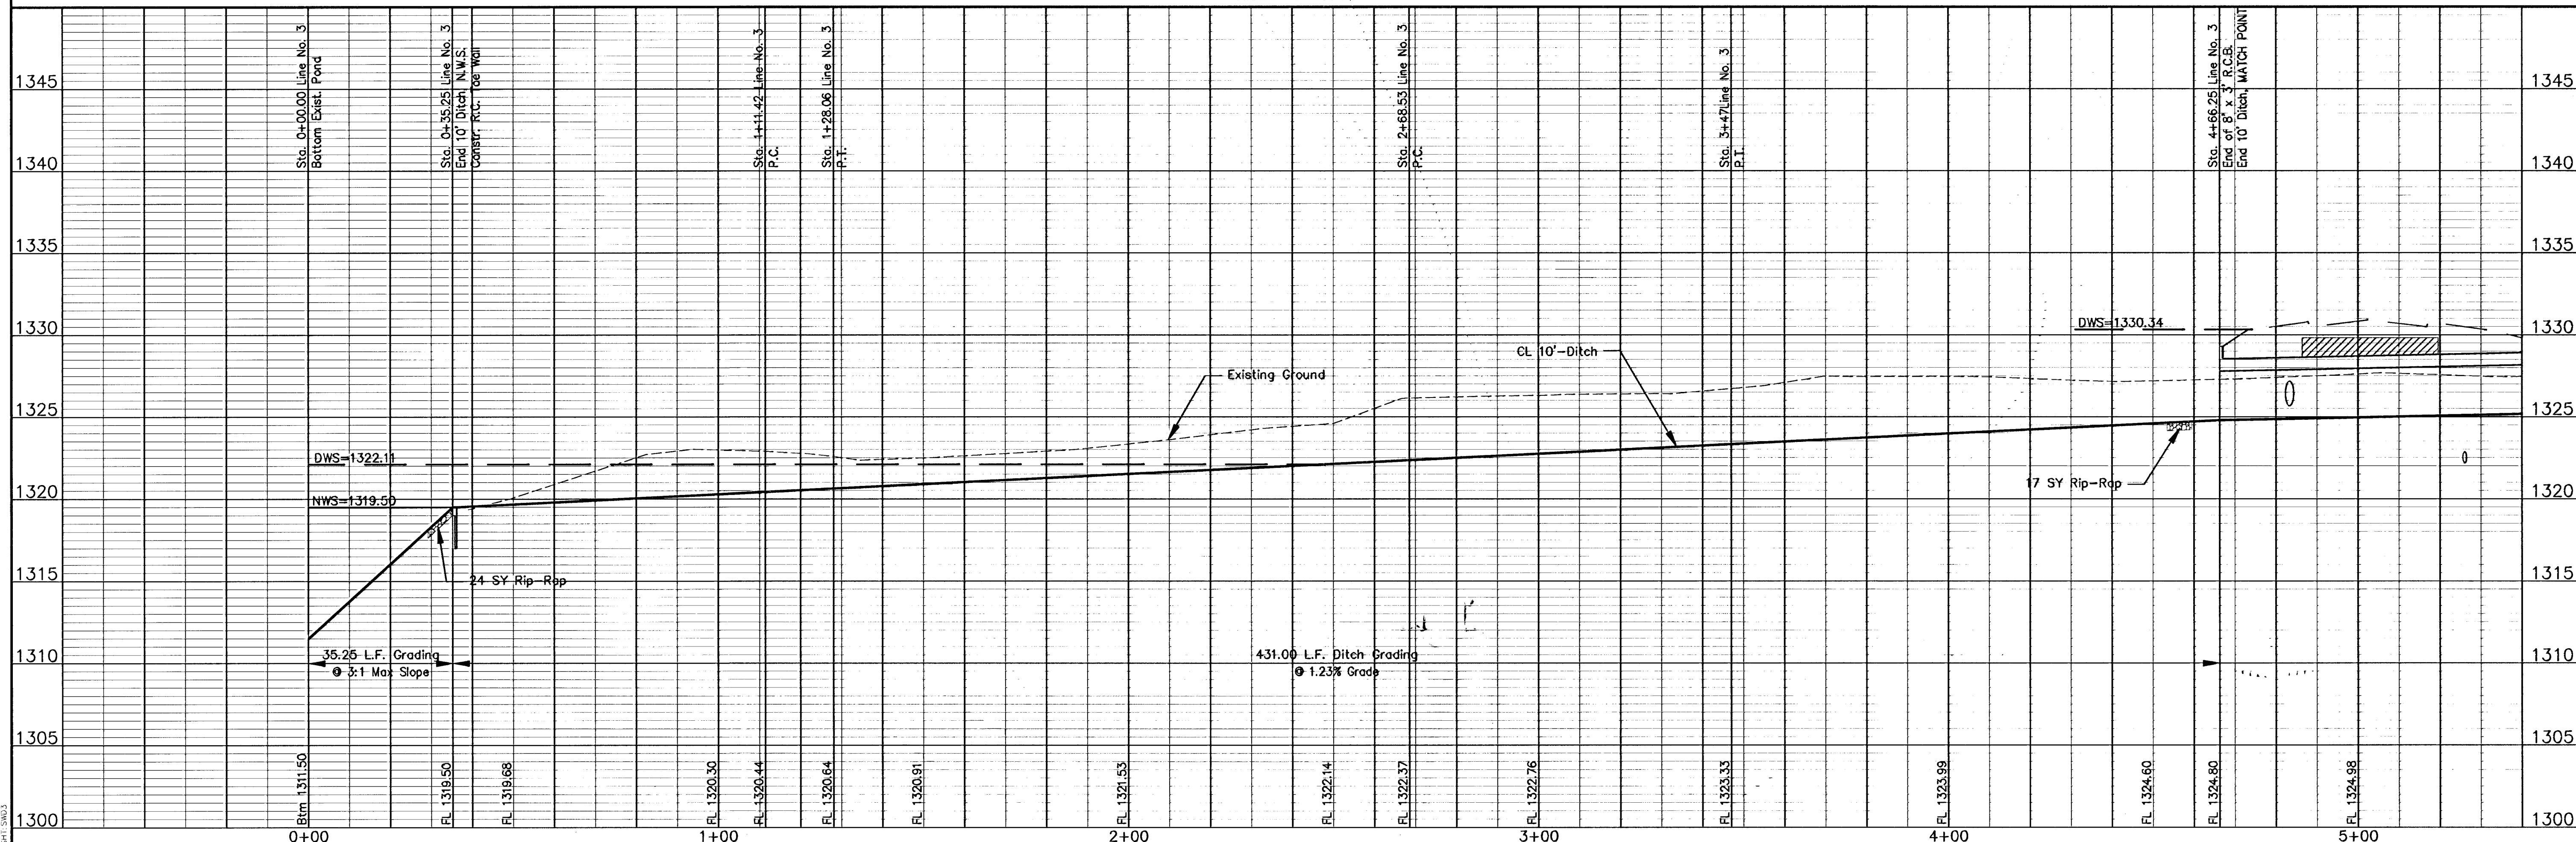


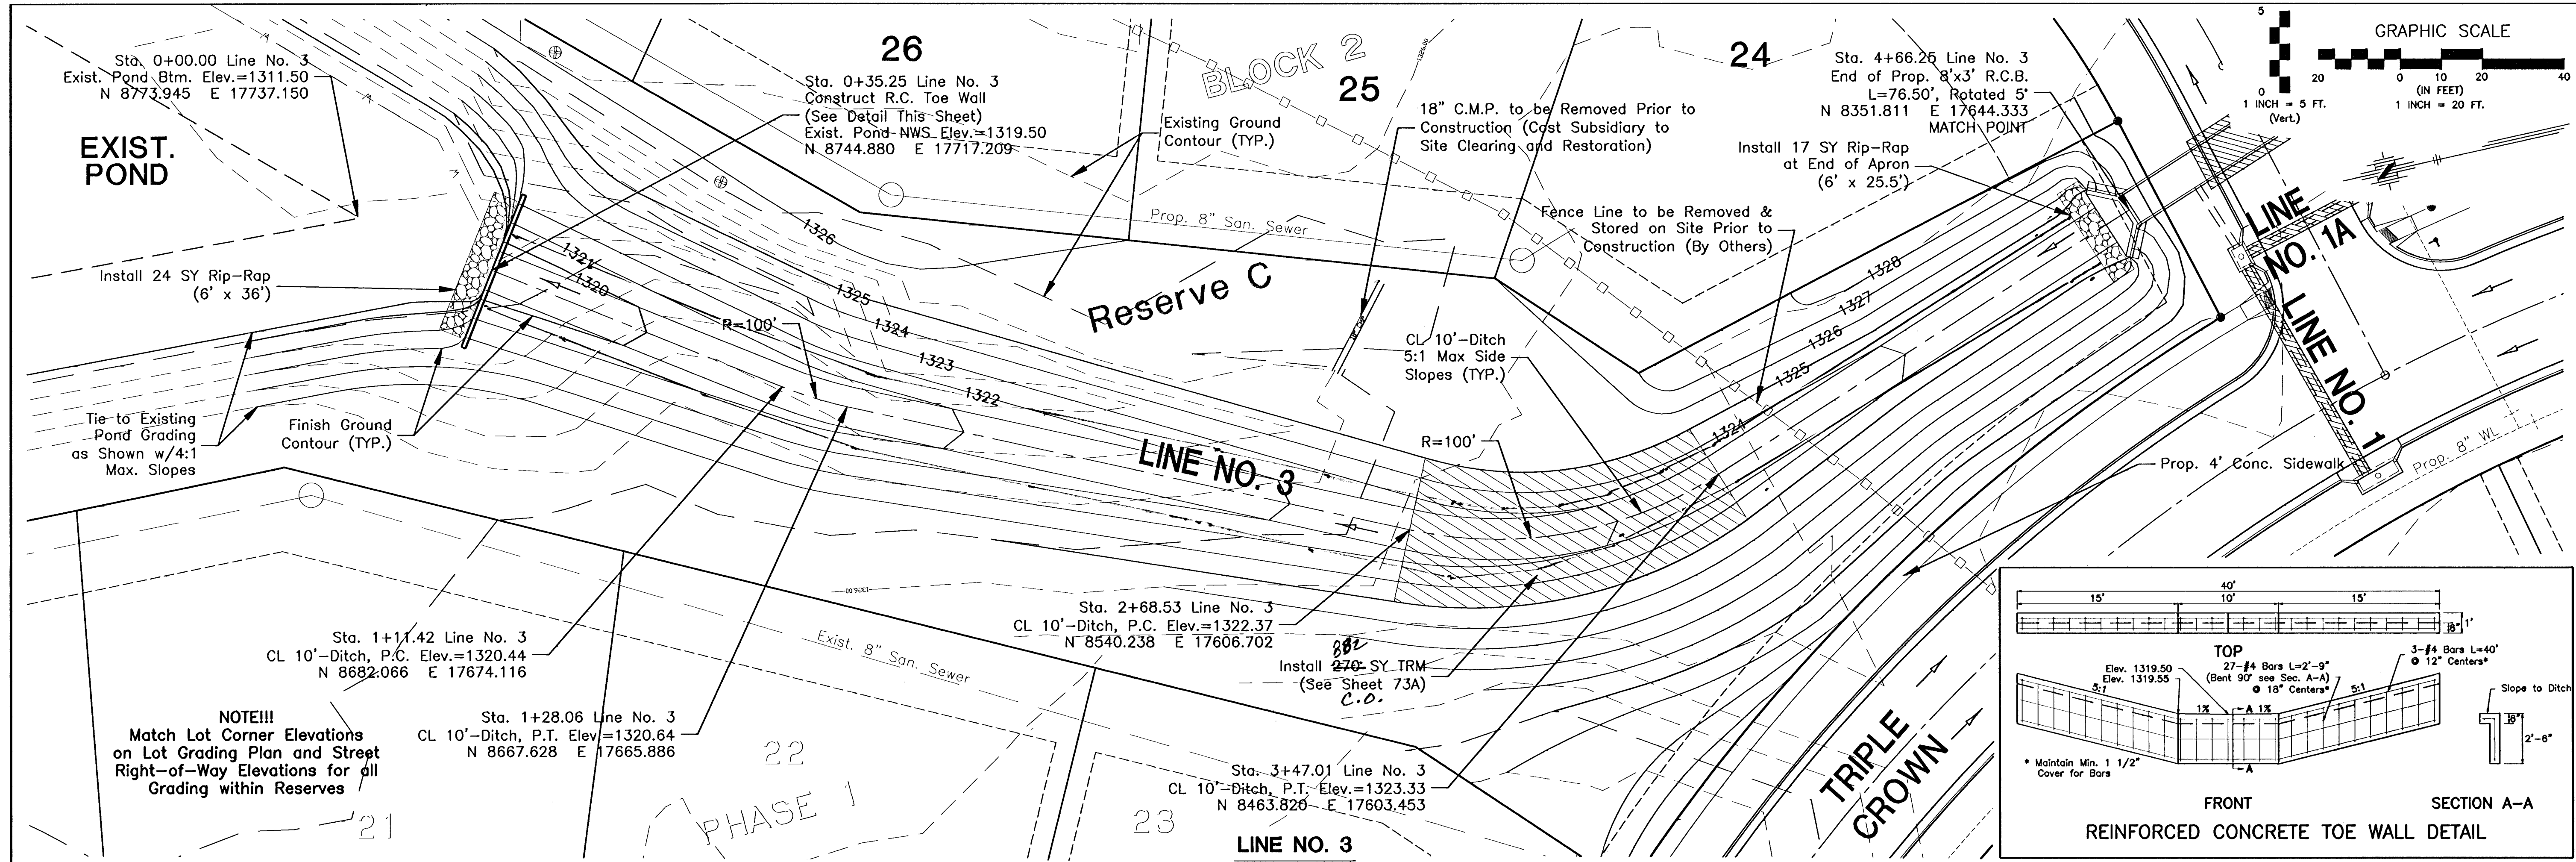

EQUESTRIAN ESTATES ADDITION - PHASE 2	
STORM WATER SEWER	
LINE NUMBER 3	
CITY OF WICHITA, KANSAS	
JAMES L. ARMOUR, P.E. - CITY ENGINEER	
C.O.W. Proj# 472-83430 O.C.A.# 765969	
Revision	
By	
Date	
No.	

POE & ASSOCIATES, INC.
CONSULTING ENGINEERS
5940 E. Central, Suite 200 ■ Wichita, KS 67208-4242
Phone 316/685-4114 ■ FAX 316/685-4444

FINAL

Designed By: JMU/JPD
Drawn By: JPD
Poe Job No.: 1694J
Date: January 2006

Sheet
16 of 78