
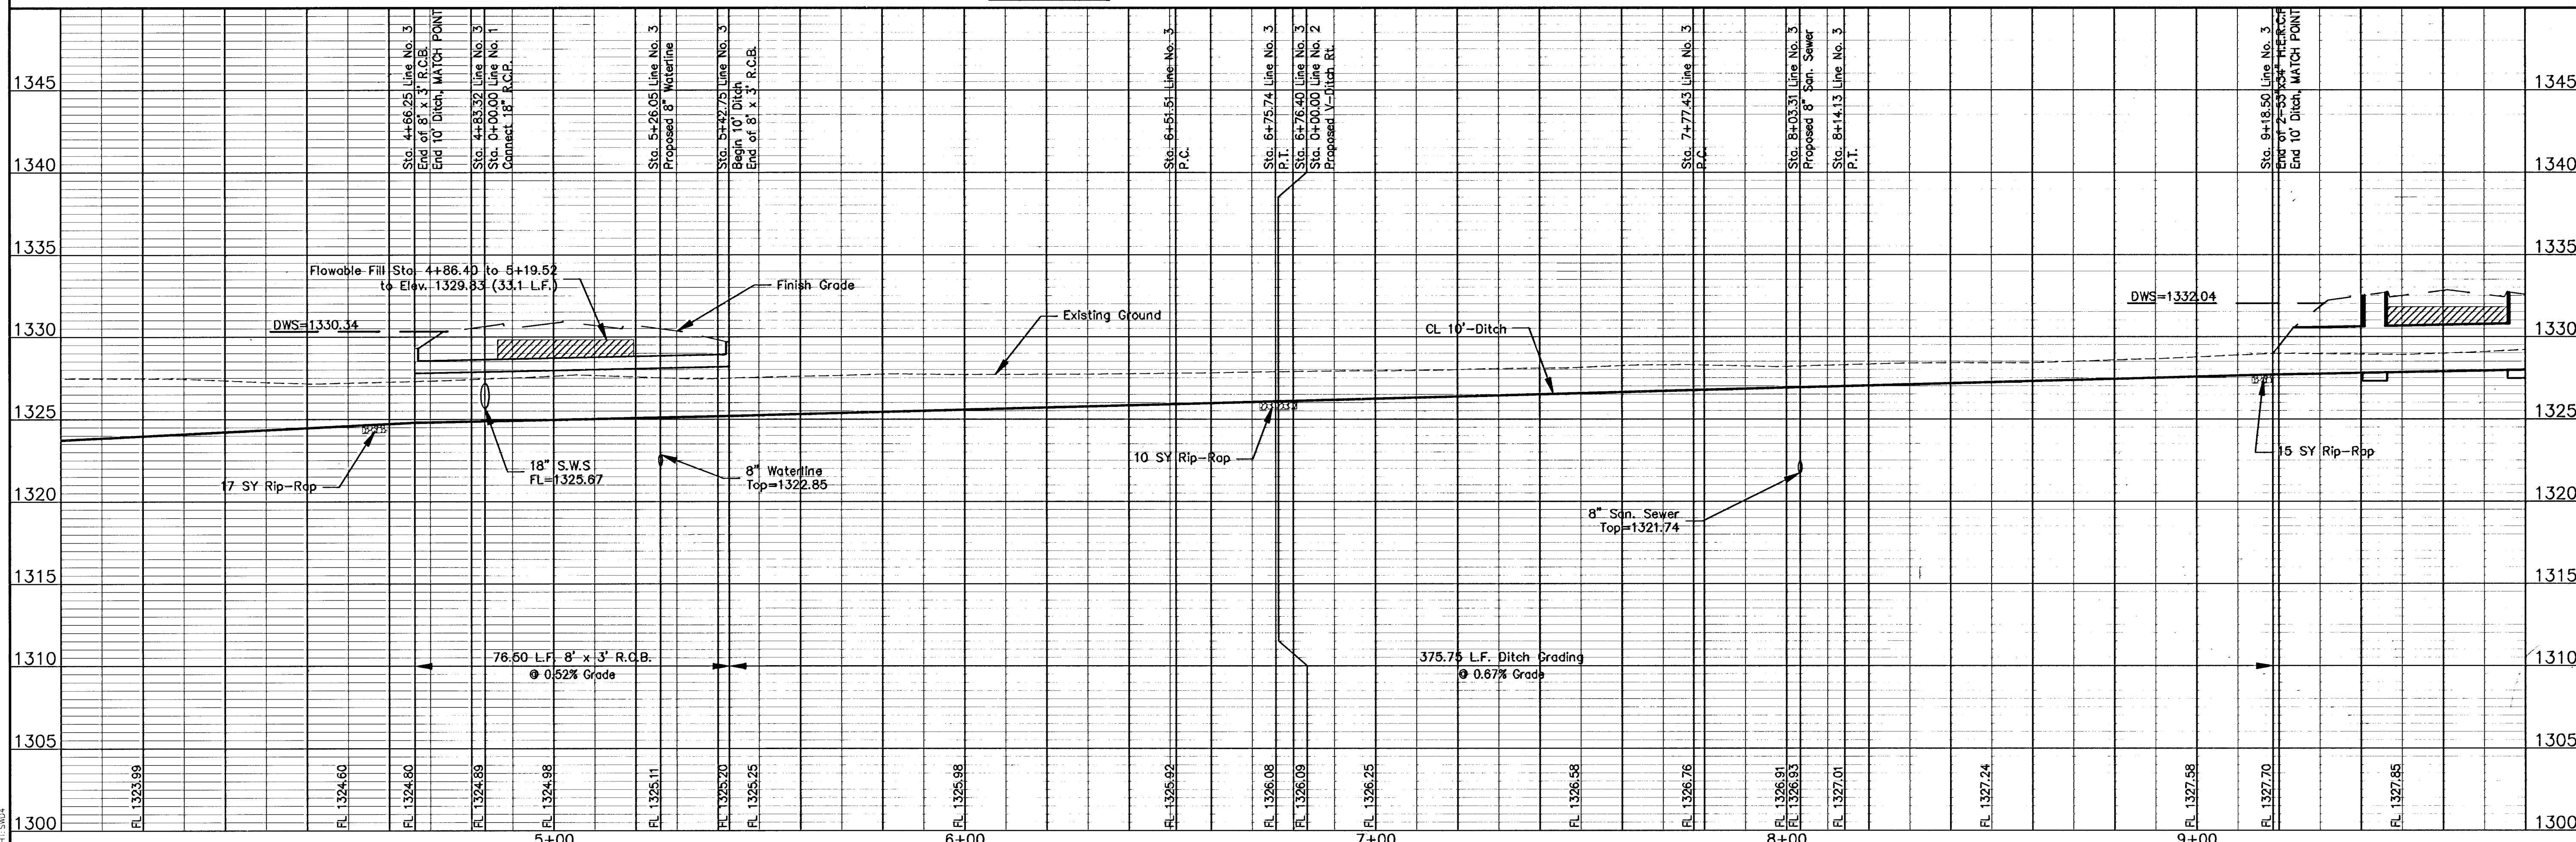


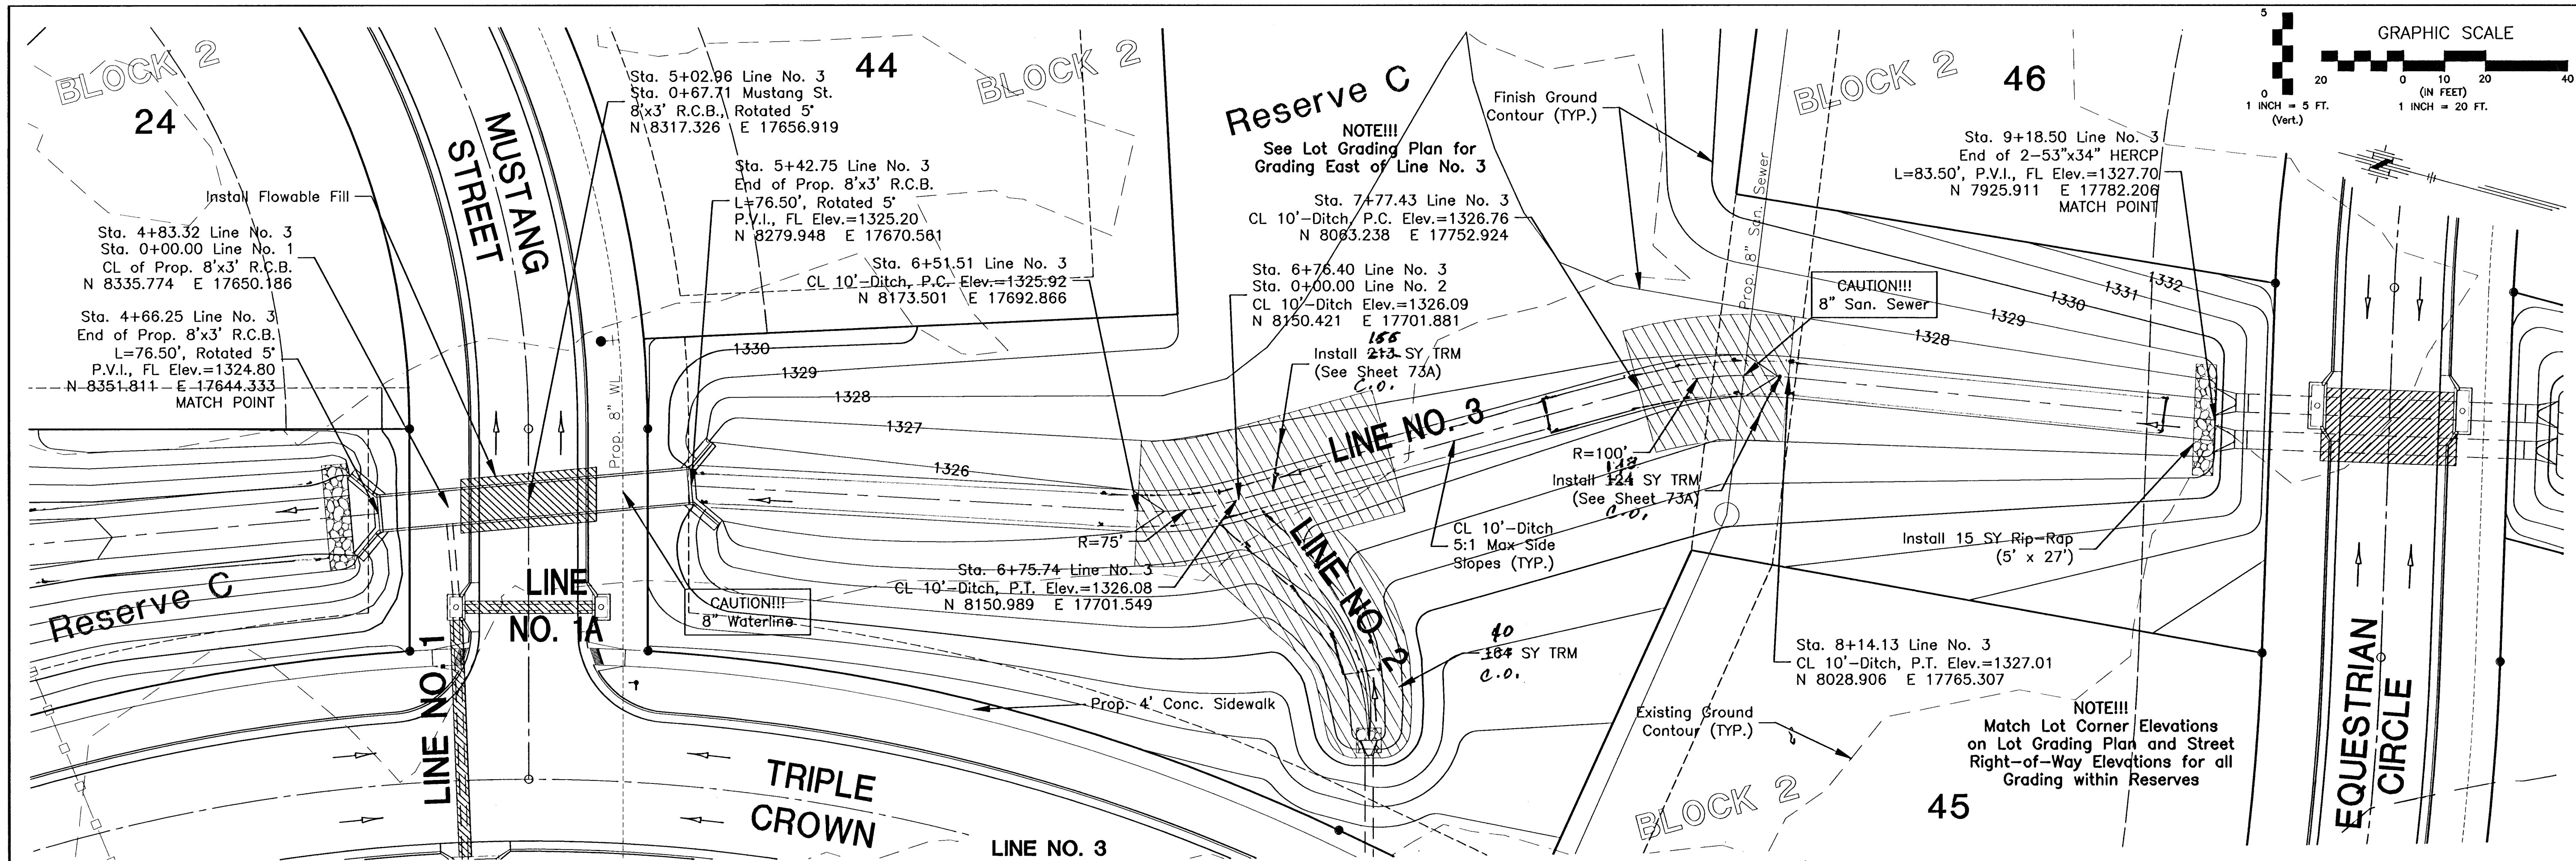

EQUESTRIAN ESTATES ADDITION - PHASE 2	
STORM WATER SEWER	
LINE NUMBER 3	
CITY OF WICHITA, KANSAS	
JAMES L. ANOUR, P.E. - CITY ENGINEER	
C.O.W. Proj # 472-83430 O.C.A.# 765989	
POE & ASSOCIATES, INC.	
CONSULTING ENGINEERS	
5940 E. Central, Suite 200 - Wichita, KS 67208-4242	
Phone 316/685-4111 FAX 316/685-4444	
P&E	
FINAL	
Designed By: JMU/JPD	Sheet
Drawn By: JPD	17 of 78
Post Job No.: 1694J	
Date: January 2006	