



PROFILES
 SCALE: HORIZ. 1"=20'
 SCALE: VERT. 1"=5'

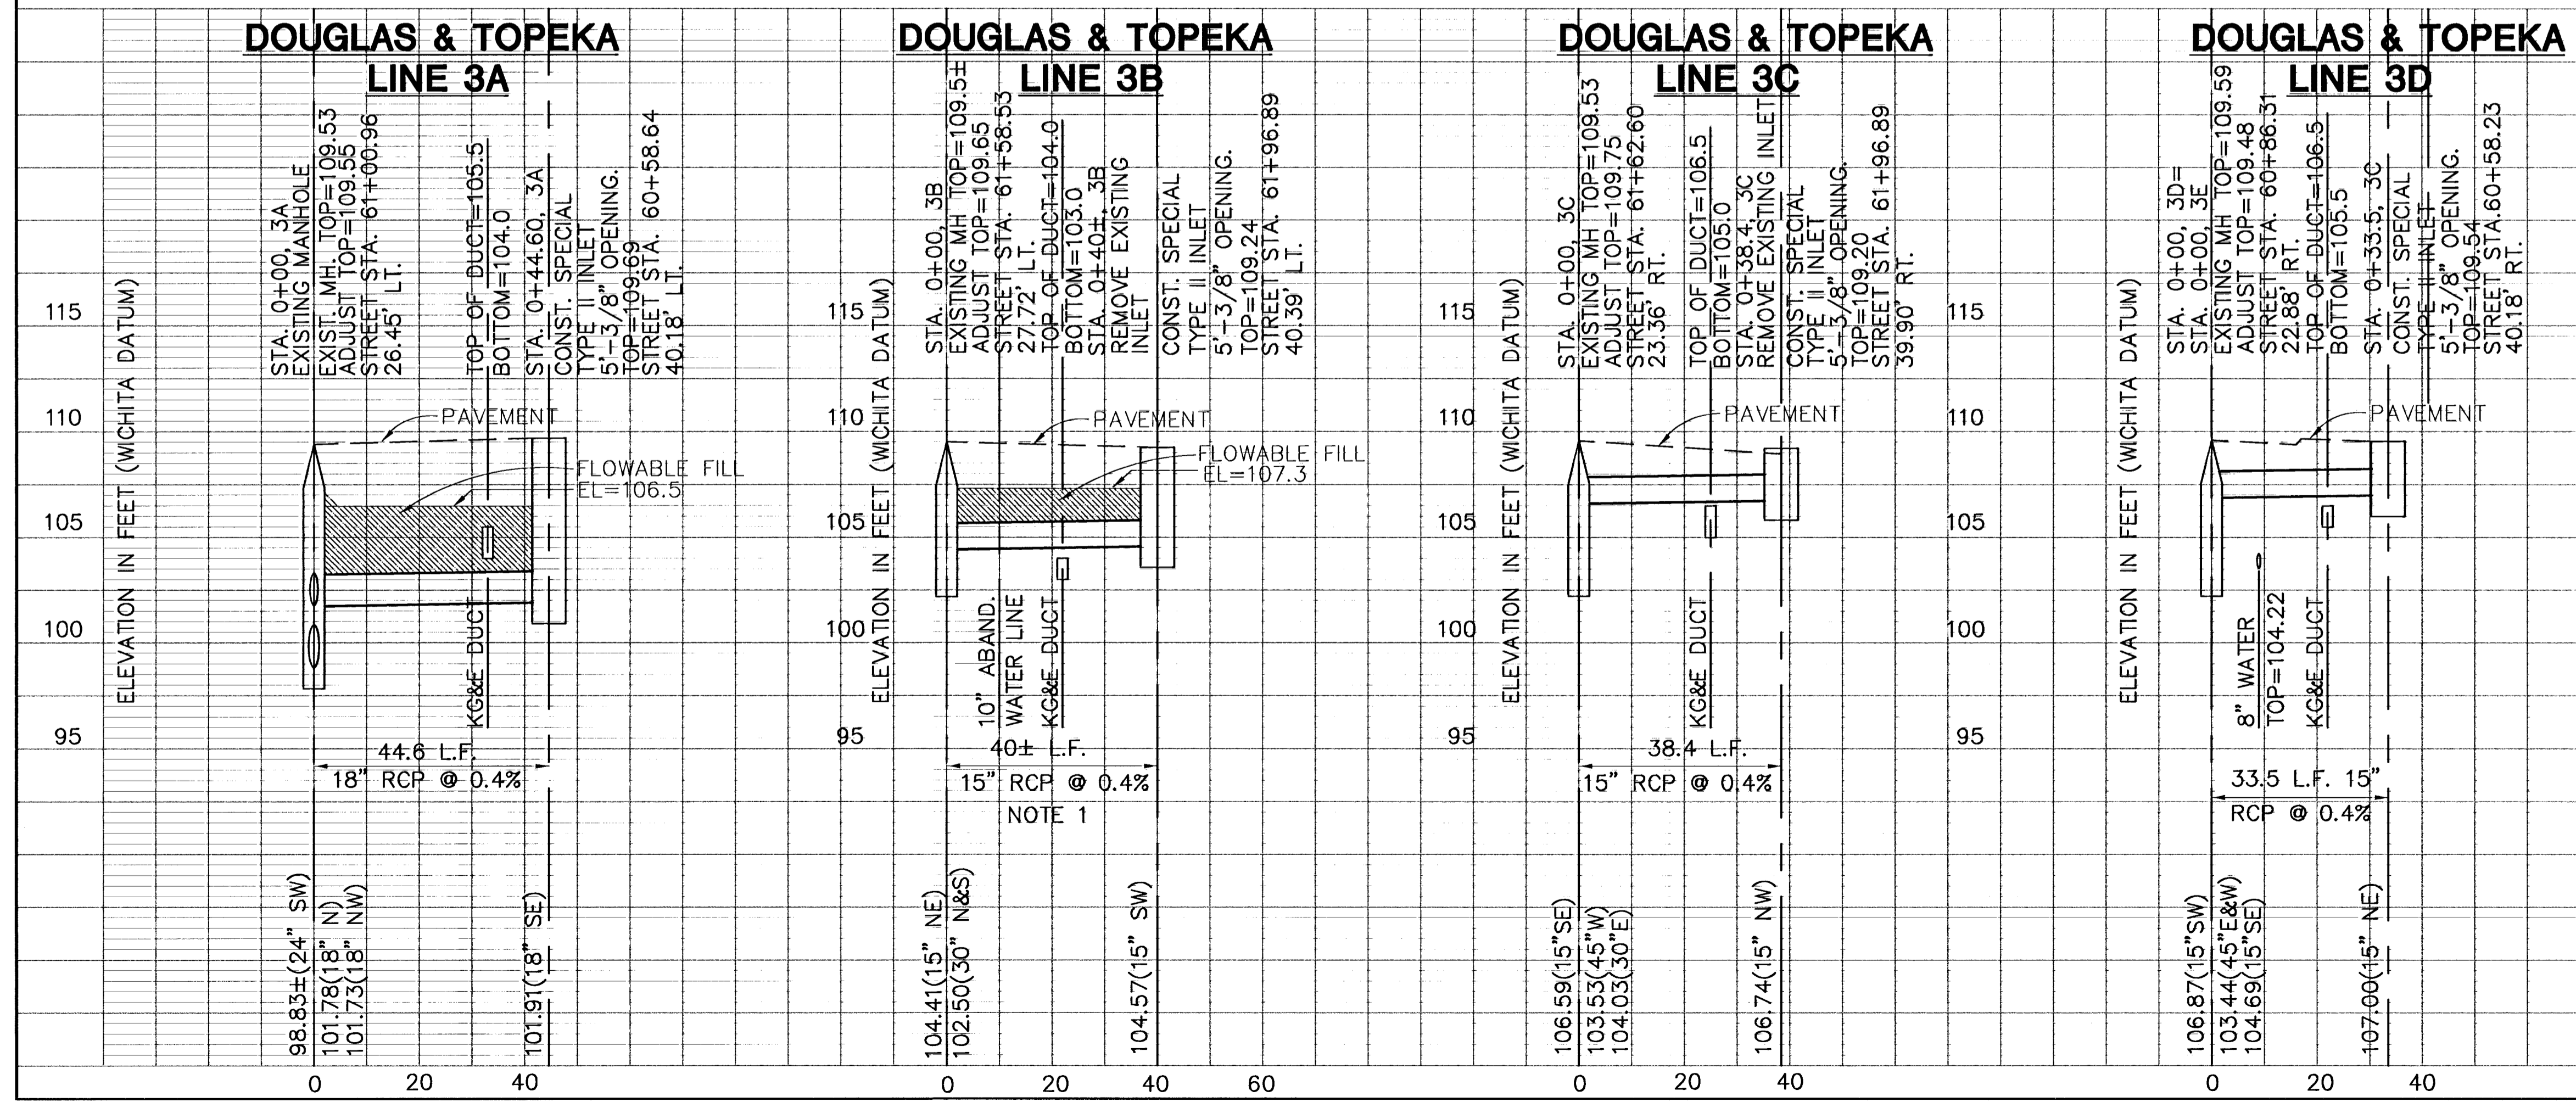

NOTES

1. LINE 3B MANHOLE LOCATIONS AND FLOWLINE ELEVATIONS ARE ESTIMATED. CONTRACTOR SHALL EXPOSE AND VERIFY LOCATIONS AND ELEVATIONS OF EXISTING PIPE AT MH LOCATIONS. NOTIFY ENGINEER OF ANY DISCREPANCY.
2. KG&E DUCT ELEVATIONS SHOWN ARE FROM BEST RECORDS AVAILABLE FOR DESIGN. CONTRACTOR SHALL EXPOSE & VERIFY. NOTIFY ENGINEER OF ANY DISCREPANCY.
3. ADJUST LINE 1B, 2B, & 3D CURB LOCATIONS & RCP LENGTHS PER DIMENSION CHANGES SHOWN ON SHEET 7.

REVISED 4/99

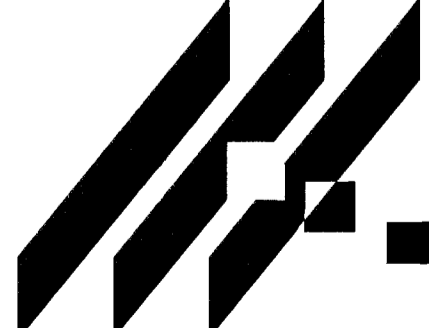

STREETSCAPES
PROJECT NAME

STORM WATER SEWER PROFILES
SHEET TITLE

MID-KANSAS ENGINEERING CONSULTANTS, INC.
411 N. WEBB ROAD
WICHITA, KS. 67206
316-684-9600

DCH DESIGN BY: ALN DRAWN BY: RLB CHECKED BY:
 Oct. 1995 DATE: 92010 JOB NO. 12/61 SHEET/OF