


PARKING LOT ELECTRICAL

FEEDER SCHEDULE						
FEEDER IDENT.	QUANT.		CONDUCTORS		GROUND	
SETS	PER SET	SIZE	SIZE	PER SET	SIZE	PER SET
1	1	4	#6 THHN	#6	1"	
2	1	5	#6 THHN	#6	1"	
3	1	6	#6 THHN	#6	1 1/4"	
4	1	2	#6 THHN	#6	1"	
5	1	2	#12 THHN	#12	3/4"	
6	1	2	#10 THHN	#10	3/4"	

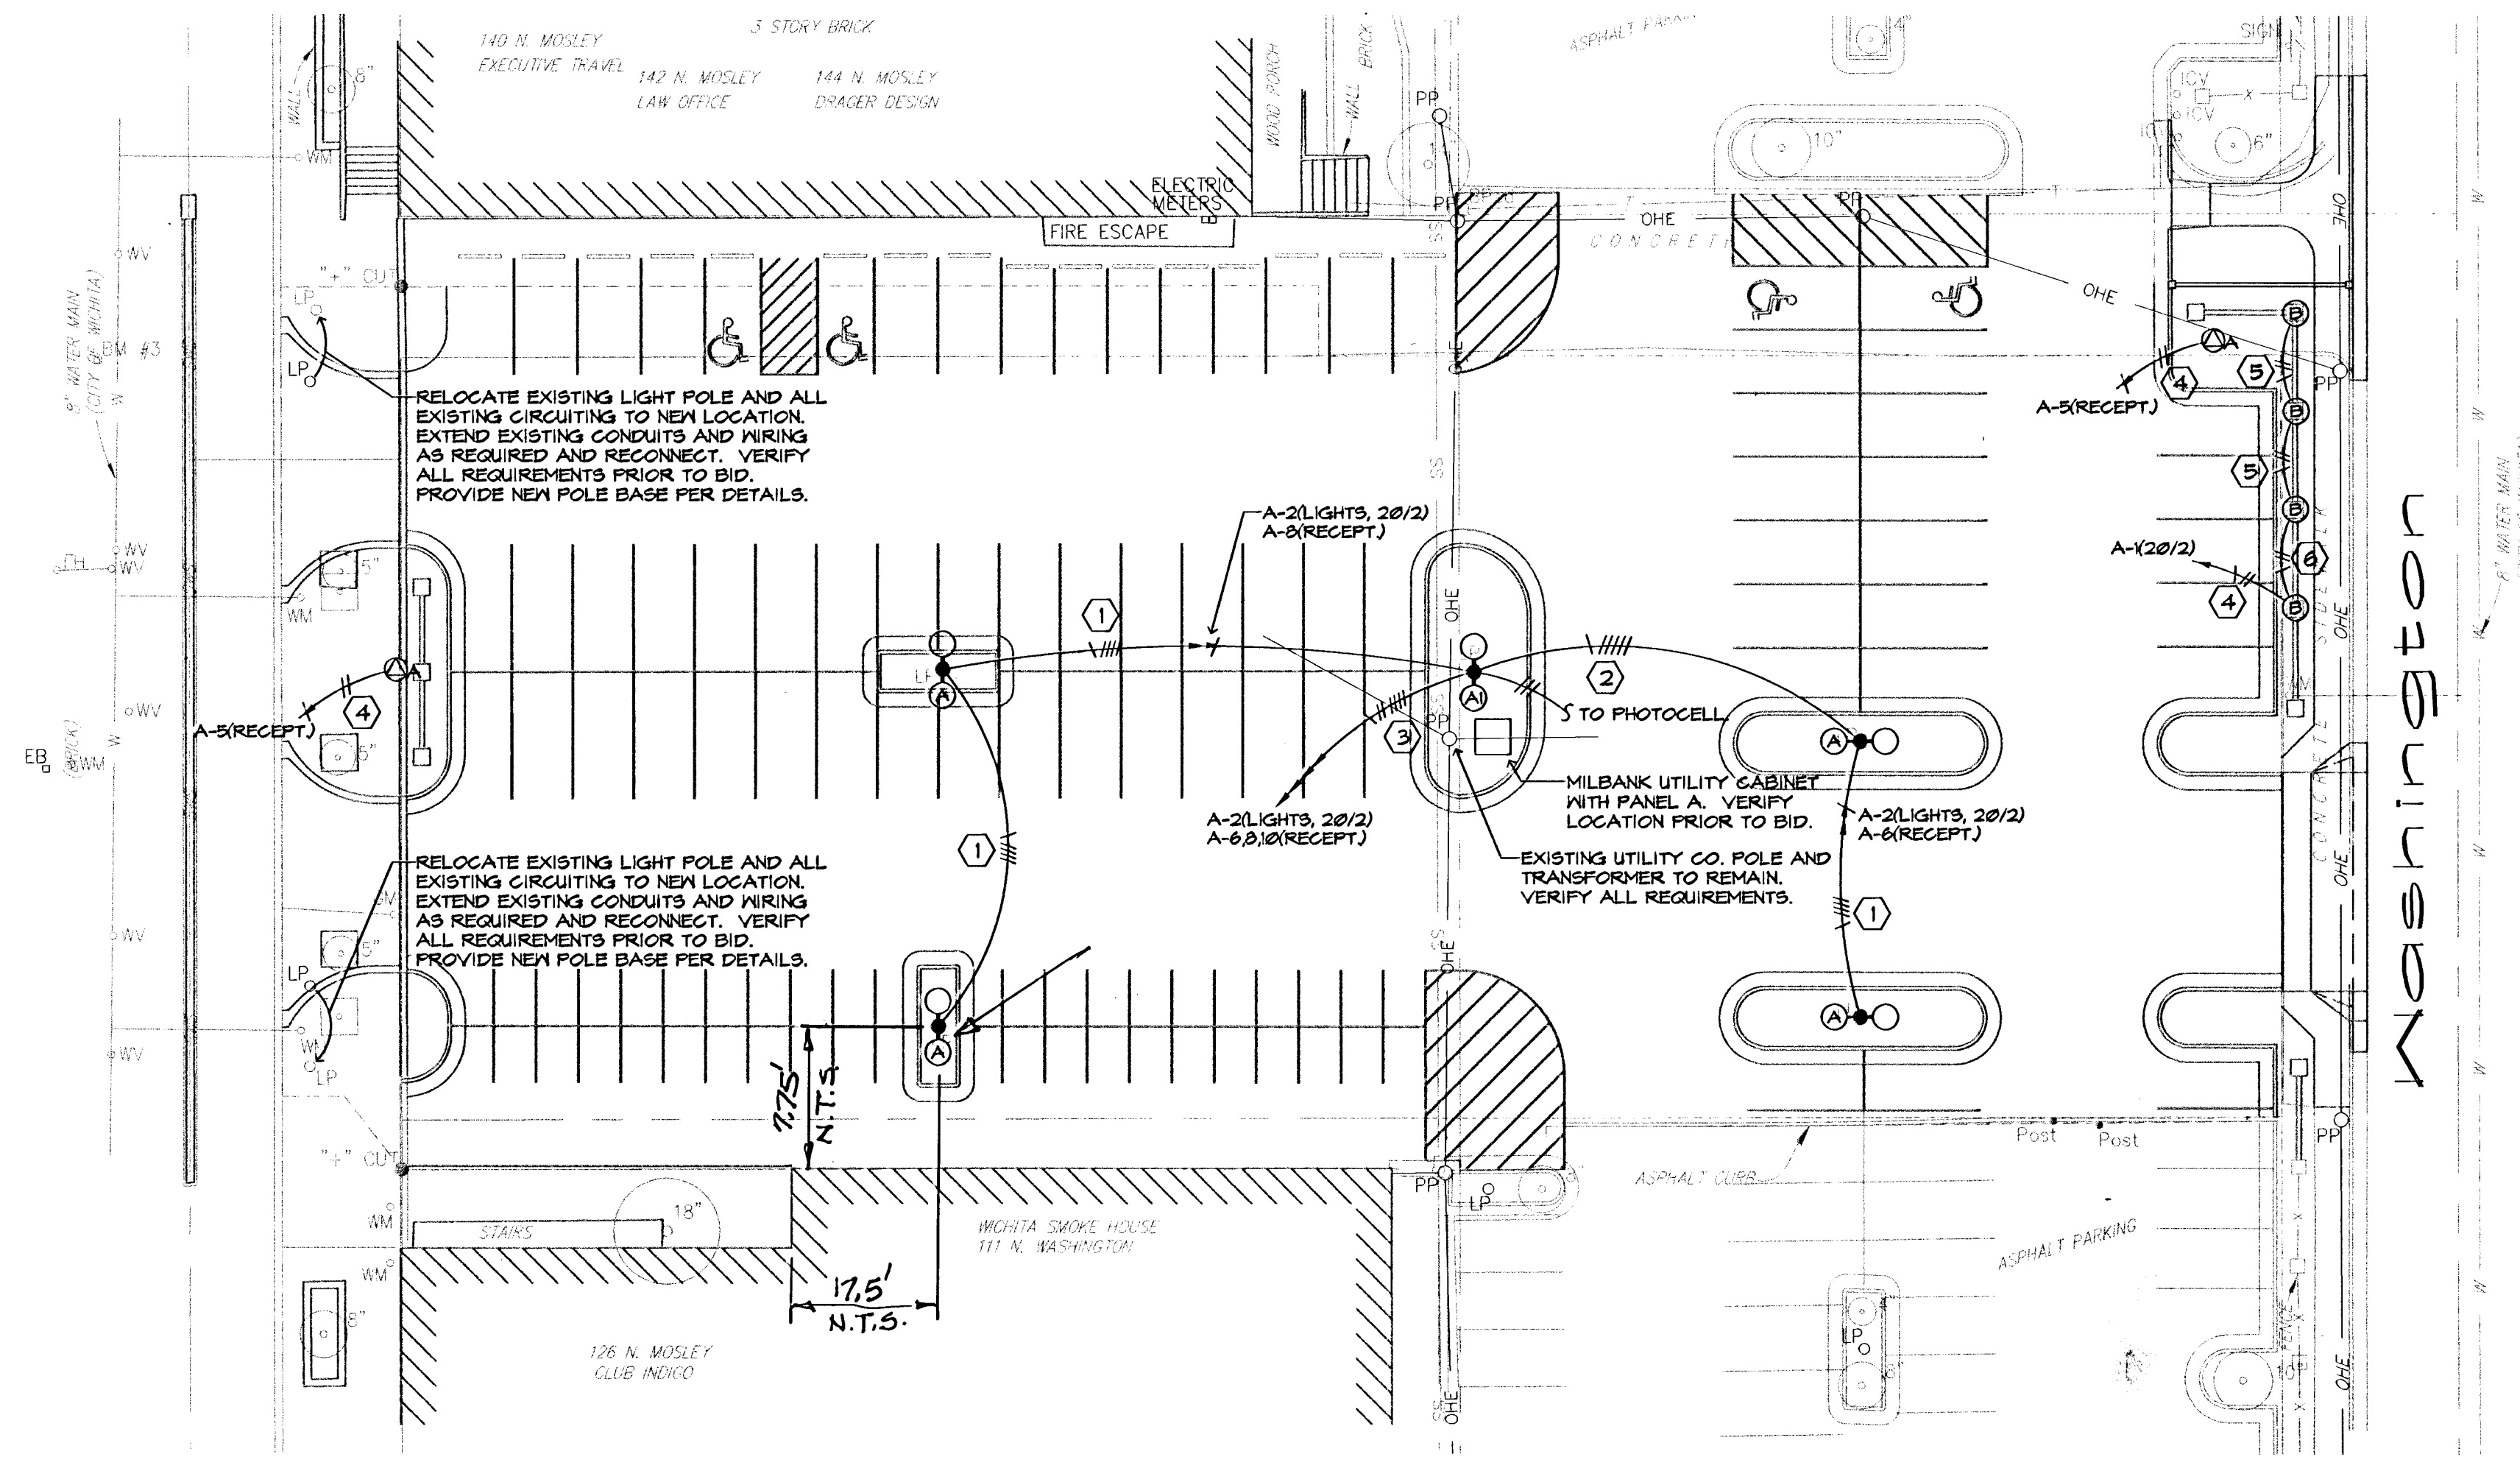


Electrical Engineering
and Design
349 S. Hydraulic
Wichita, Ks. 67211-1908
(316) 284-3061
FAX: (316) 284-3542

REVISED 1-14-04

03086-041

PUBLIC PARKING LOT IMPROVEMENTS, 132 N. MOSLEY ELECTRICAL SITE PLAN WICHITA, KANSAS

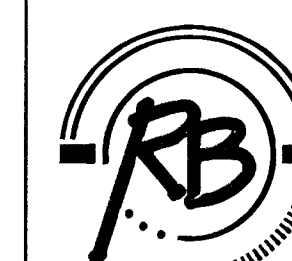

Ruggles & Bohm, P.A.
Engineering, Surveying, Land Planning

924 North Main
Wichita, Kansas 67203
www.rbkansas.com

(316) 284-8008
(316) 284-4621 fax
E-mail: info@rbkansas.com
472-85846

DRAWING FILE
3086E03.DWG

PROJECT NUMBER
[REDACTED]

DESIGN	SVA	SHEET 11 OF 11
DRAWN	SVA	
REVIEW		
UTILITY		
DATE	July 18, 2003	

PLAN NOTES:

1. REFER TO SHEET 10 FOR ALL CONTROL AND DISTRIBUTION REQUIREMENTS, REFER TO SHEET 1 FOR ALL LIGHT FIXTURES, BASE AND SPECIAL OUTLET "A" REQUIREMENTS.

2. ALL CONDUCTORS TO BE CLEARLY AND PERMANENTLY MARKED AT ALL ENDS AND JUNCTION POINTS WITH PANEL DESIGNATION AND CIRCUIT NUMBER.

18-13-05-10