


REMOVE EXISTING ASPH. PAVEMENT
INSIDE OF THE FENCE IN COURTS 2,3,4 .
CONSTRUCT 3" ASPH. ON 4" REINFORCED CRUSHED ROCK.
INSTALL 3, 4" DIA PERFORATED PIPE.

**ADD EXTRA 1" ASPH. TO THE BASE BID. THE COST OF
EXTRA EXCAVATION FOR THIS ADDITIONAL 1" ASPH. IS
SUBSIDIARY TO THE OTHER BID ITEMS.**

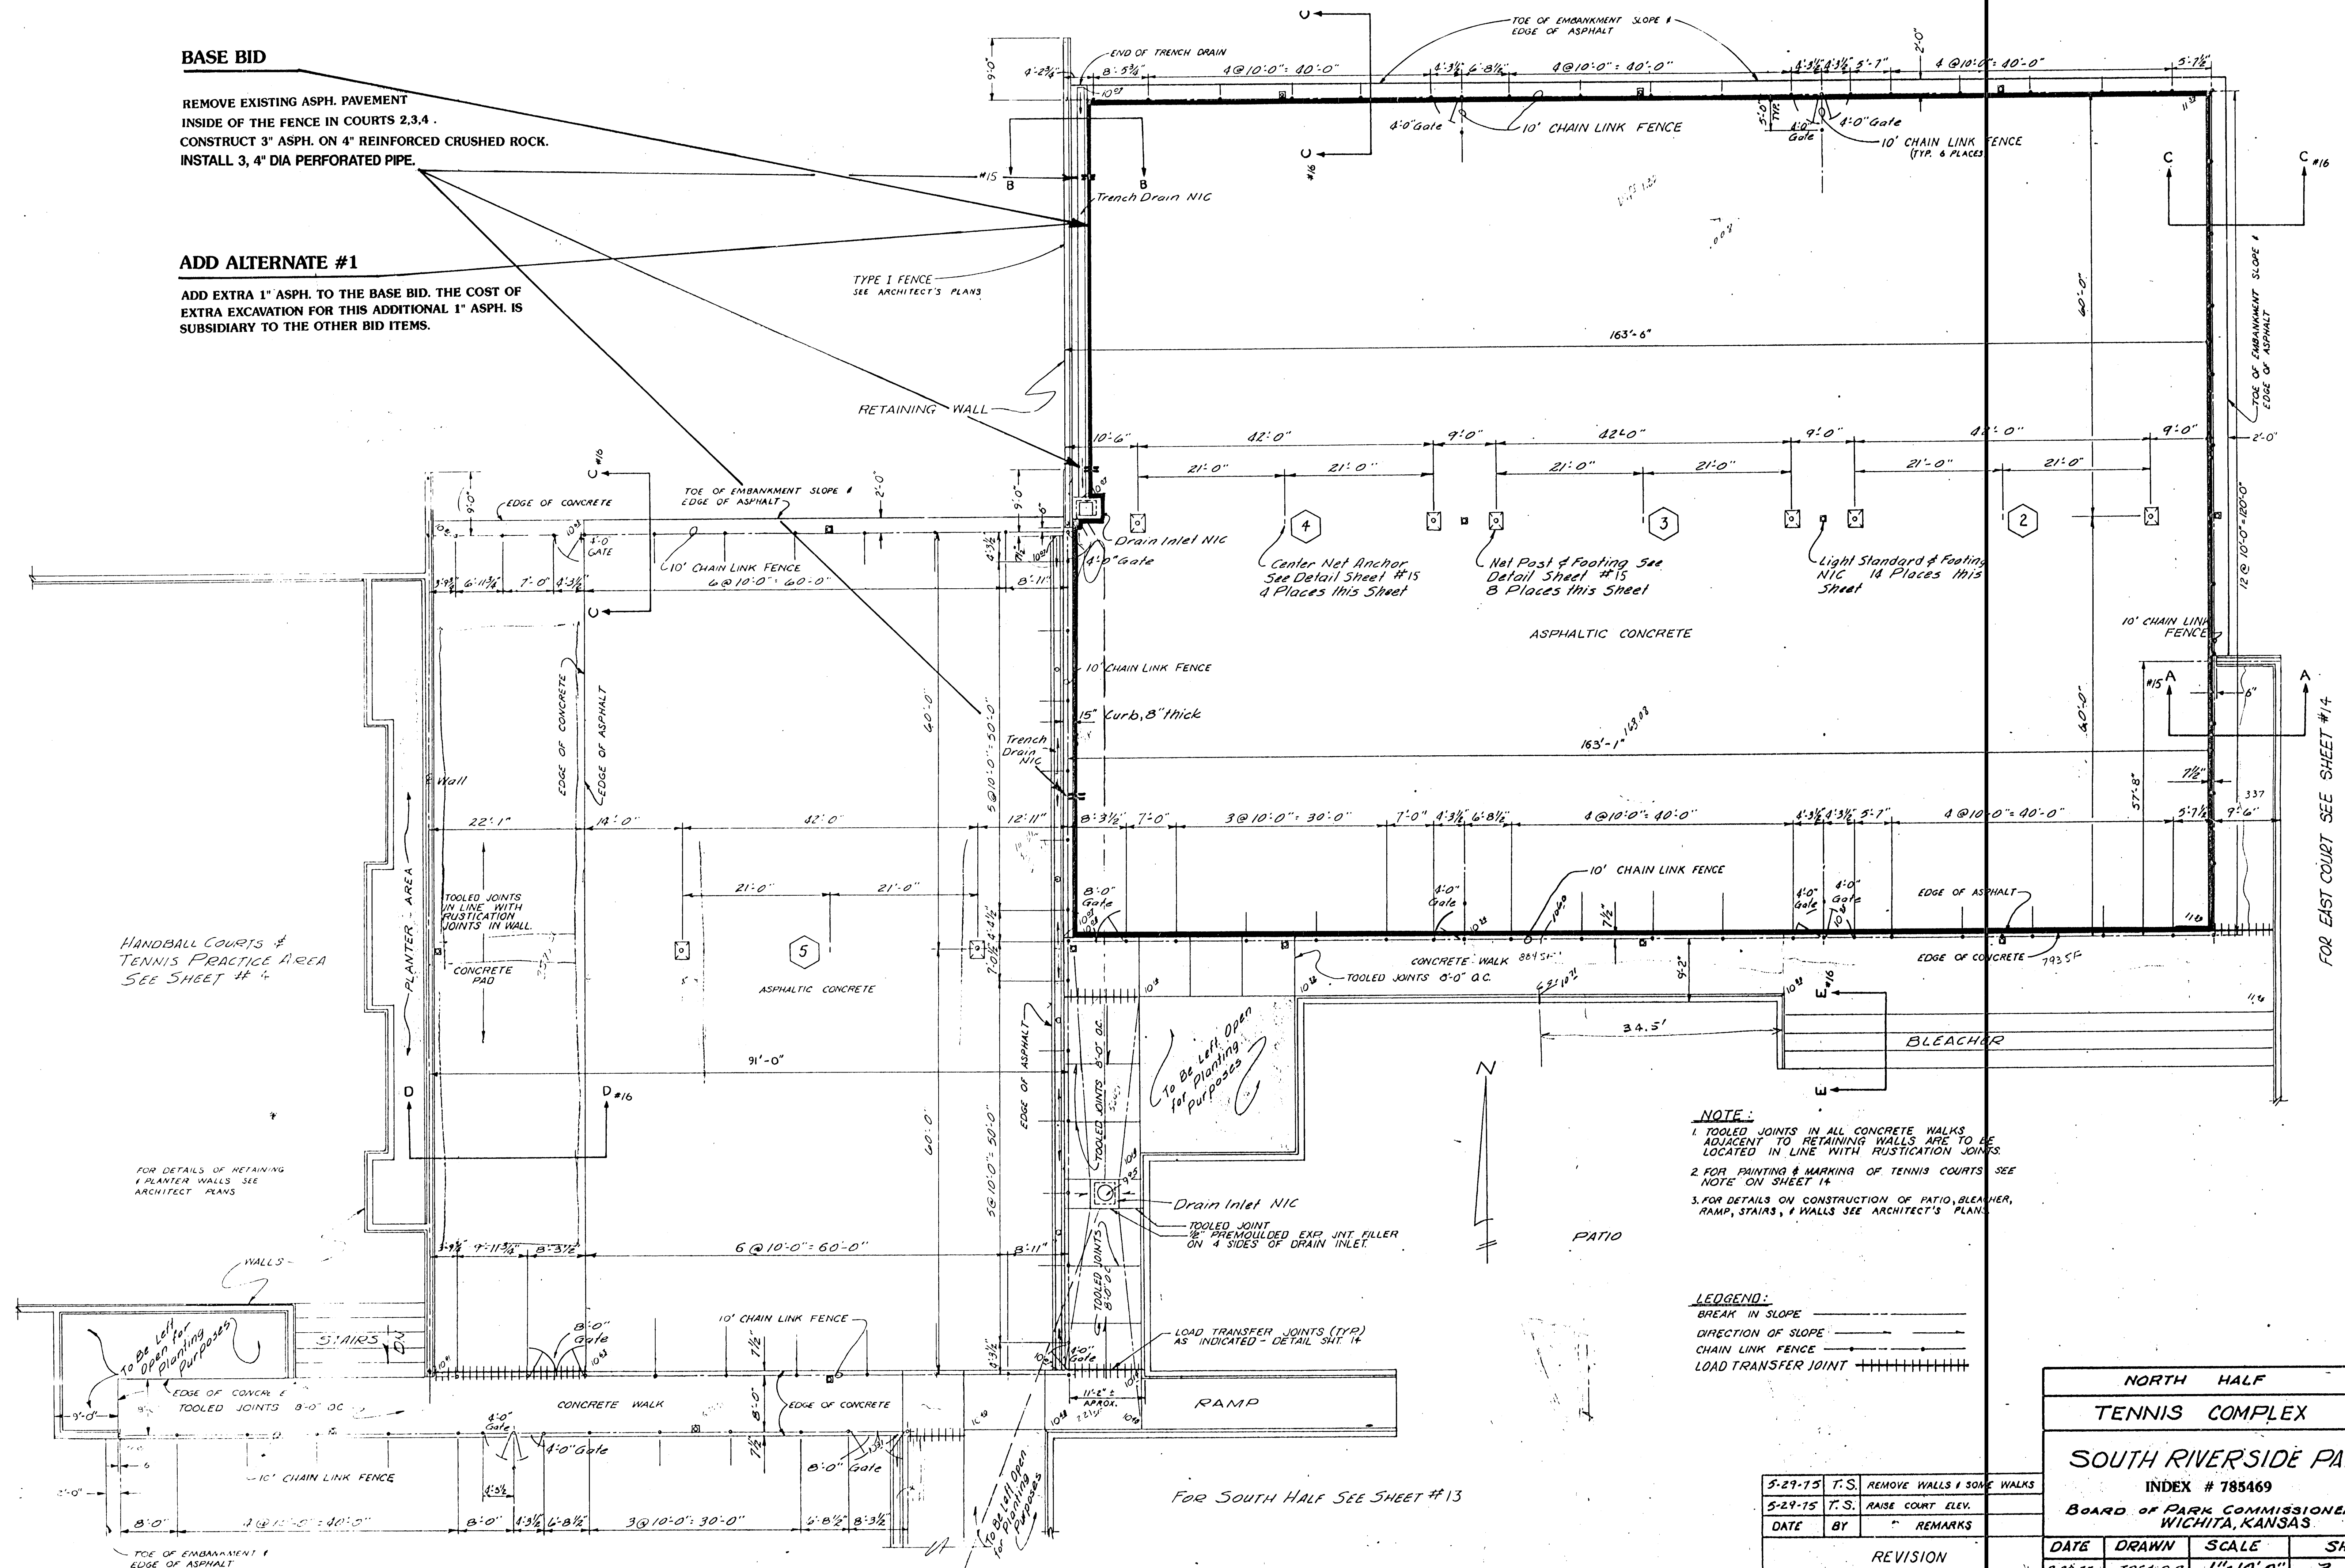

FOR EAST COURT SEE SHEET #14

NOTE:

1. TOOLED JOINTS IN ALL CONCRETE WALKS ADJACENT TO RETAINING WALLS ARE TO BE LOCATED IN LINE WITH RUSTICATION JOINTS
2. FOR PAINTING & MARKING OF TENNIS COURTS SEE NOTE ON SHEET 14
3. FOR DETAILS ON CONSTRUCTION OF PATIO, BLEACHER, RAMP, STAIRS, & WALLS SEE ARCHITECT'S PLANS.

LEGEND:

BREAK IN SLOPE ————

DIRECTION OF SLOPE —————→

CHAIN LINK FENCE —●—————●——

LOAD TRANSFER JOINT ++++++

5-29-75	T.S.	REMOVE WALLS & SOME WALKS
5-29-75	T.S.	RAISE COURT ELEV.
DATE	BY	REMARKS
REVISION		

NORTH HALF			
TENNIS COMPLEX			
SOUTH RIVERSIDE PARK			
INDEX # 785469			
BOARD OF PARK COMMISSIONERS WICHITA, KANSAS			
DATE	DRAWN	SCALE	SHEET
2-28-75	TRF & D.R.	1"=10'-0"	3 of 6