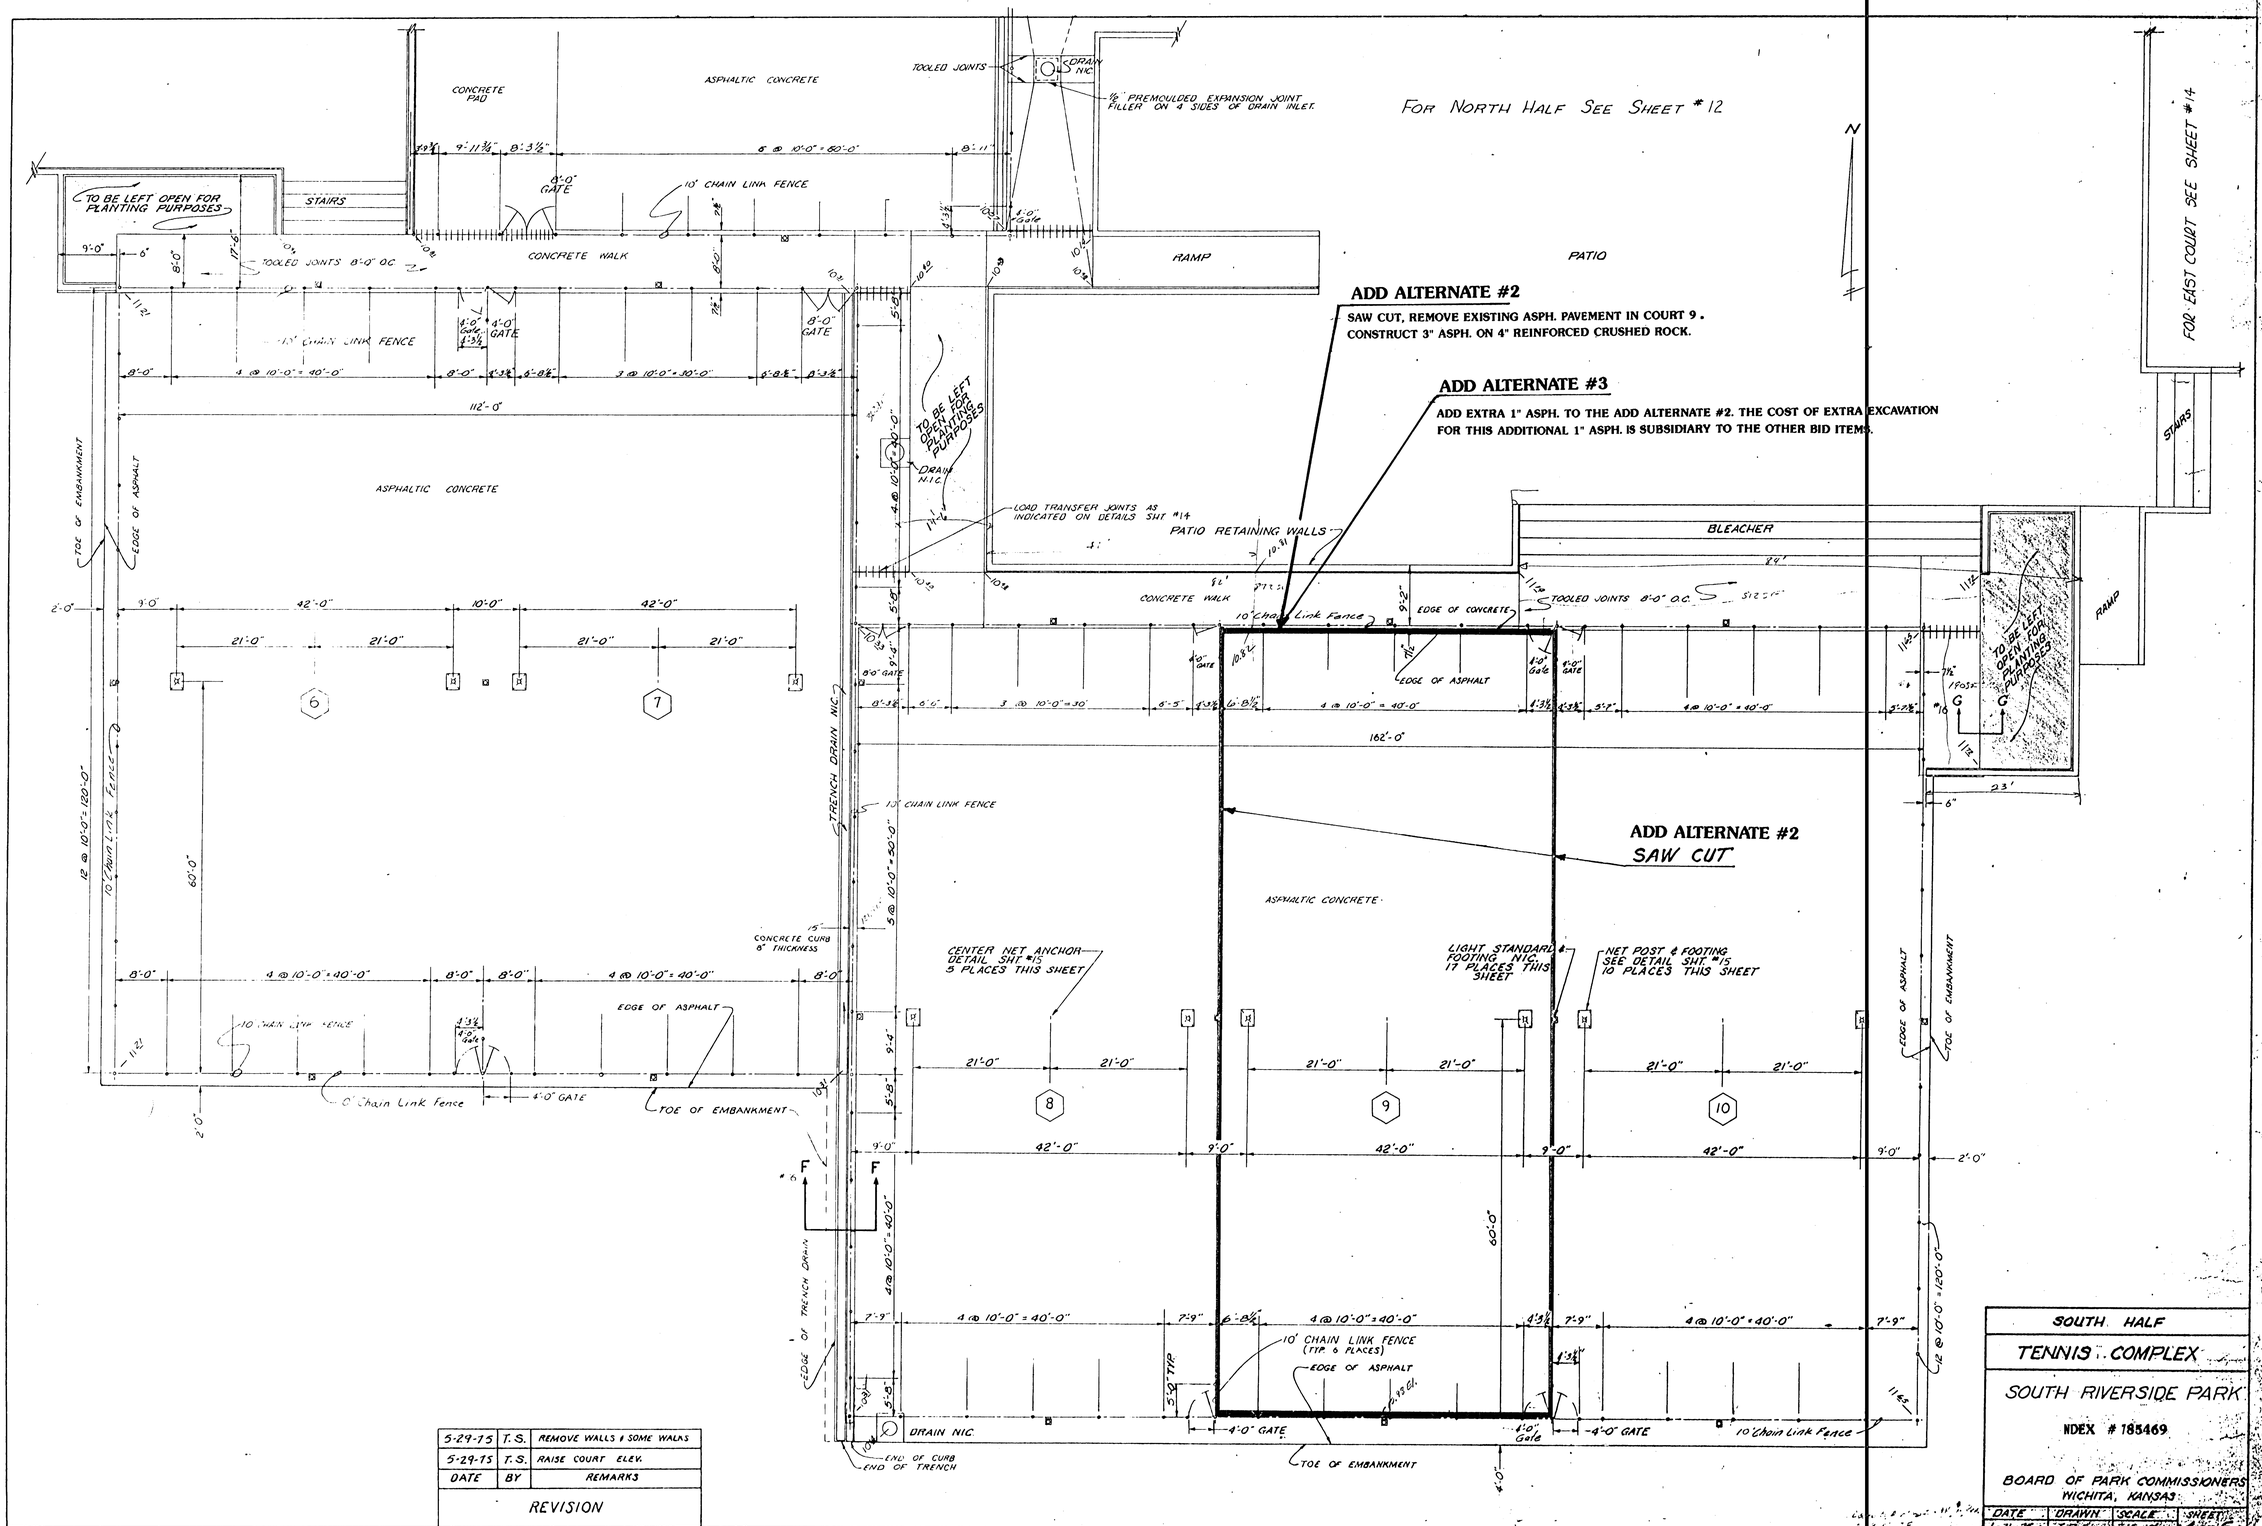

DATE	BY	REMARKS
5-29-75	T.S.	REMOVE WALLS & SOME WALKS
5-29-75	T.S.	RAISE COURT ELEV.

REVISION

SOUTH HALF

TENNIS COMPLEX

SOUTH RIVERSIDE PARK

INDEX # 185469

BOARD OF PARK COMMISSIONERS
WICHITA, KANSAS

DATE	DRAWN	SCALE	SHEET
1-31-75	R.R.K.	1"=10'	4 OF 6