





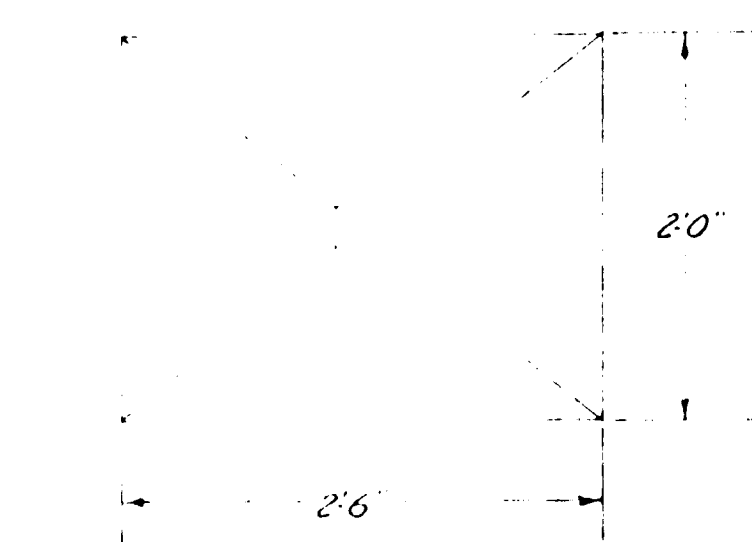


NET POST DETAIL
SCALE 1" = 1'-0"

WASHER BELOW ANCHOR
RING SHALL BE SET
ON GRADE RING SHALL
BE GALV. A MIN OF
1/2" DIA.

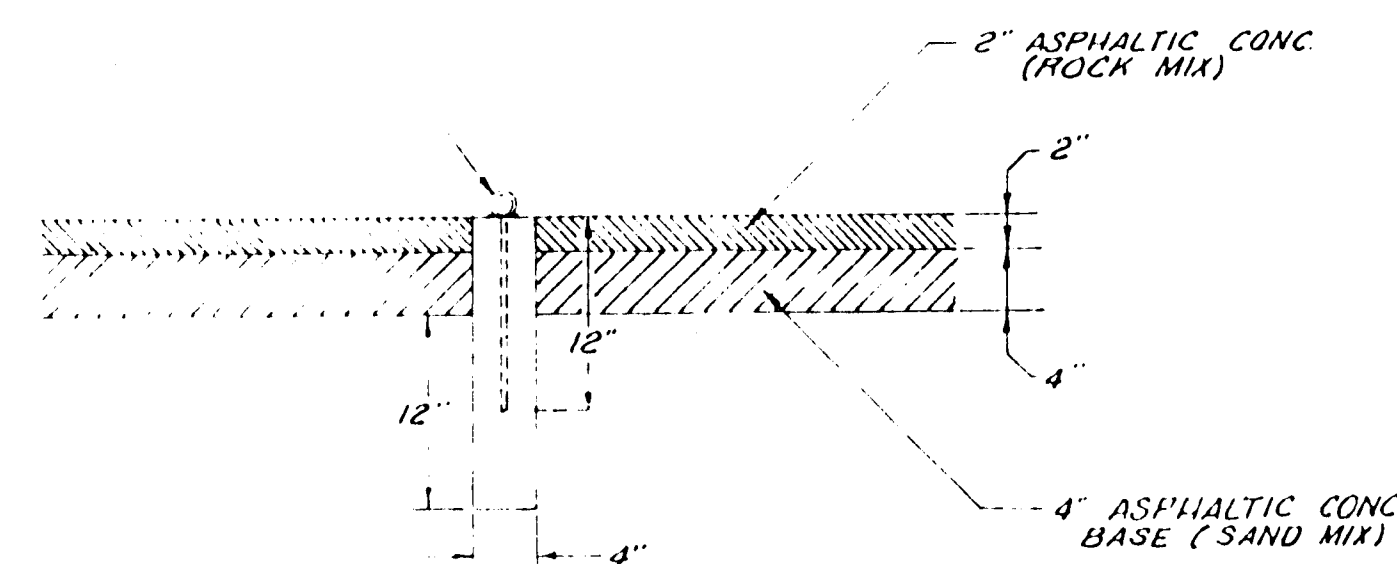

CENTER ANCHOR DETAIL
SCALE 1"=1'-0"

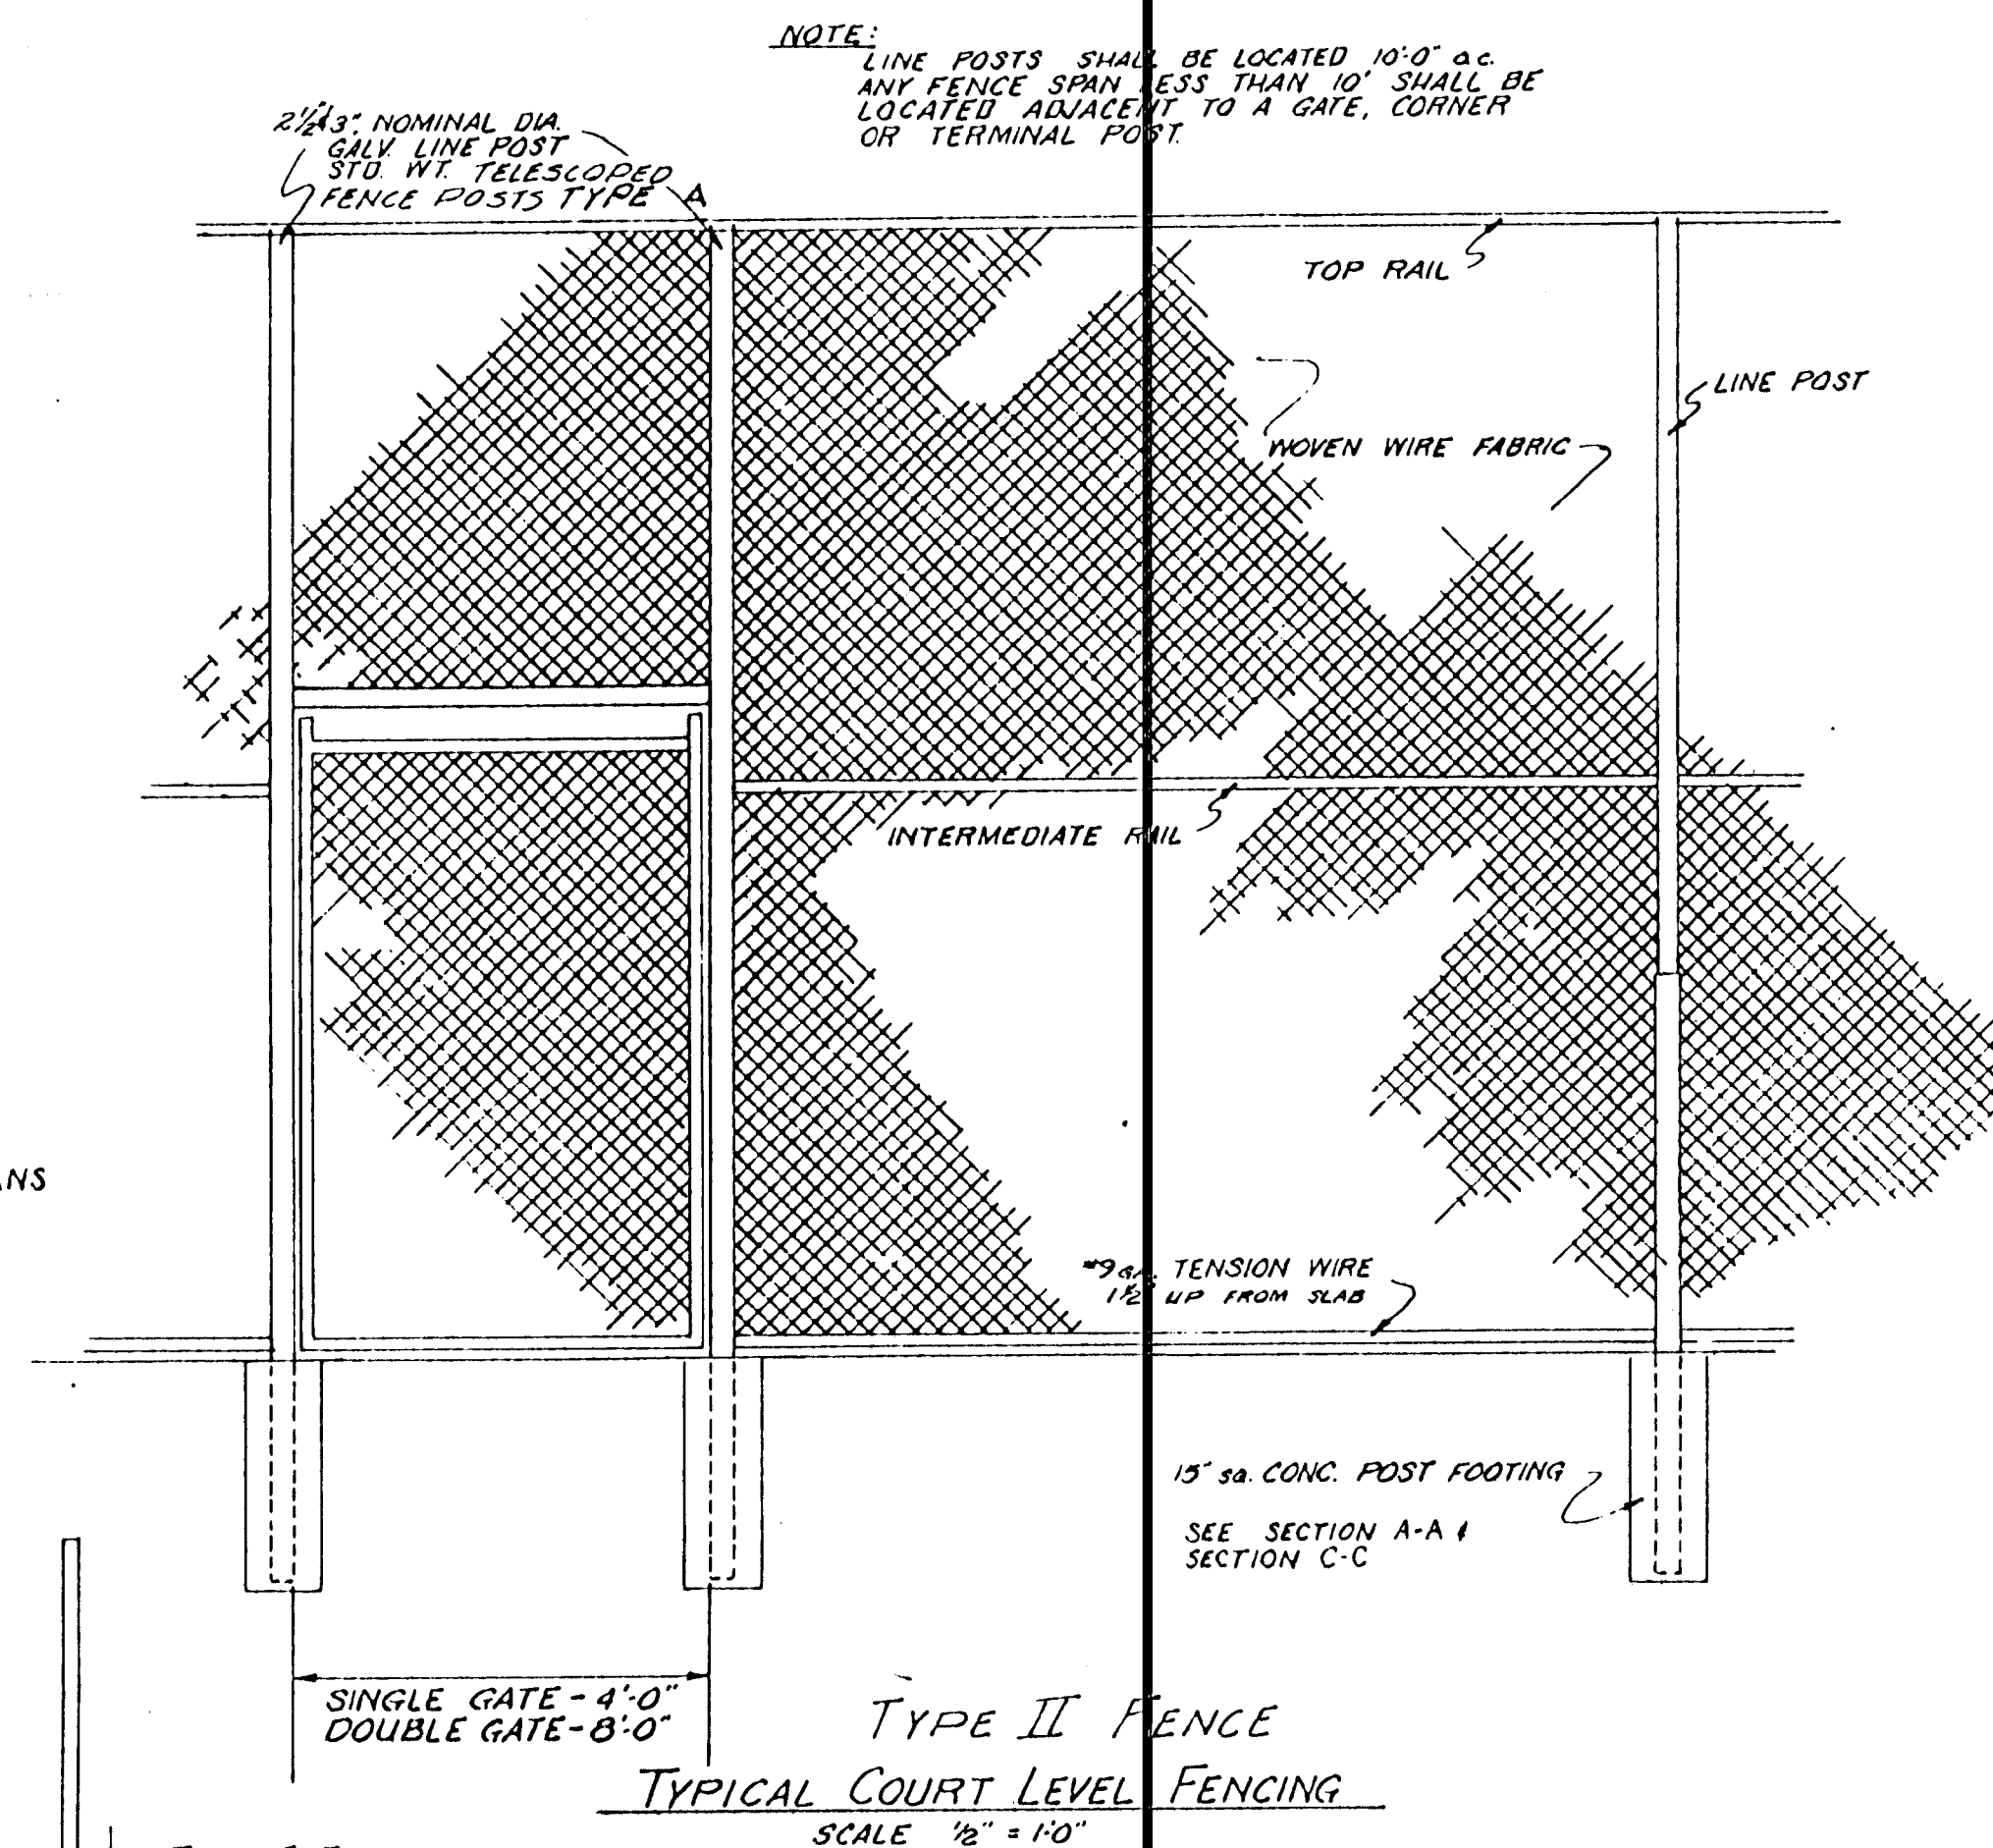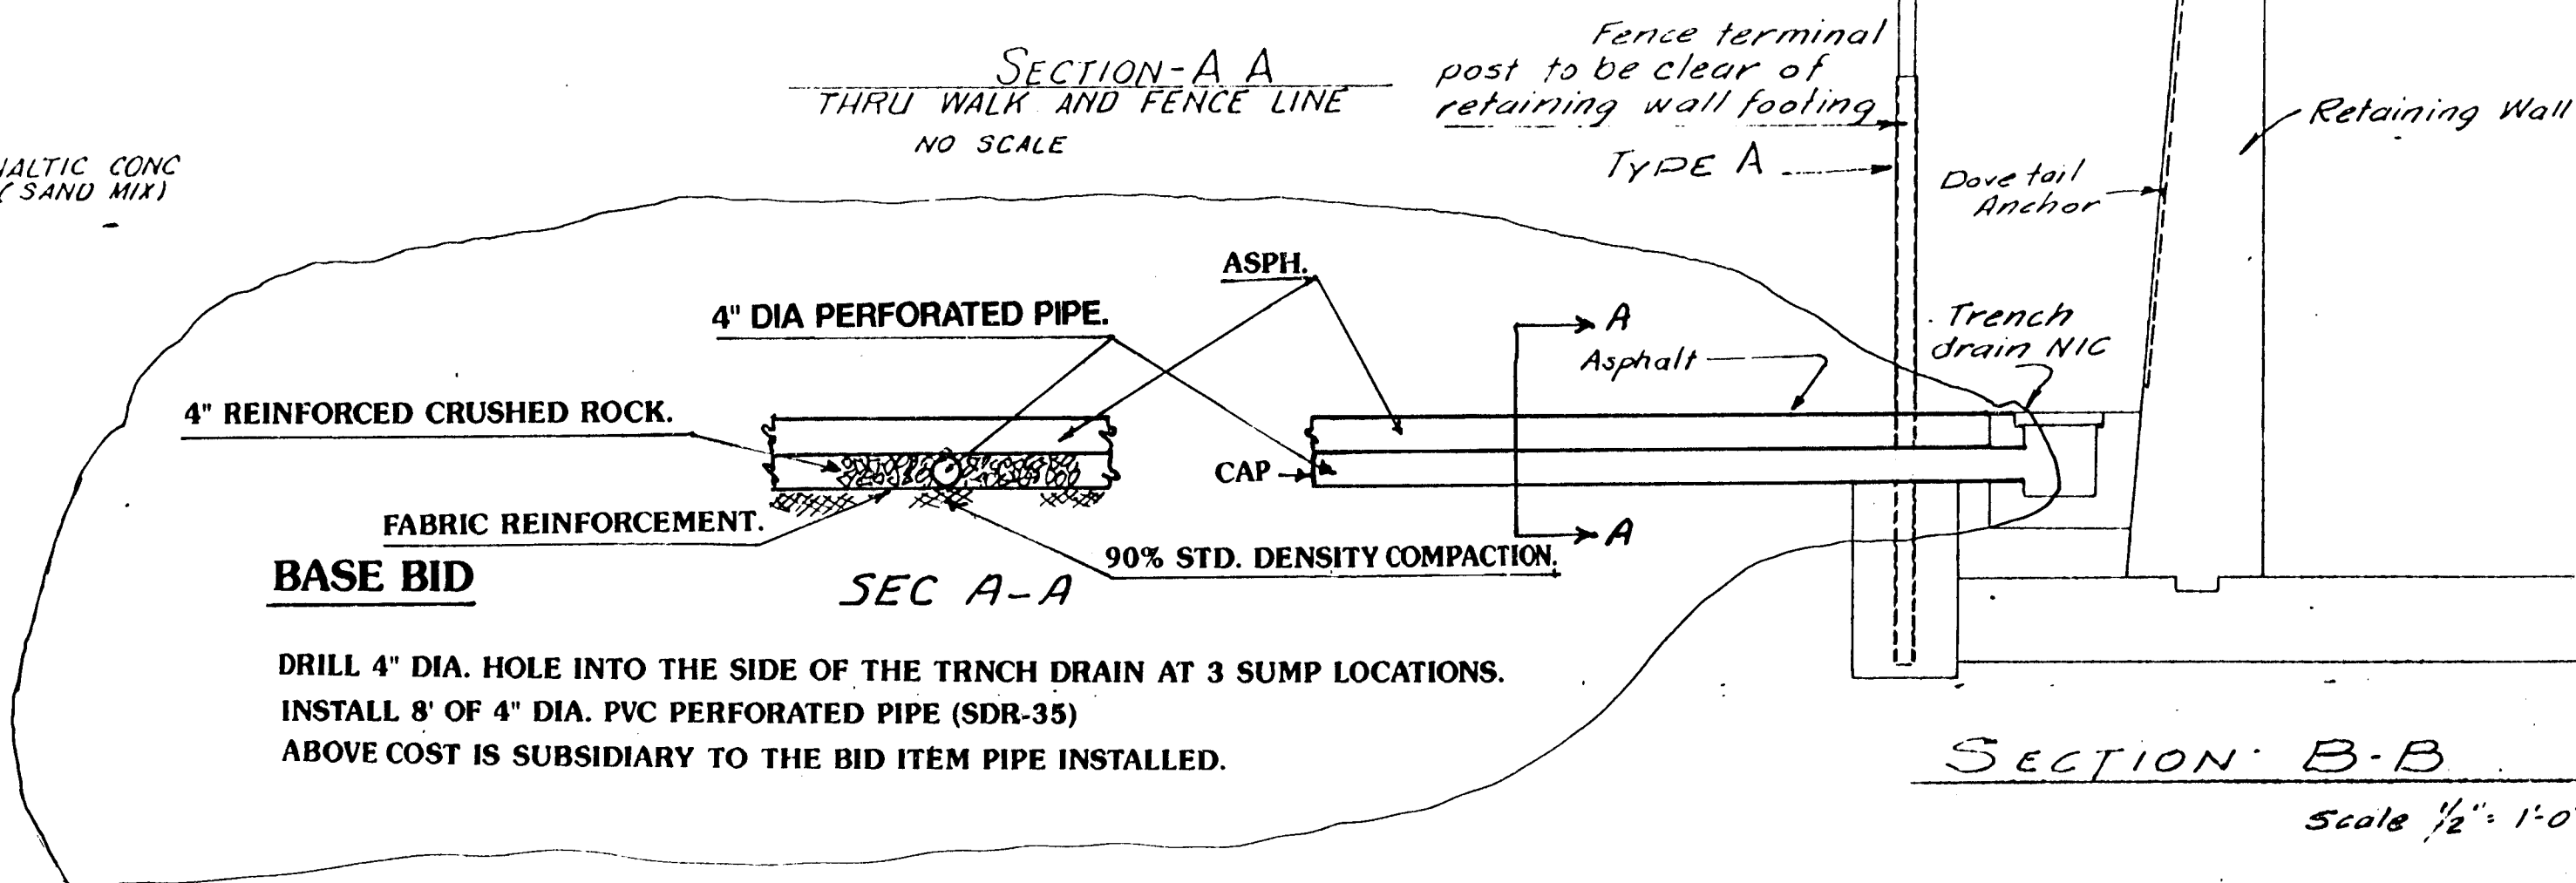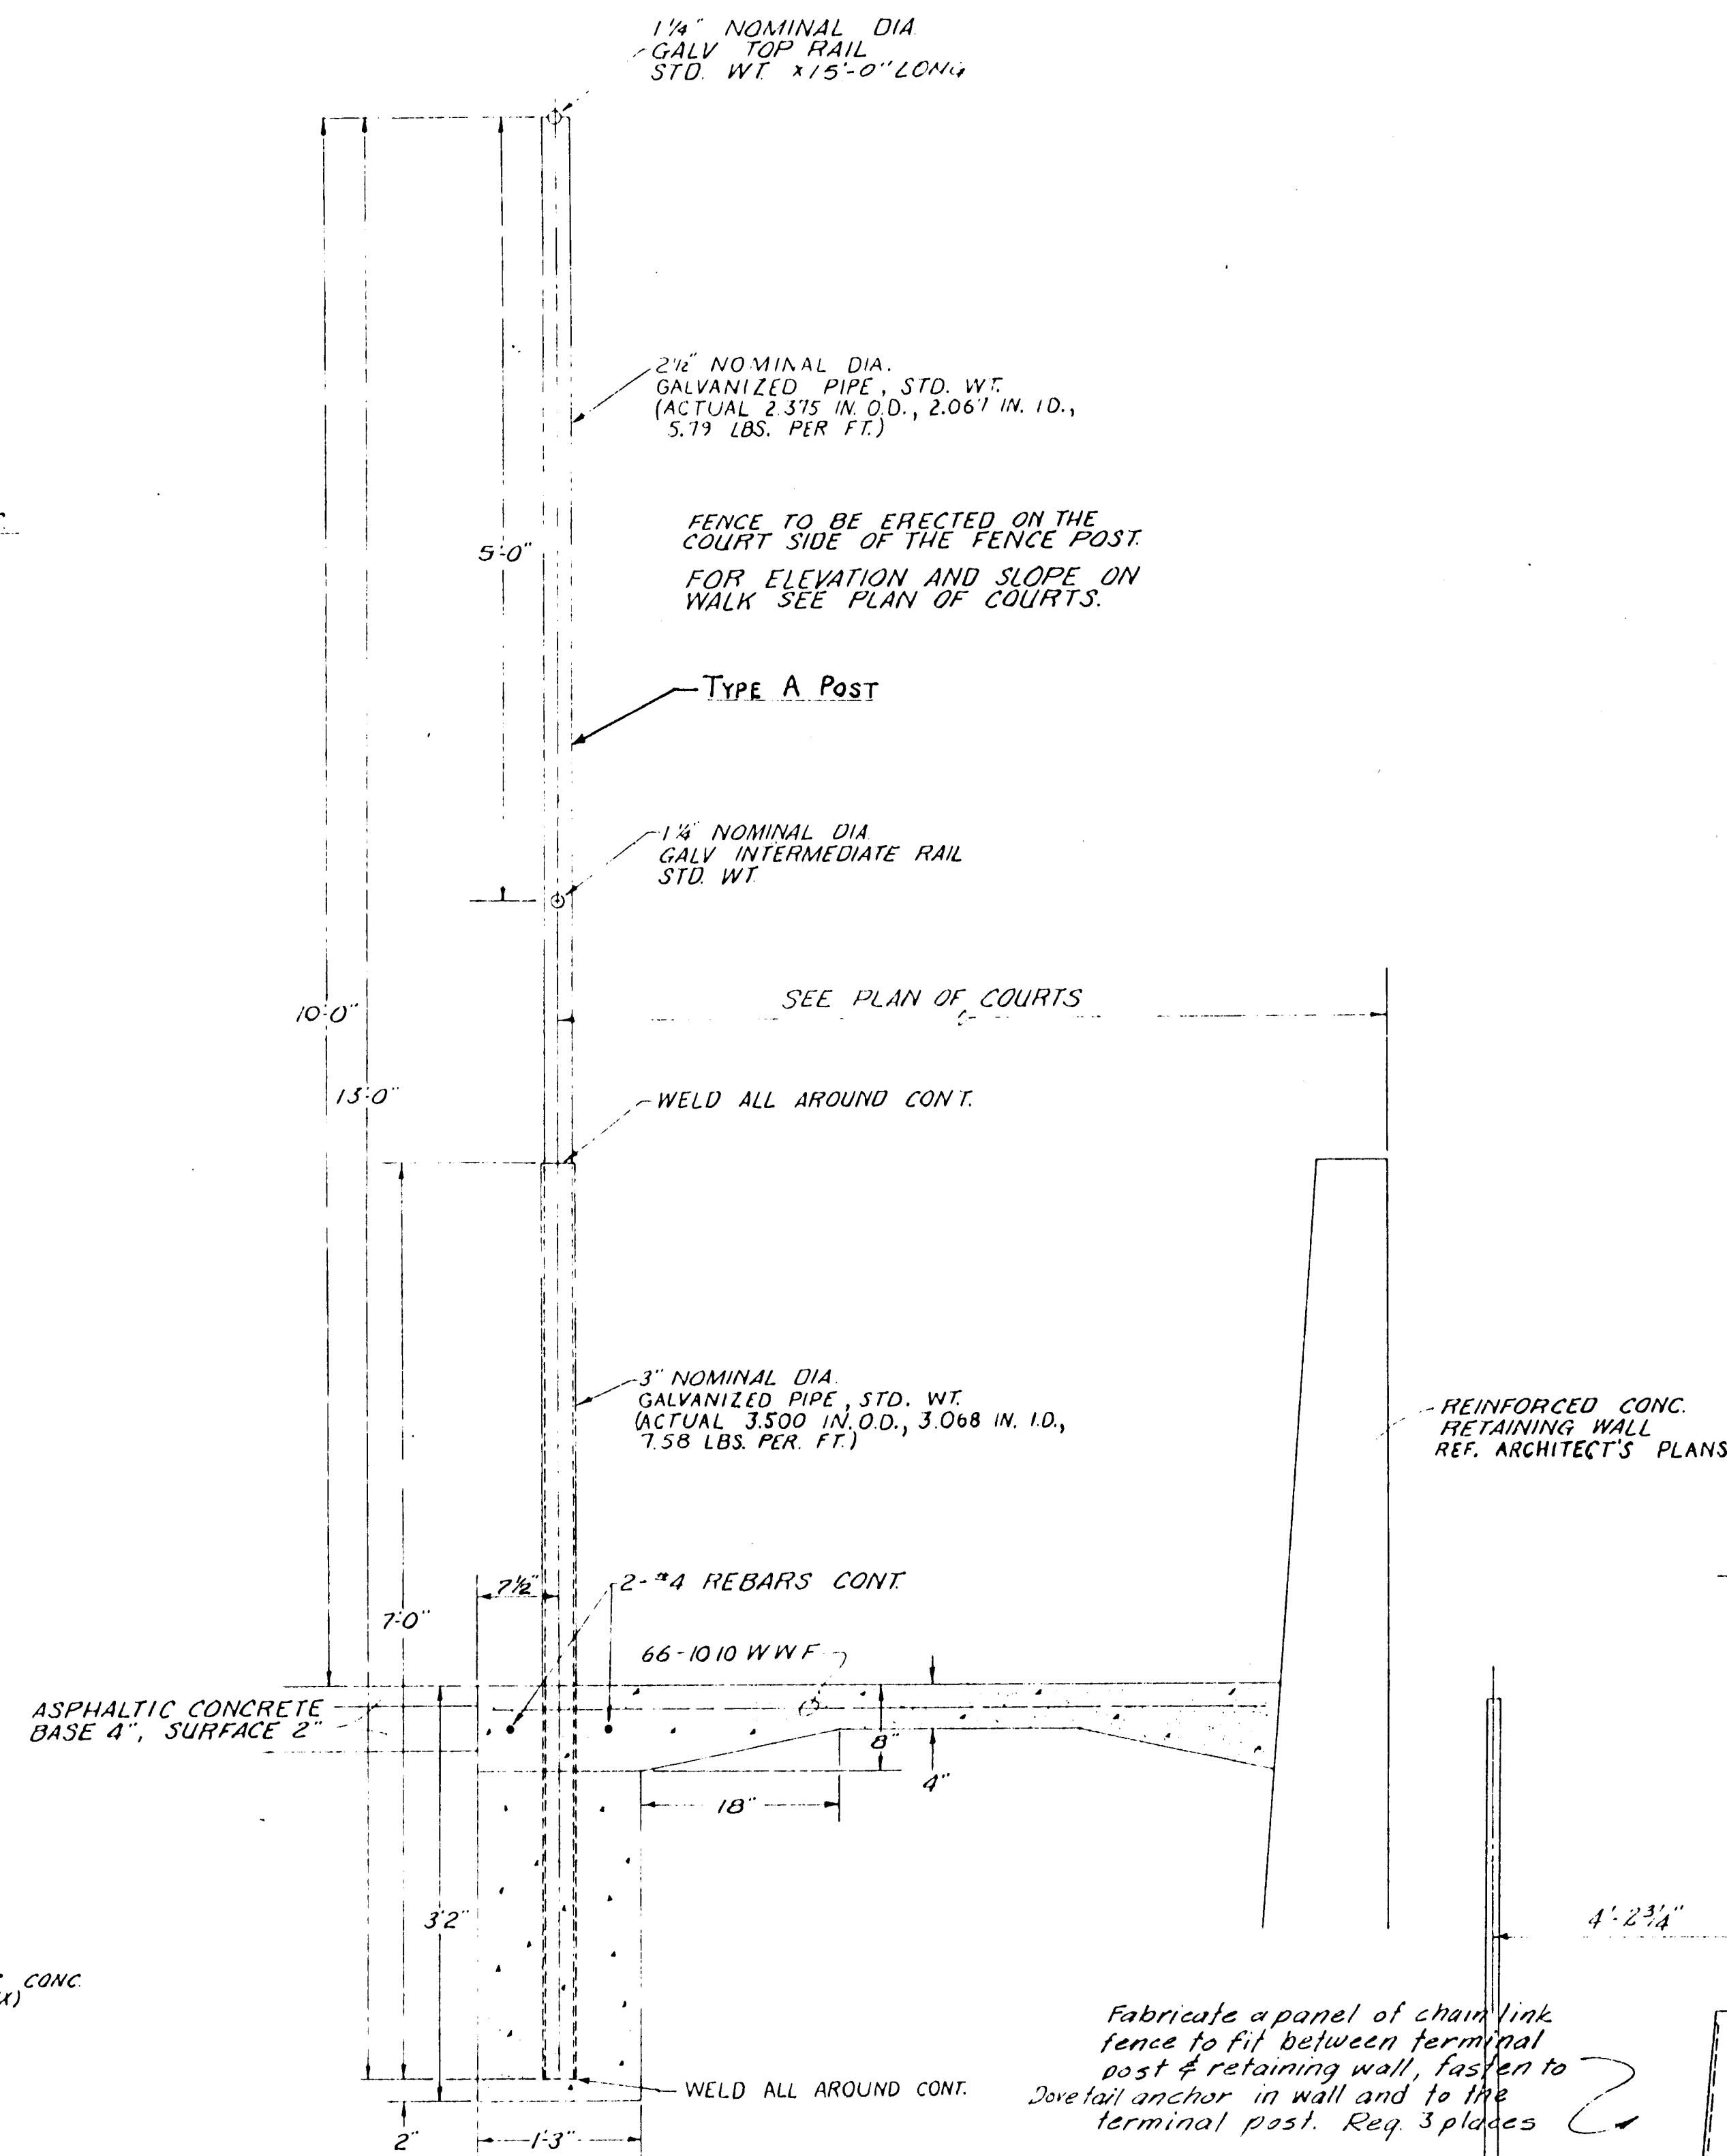

4'-0"
8'-0" TYPE II FENCE
TYPICAL COURT LEVEL FENCING
SCALE 1/2" = 1'-0"

DETAILS			
SOUTH RIVERSIDE PARK			
INDEX # 785469			
BOARD OF PARK COMMISSIONERS WICHITA, KANSAS.			
DATE	DRAWN	SCALE	SHEET
	D.R.R.		5 OF 6