


PROJECT NO.	SHEET NO.	TOTAL SHEETS
472-76-245-83375-000-000-001	9R	58

WATER VALVE BOX ELEVATIONS			
STREET	STATION	OFFSET	PROPOSED ELEVATION
FREDERIC	20+53.40	21.0' LL	207.0
FREDERIC	23+69.7	20.0' LL	210.7
FREDERIC	23+72.7	23.0' LL	210.8

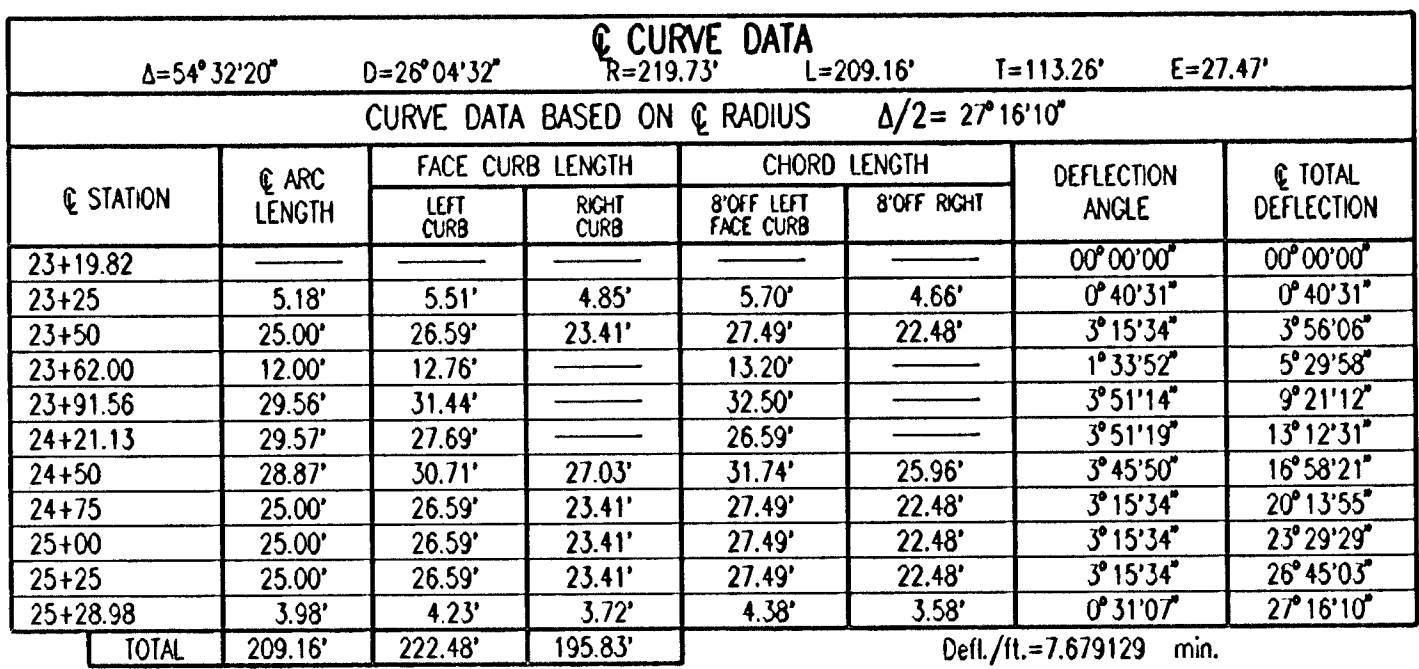

NOTE: THIS STREET TO BE CONSTRUCTED WITH
ROLL-TYPE CURB. TOP OF CURB ELEVATIONS
GIVEN ARE FOR FULL HEIGHT CURB.

I	REVISED STREET GRADES--STA. 20+53 TO 26+00	BJS	12-18-01
No.	Revisions	By	Date "

REMINGTON PLACE-PHASE I
CITY OF WICHITA, KANSAS

FREDERIC
STA. 20+00.00 TO STA. 26+00



Professional Engineering Consultants, P.A.
 303 S. TOPEKA • WICHITA, KANSAS 67202
 316-262-2691 • FAX 316-262-3003

Designed by	BER	Checked by	
Drawn by	BJS	Date DEC. 2001	Job No. 01158