


PLAN	SURVEY	BY	DATE
NOTE BOOK	PLOTTED		
	ALIGNMENT CHECKED		
	RT. OF WAY CHECKED		

DSNR: DEP. OPER. DEP. SCALE: 1"=20.00
Q: 1999/09/23/000 MORIVE6 06-01-2001 03:04:52 pm

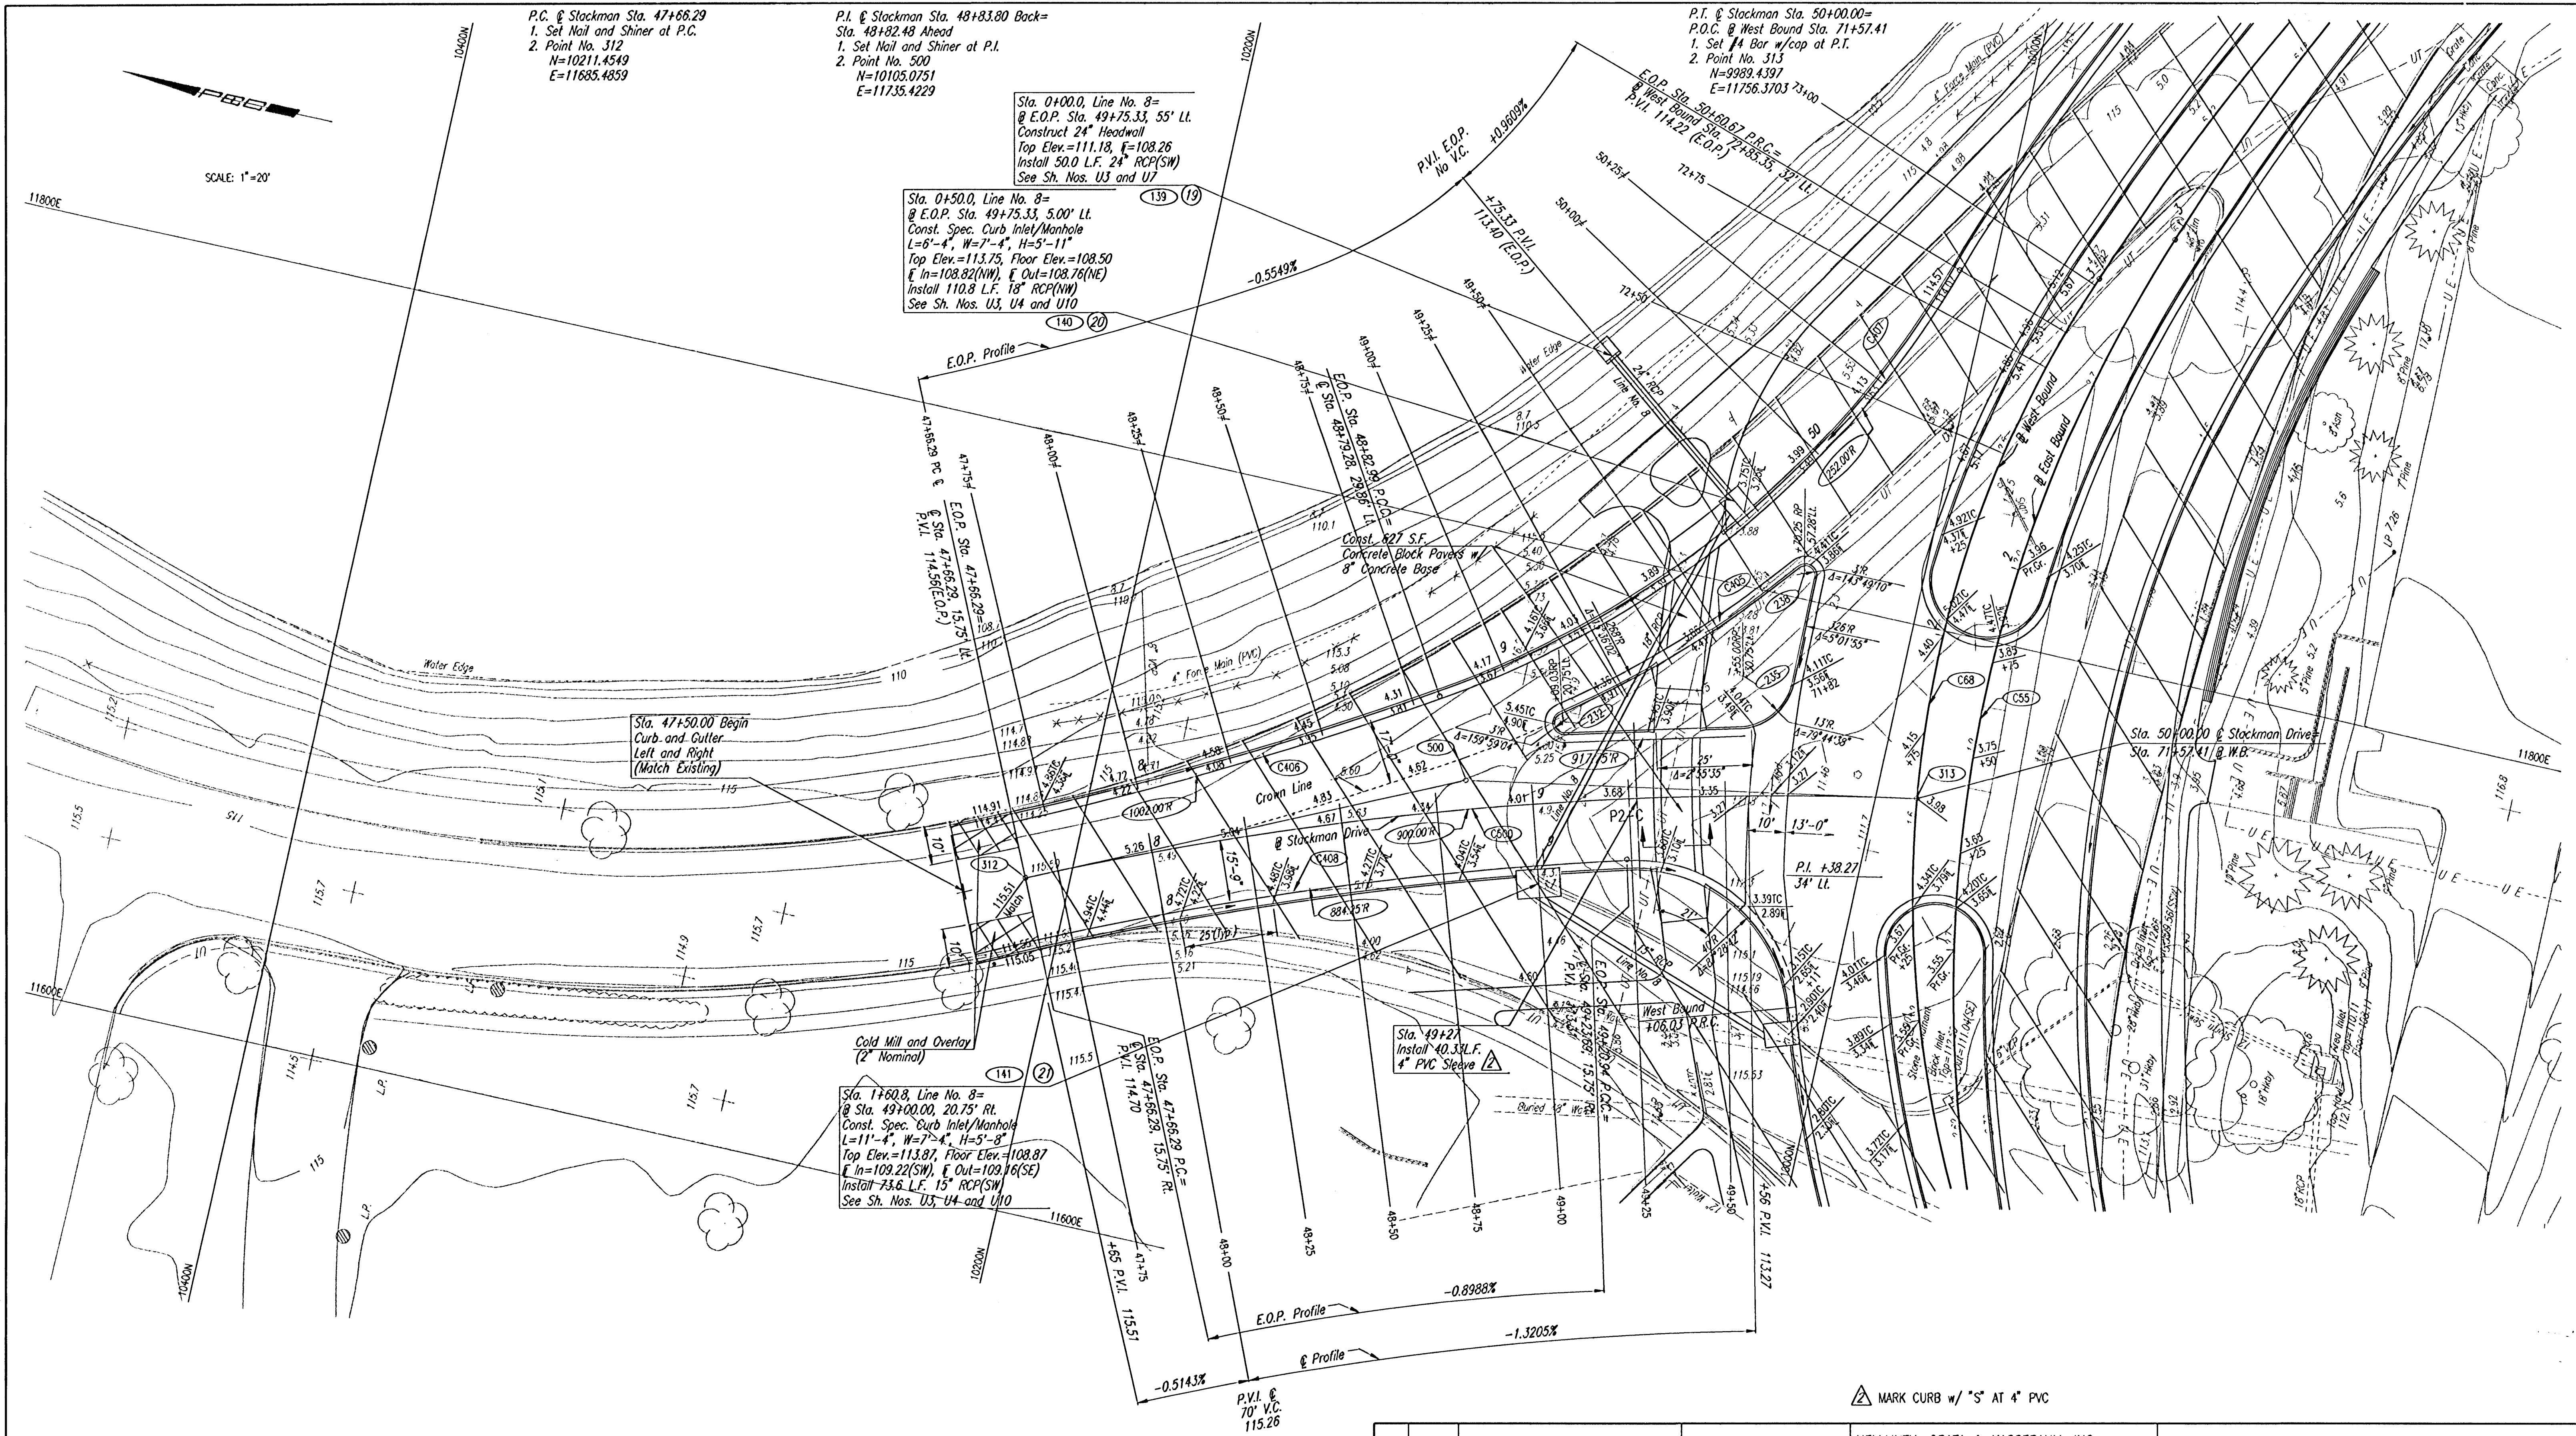

B.M. #4 - Chiseled "d" center face of Curb Inlet on East side Concrete Drive, 1st Drive West of Stockman on South side Sim Park Drive.
@ East Bound Sta. 69+87, 81' Rt. Elev.=112.03

REV.	DATE	DESCRIPTION

MARK CURB w/ "S" AT 4" PVC

HELLMUTH, OBATA & KASSEBAUM, INC.
DALLAS, TEXAS
PROFESSIONAL ENGINEERING
CONSULTANTS, P.A.
WICHITA, KANSAS
BRAD J. GOLDBERG
DALLAS, TEXAS

MUSEUM DISTRICT ROADWAY AND
PEDESTRIAN IMPROVEMENTS
WICHITA, KANSAS

STACKMAN DRIVE
STA. 47+66.29 TO STA. 50+00.00

PROJECT NO.

SHEET
P-10