
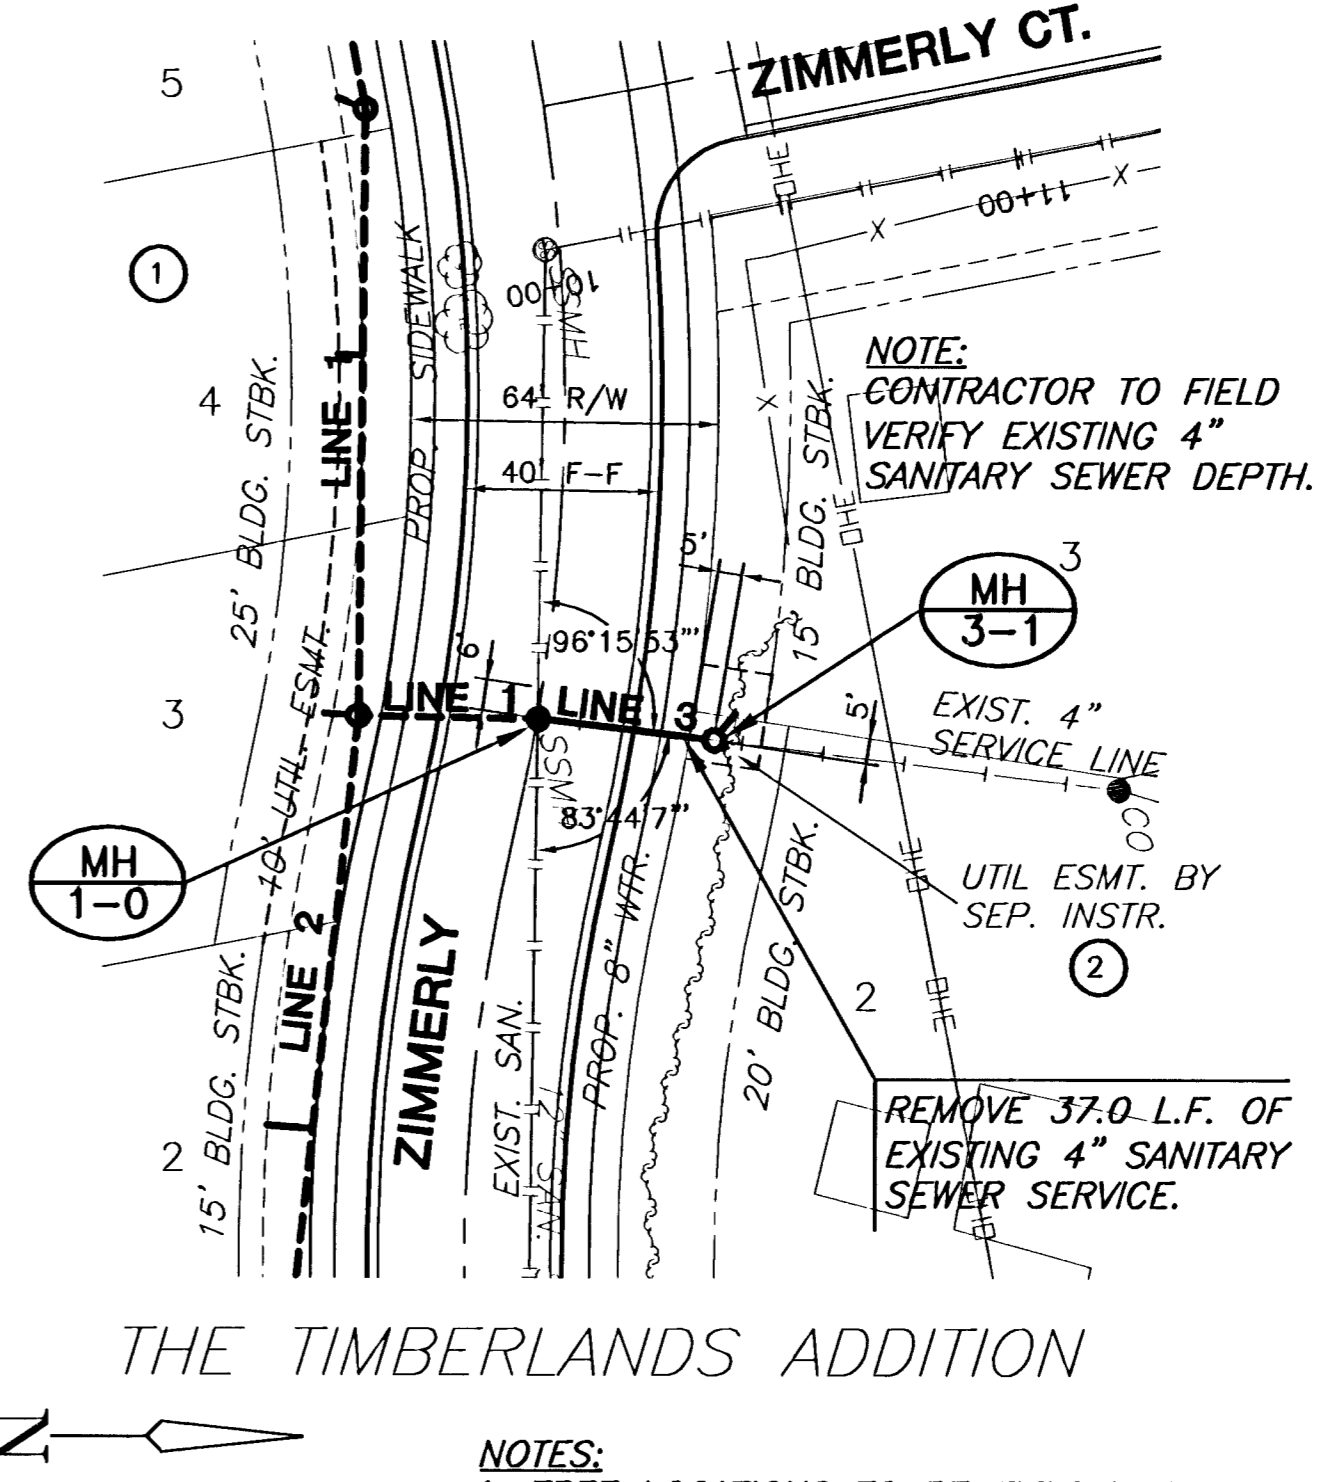
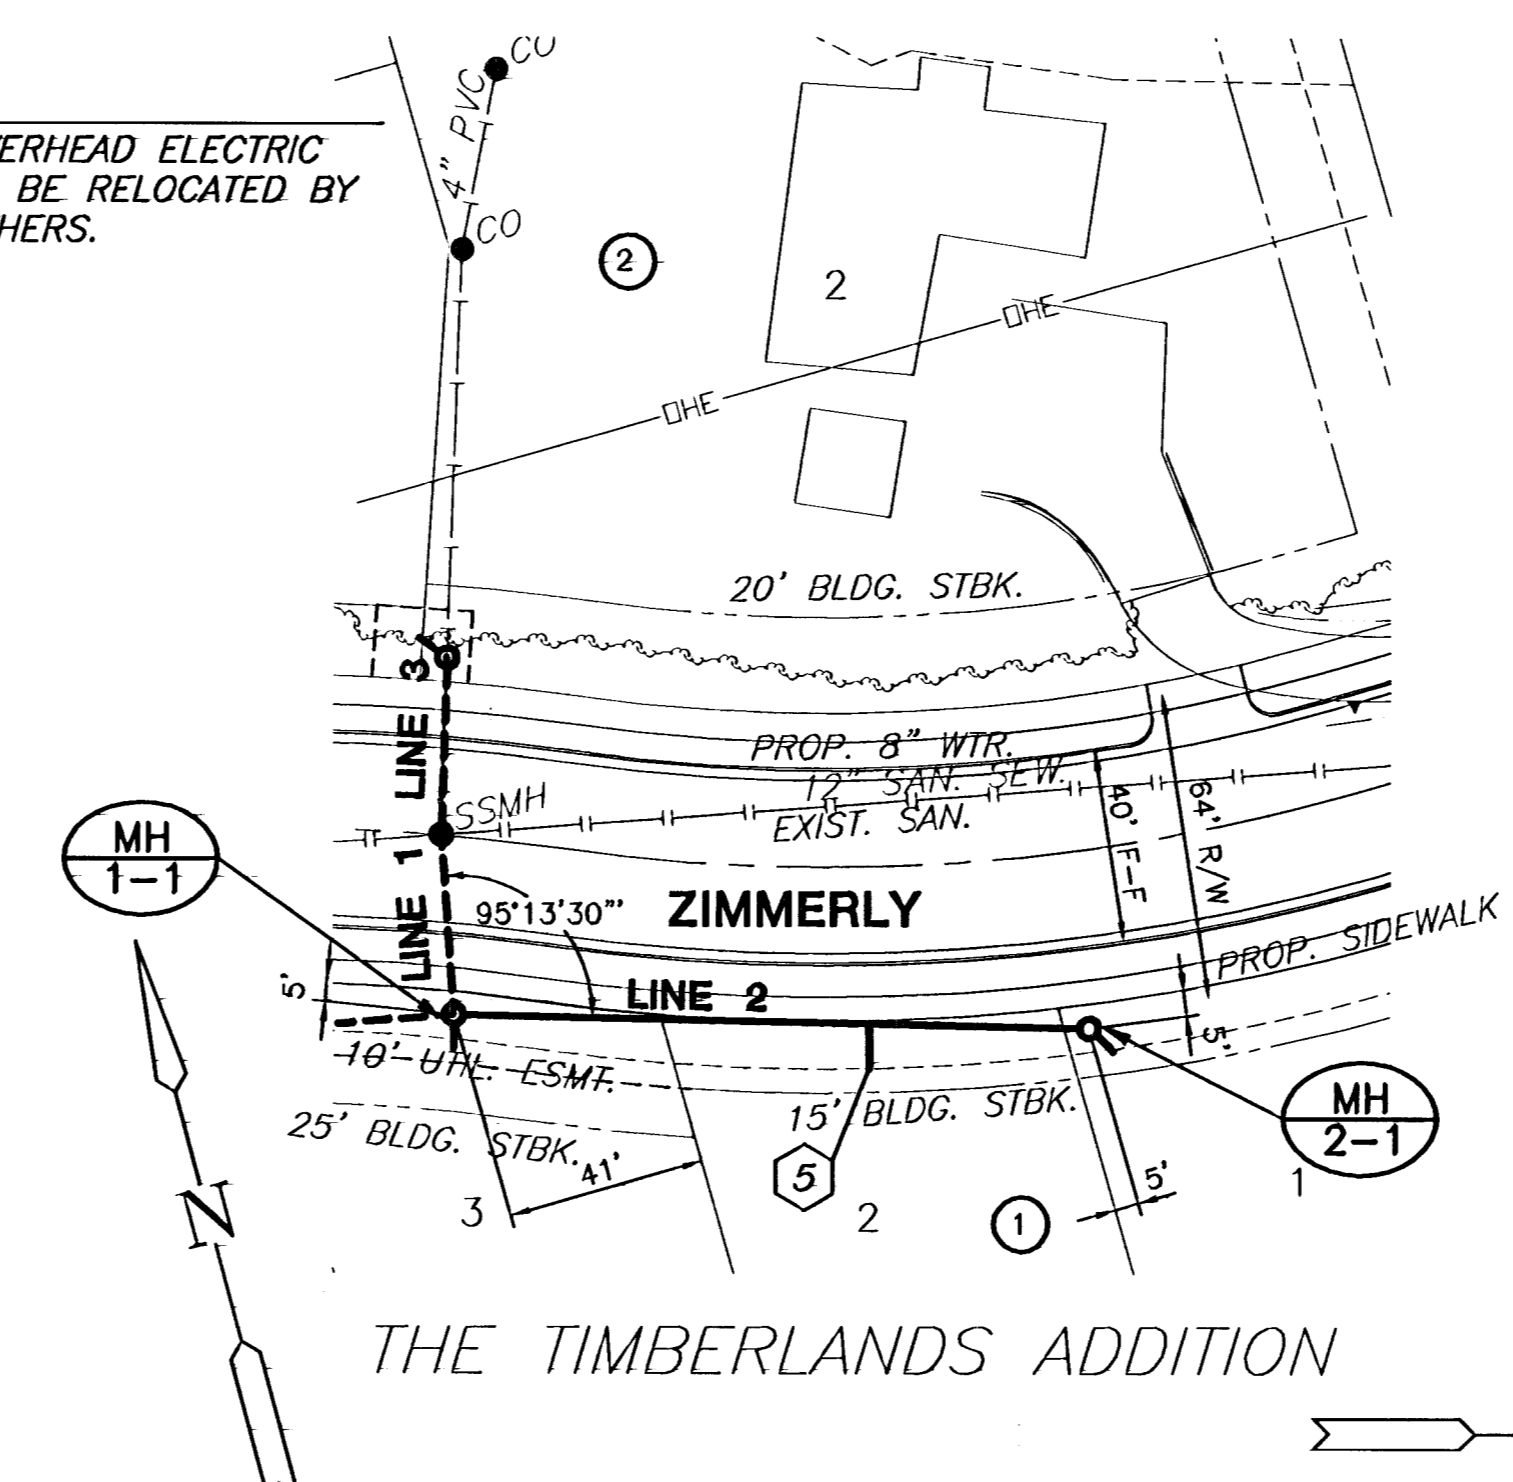


EAST LYNN ADDITION

THE TIMBERLANDS ADDITION

THE TIMBERLANDS ADDITION

MKEC
ENGINEERING
CONSULTANTS, INC.
411 N. WEBB ROAD
WICHITA, KS. 67206
316-694-9600

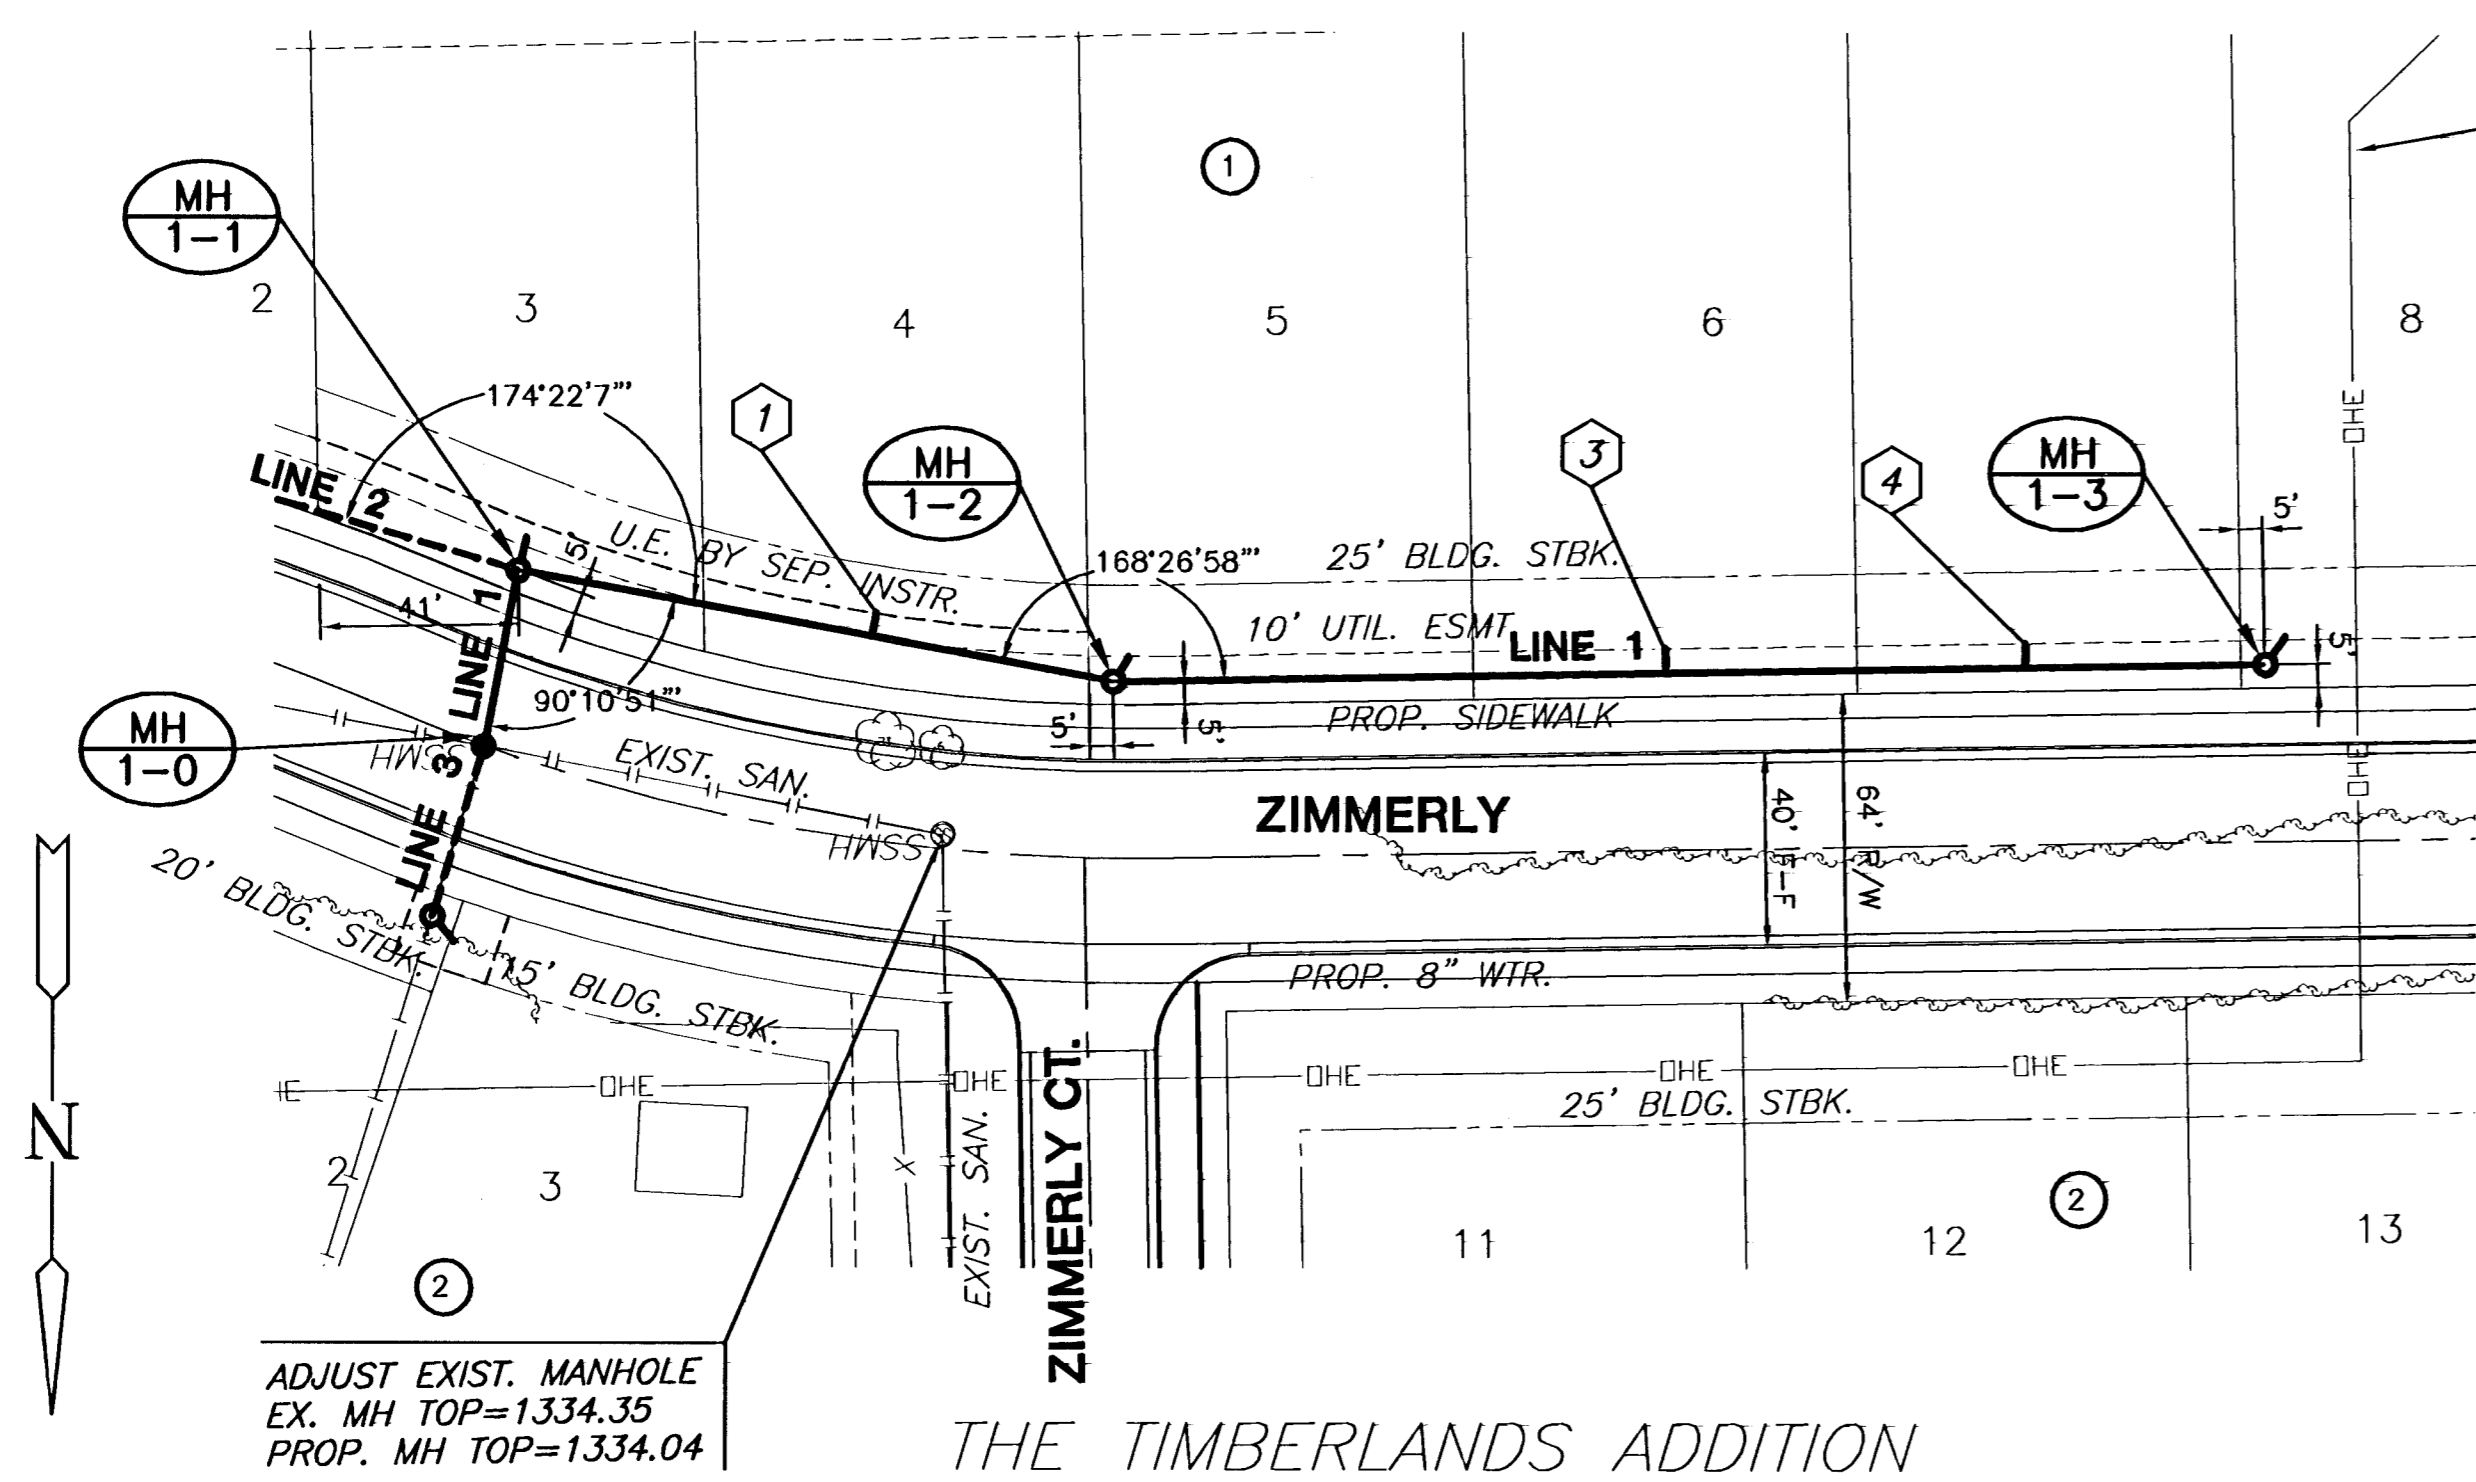




ADJUST EXIST. MANHOLE
EX. MH TOP=1334.35
PROP. MH TOP=1334.04

OVERHEAD ELECTRIC
TO BE RELOCATED BY
OTHERS.

NOTE:
CONTRACTOR TO FIELD
VERIFY EXISTING 4"
SANITARY SEWER DEPTH.

REMOVE 37.0 L.F. OF
EXISTING 4" SANITARY
SEWER SERVICE.


NOTES:
1. TREE LOCATIONS TO BE FIELD VERIFIED.
2. FRONT YARD SANITARY SEWER SHALL BE
SAND BACKFILLED AND FLUSHED.

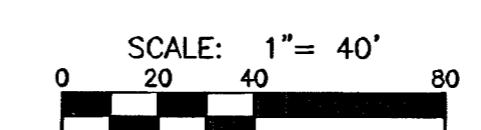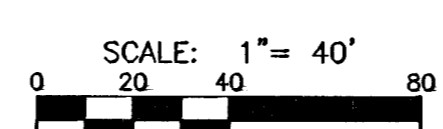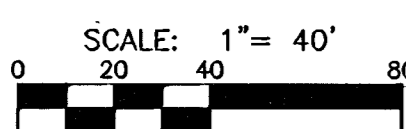

PLAN LINE 1

PLAN LINE 2

PLAN LINE 3

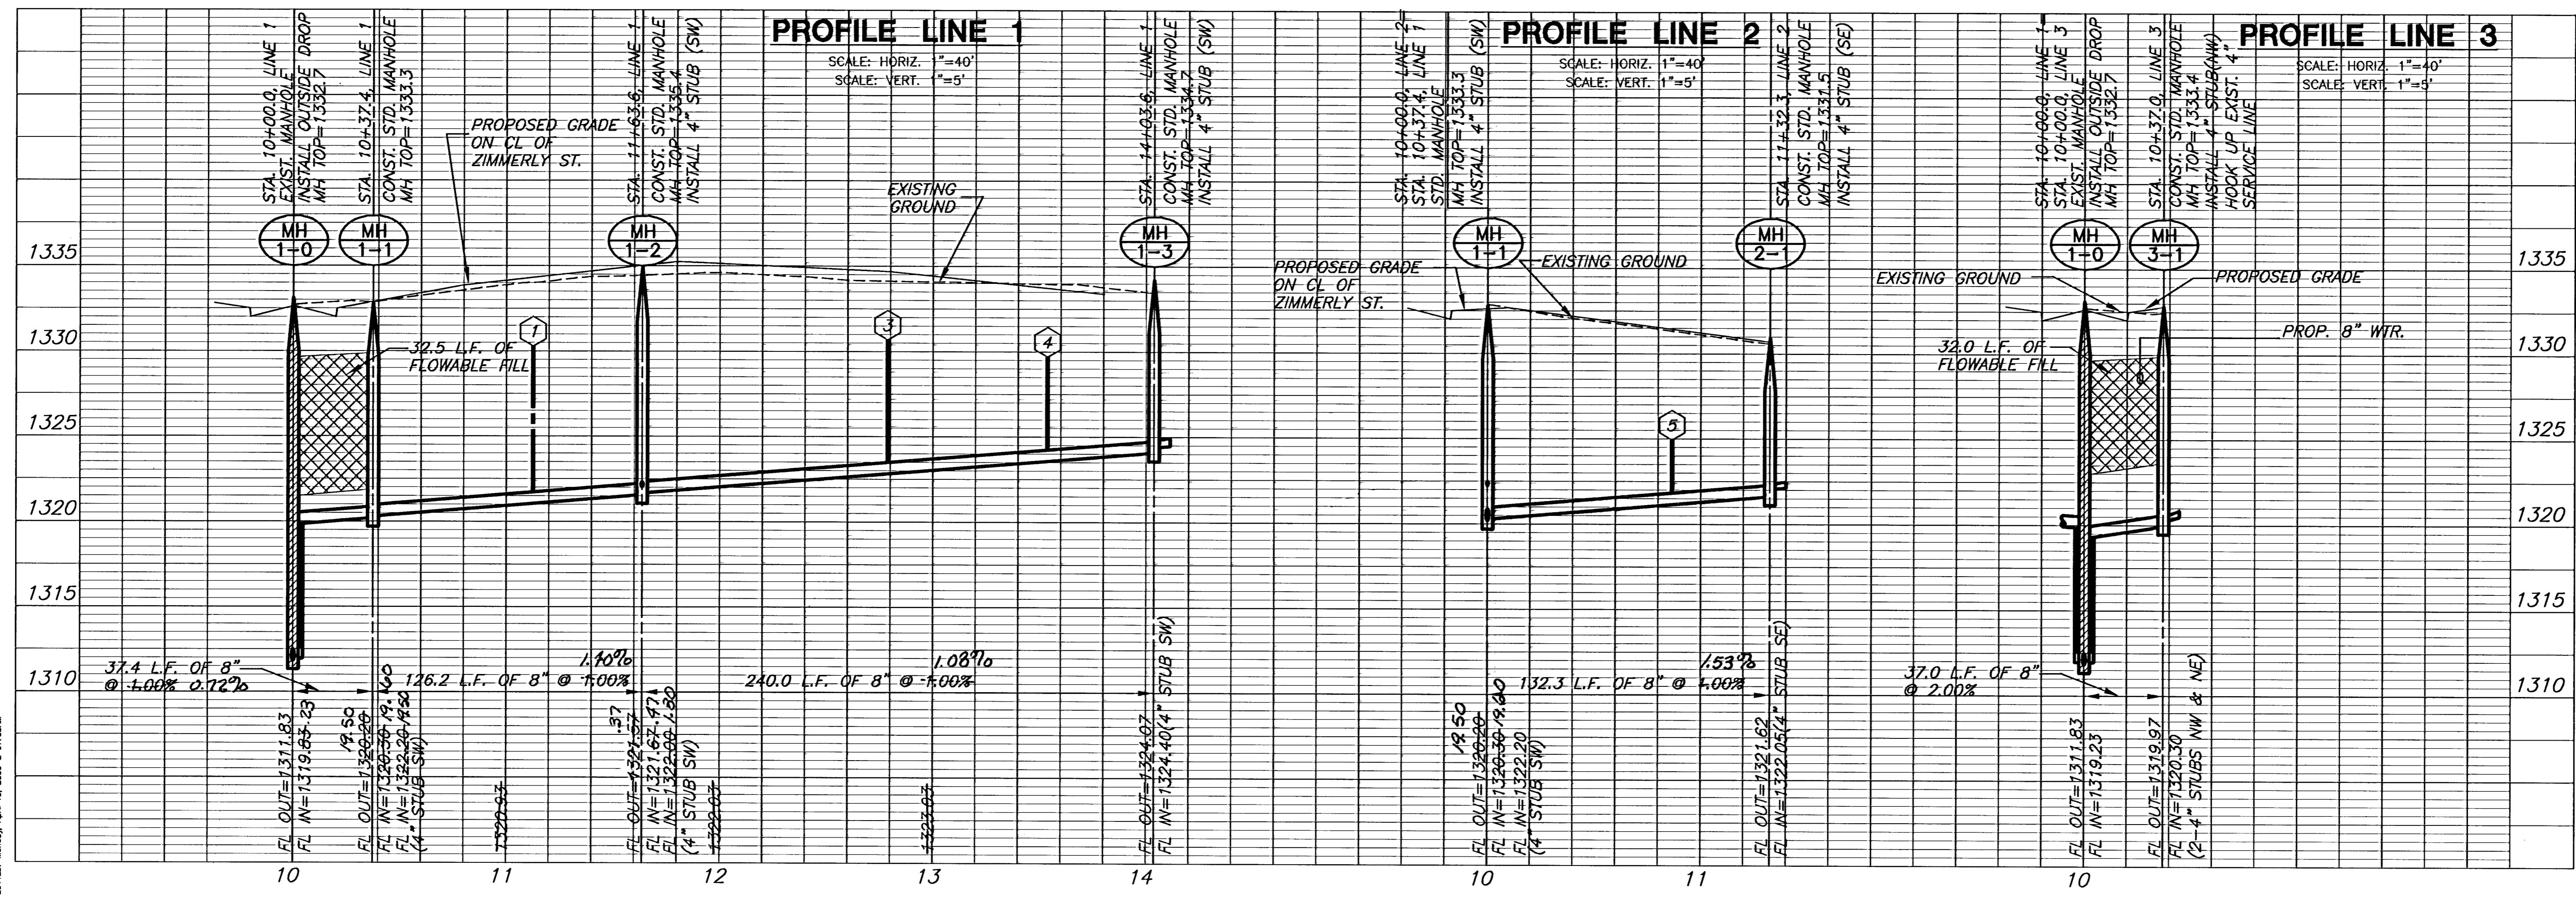

SANITARY SEWER PLANS
THE TIMBERLANDS ADD.

LINE 1, 2, & 3
SHEET TITLE
468-84093
PROJECT NUMBER

DESIGN BY: SRS
DRAWN BY: BFL
CHECKED BY: SRS

ISSUED: APRIL 2006
REVISED:

SHEET NO.
5 of 9

PLOTED: MONDAY, APR 10, 2006 @ 07:33AM

J:\Civil\04416\04416\San\Phase 1\04416B1