
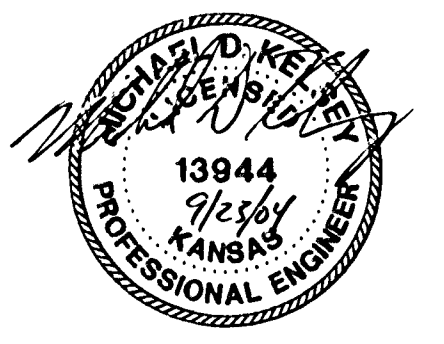
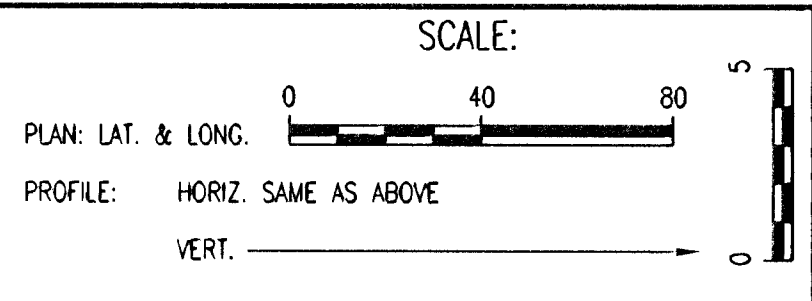


PLAN	CHECKED	DATE
	CHECKED	

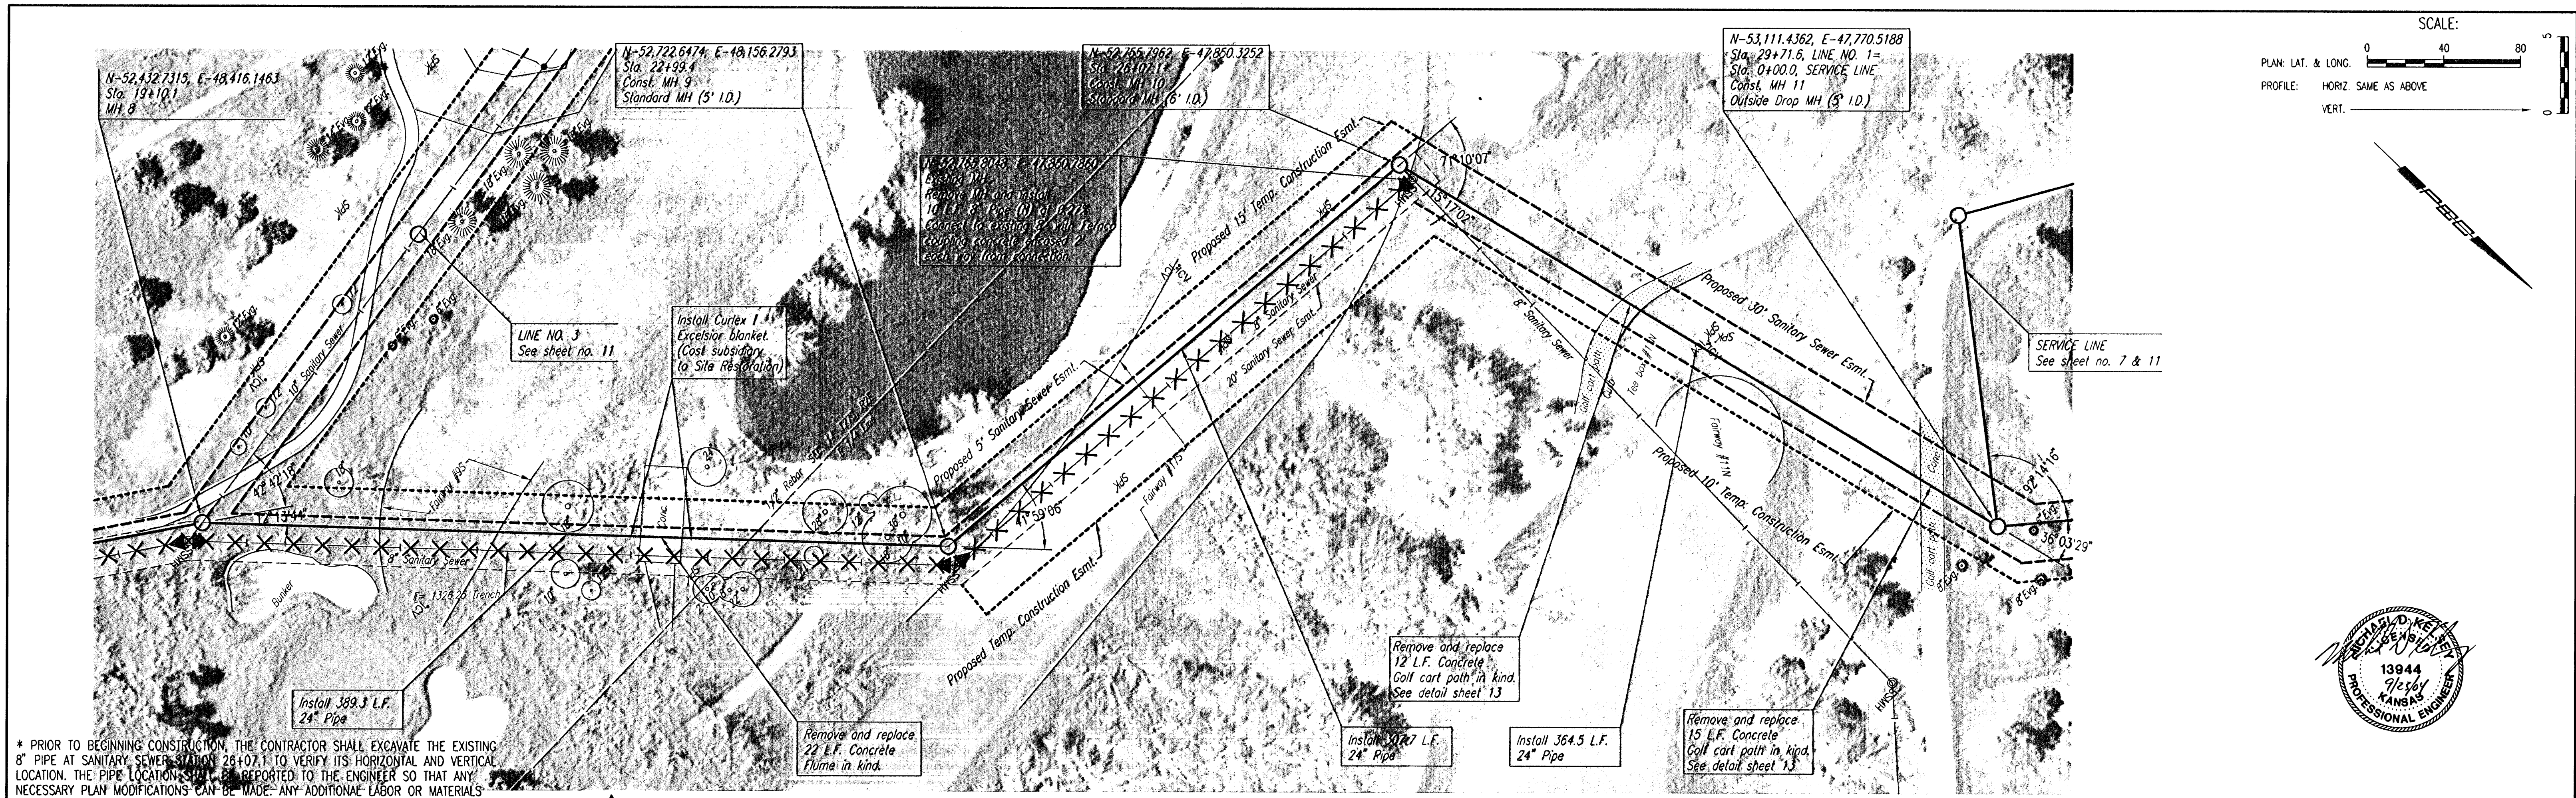


* PRIOR TO BEGINNING CONSTRUCTION, THE CONTRACTOR SHALL EXCAVATE THE EXISTING 8" PIPE AT SANITARY SEWER STATION 26+07.1 TO VERIFY ITS HORIZONTAL AND VERTICAL LOCATION. THE PIPE LOCATION SHALL BE REPORTED TO THE ENGINEER SO THAT ANY NECESSARY PLAN MODIFICATIONS CAN BE MADE. ANY ADDITIONAL LABOR OR MATERIALS NECESSARY TO COMPLETE THE CONNECTION SHALL BE CONSIDERED SUBSIDIARY TO THE PROJECT.

▲ = DENOTES PIPE PLUG
 X = DENOTES SANITARY SEWER/MANHOLE ABANDONMENT

SANITARY SEWER LINE NO. 1

PROFILE	CHECKED	DATE
	CHECKED	

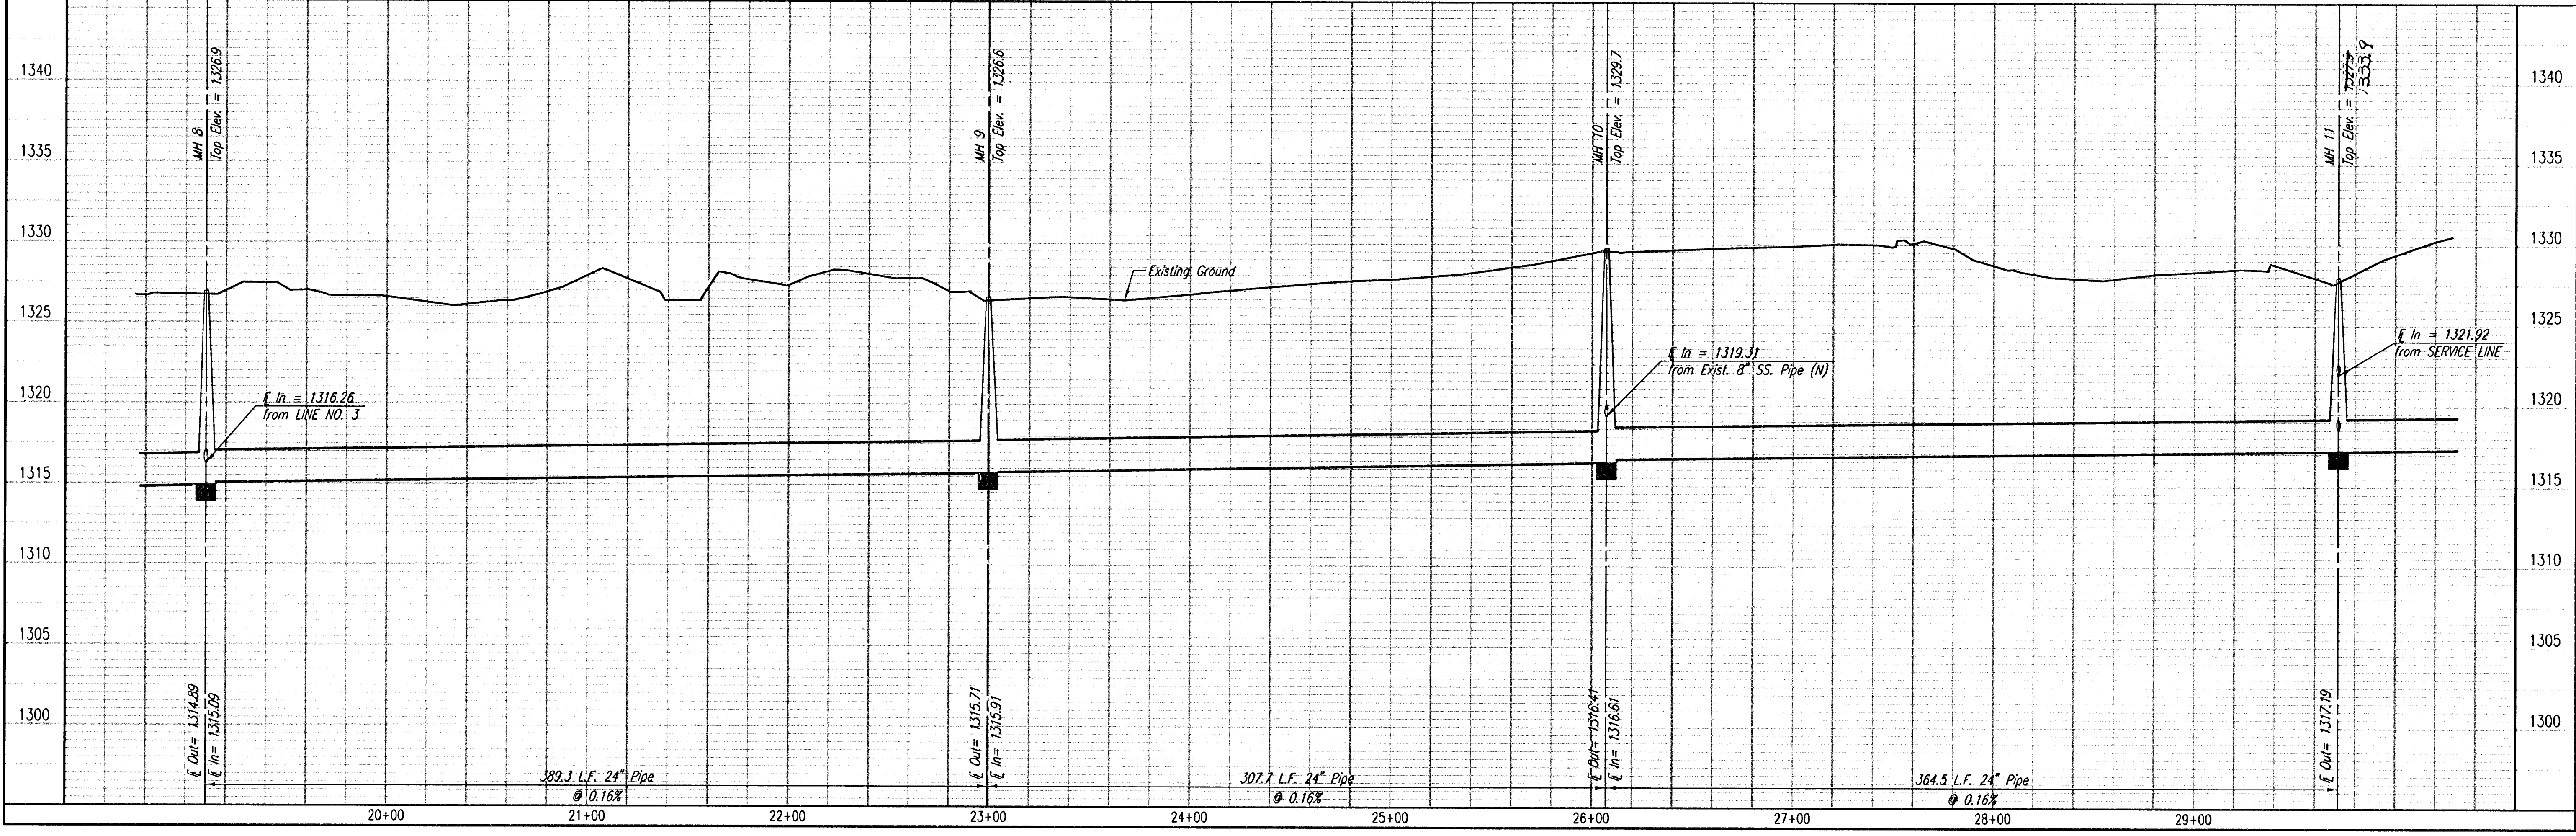

DSNR: OPER: JGA SCALE: 1=40.00
 Q:\2002\02633\sspp03 09-24-2004 11:26:05 am

MAIN 17, FOUR MILE CREEK
 CRESTVIEW SEWER - PHASE 1
SANITARY SEWER LINE NO. 1
 JAMES L. ARMOUR, P.E., ACTING CITY ENGINEER
 CITY OF WICHITA PROJECT NO. 488-83903

Professional Engineering Consultants, P.A.
 303 S. TOPEKA - WICHITA, KANSAS 67202
 316-262-2691 • FAX 316-262-3003

Designed By: MDK
 Drawn By: JGA
 Job No.: 35-02633-3697
 Date: JULY 2004

Sheet 6 of 23