


OSNR: OPER: JGA SCALE: 1=40.00
Q:/2002/02633/sspp04 09-24-2004 11:21:12 am

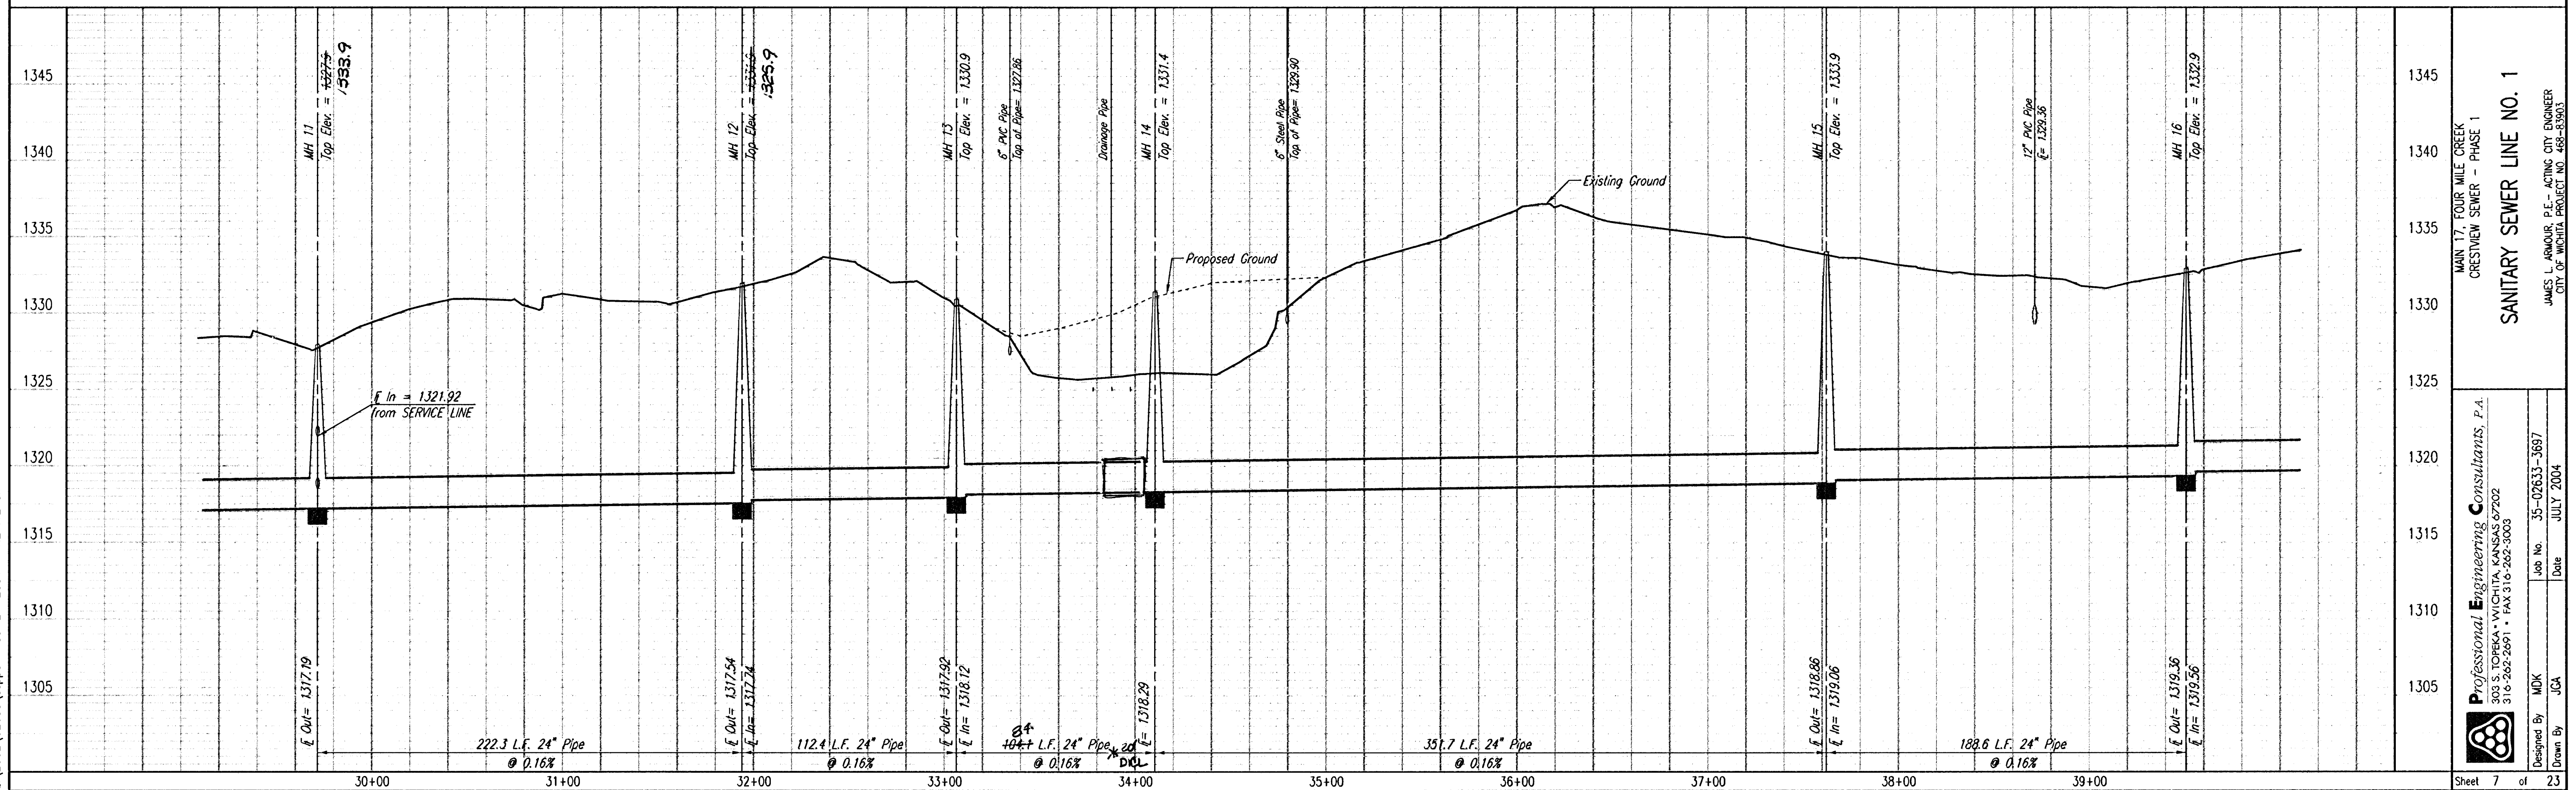

* NOTE

CONTRACTOR SHALL CONSTRUCT THE 8" SERVICE LINE TO CONNECT NEW SERVICE FACILITY SEWER TO PROPOSED SEWER MAIN. PRIOR TO BEGINNING CONSTRUCTION, THE CONTRACTOR SHALL CONTACT MR. RICHARD SPURLIN, CREWVIEW COUNTRY CLUB GENERAL MANAGER AT (316)733-1344 TO VERIFY THE HORIZONTAL AND VERTICAL LOCATION OF SERVICE TO BE CONNECTED AND REPORT FINDINGS TO THE ENGINEER SO THAT ANY MODIFICATIONS CAN BE MADE TO THE PLANS. CONTRACTOR SHALL COORDINATE THIS WORK WITH THE CREWVIEW COUNTRY CLUB MAINTENANCE PERSONNEL.

Note #2: Doghouse MH @ Sta. 33+98 needed for 24" RCP intake pipe- irrigation system. 20' DCL 24" SS thru MH. Intake pipe top section removed-- .8' into bottom of SS.

	SANITARY SEWER LINE NO. 1	
Sheet 7 of 23		