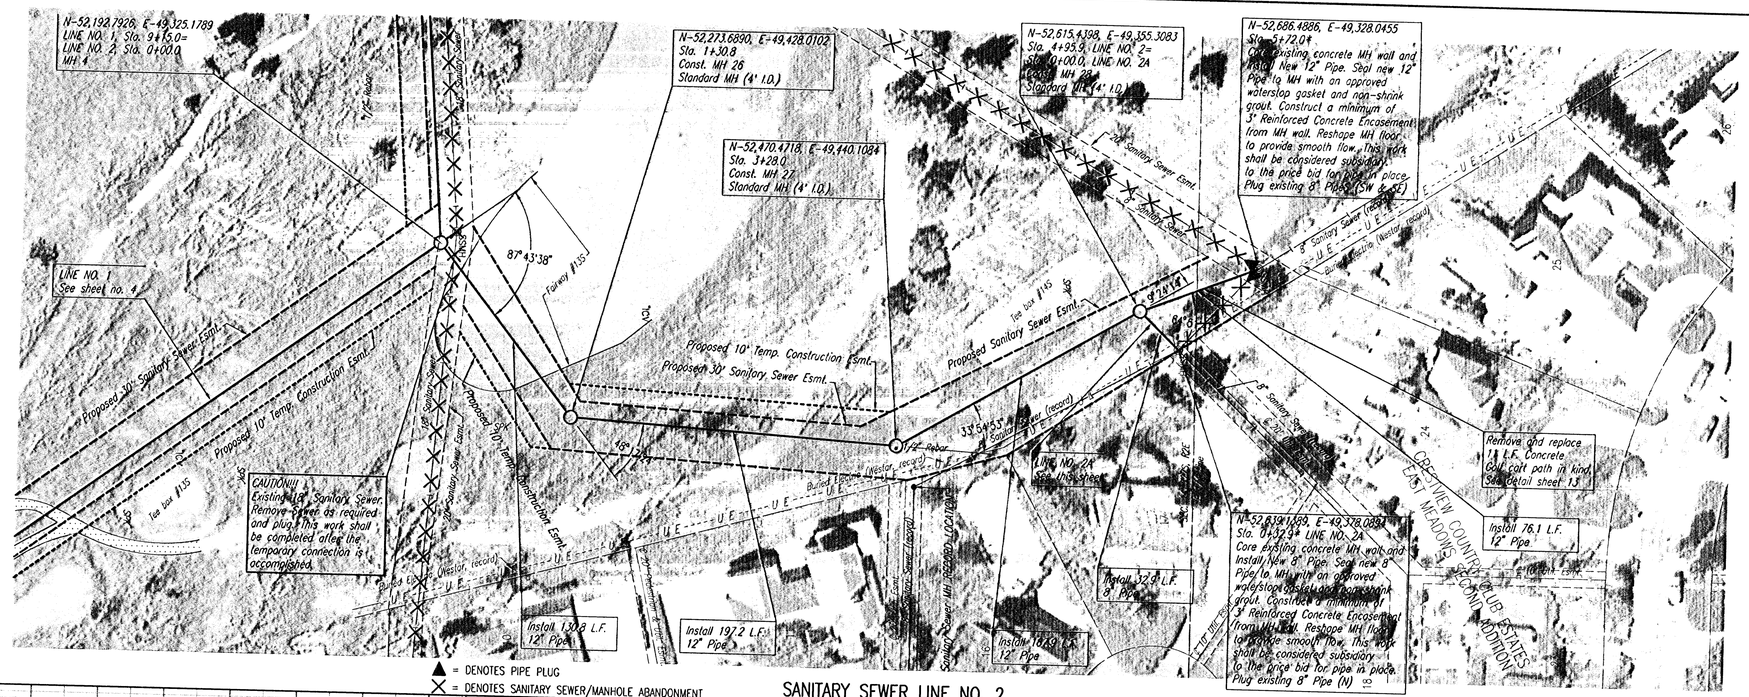

▲ = DENOTES PIPE PLUG
X = DENOTES SANITARY SEWER/MANHOLE ABANDONMENT

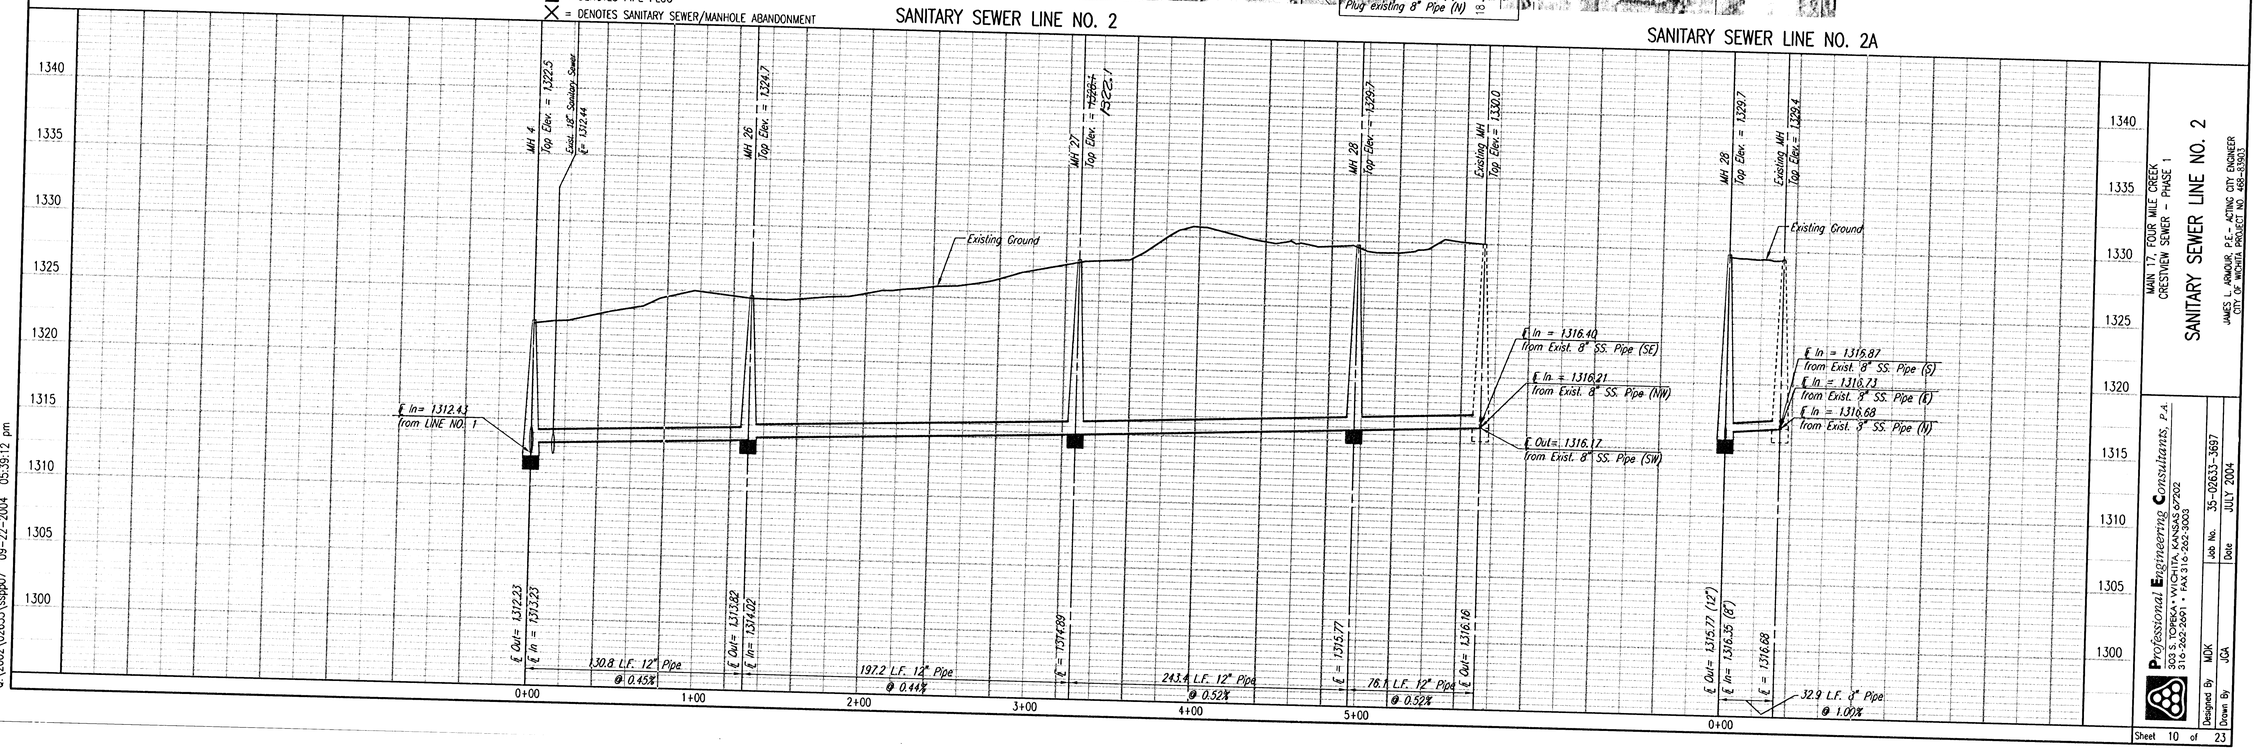

PLAN CHECKED CHECKED BY DATE

PROFILE CHECKED CHECKED BY DATE

DSNR: OPER: JGA SCALE: 1=40.00
Q:\2002\02633\ssppl07 09-22-2004 05:39:12 pm

MAIN 17, FOUR MILE CREEK
CRESTVIEW SEWER - PHASE 1

SANITARY SEWER LINE NO. 2

JAMES L. ARMOUR, P.E. - ACTING CITY ENGINEER
CITY OF WICHITA, PROJECT NO. 468-83903

Professional Engineering Consultants, P.A.
303 S. TOPEKA • WICHITA, KANSAS 67202
316-262-2691 • FAX 316-262-3002

Designed By WDK
Drawn By JGA
Job No. 35-02633-3697
Date JULY 2004

Sheet 10 of 23

JAMES L. ARMOUR
13944
9/22/04
KANSAS
PROFESSIONAL ENGINEER