

CONSTRUCTION NOTES


New signal heads and signing shall be installed as close to traffic-direction conversion as practicable. All new signal heads and signing on traffic signal equipment shall be covered until traffic conversion occurs. The removal of any signing on traffic signal equipment shall occur at the time of the traffic conversion.

Contractor shall install Radar Detector #1 (mast arm) on Traffic Signal Pole #2.

Contractor shall install Traffic Signal Pole #6, Traffic Signal Head 8A (mast arm), Traffic Signal Head 8A (pole) and Street Name Sign "P" (mast arm).

Contractor shall remove the following signs:

- "One Way" (R6-1R) sign from Traffic Signal Pole #1 (pole)
- "No Left Turn" (R3-2) sign from Traffic Signal Pole #1 (mast arm)
- "One Way" (R6-1L) sign from Traffic Signal Pole #2 (pole)
- "One Way" (R6-1L) sign from Traffic Signal Pole #4 (pole)
- "One Way" (R6-1R) sign from Traffic Signal Pole #5 (pole)

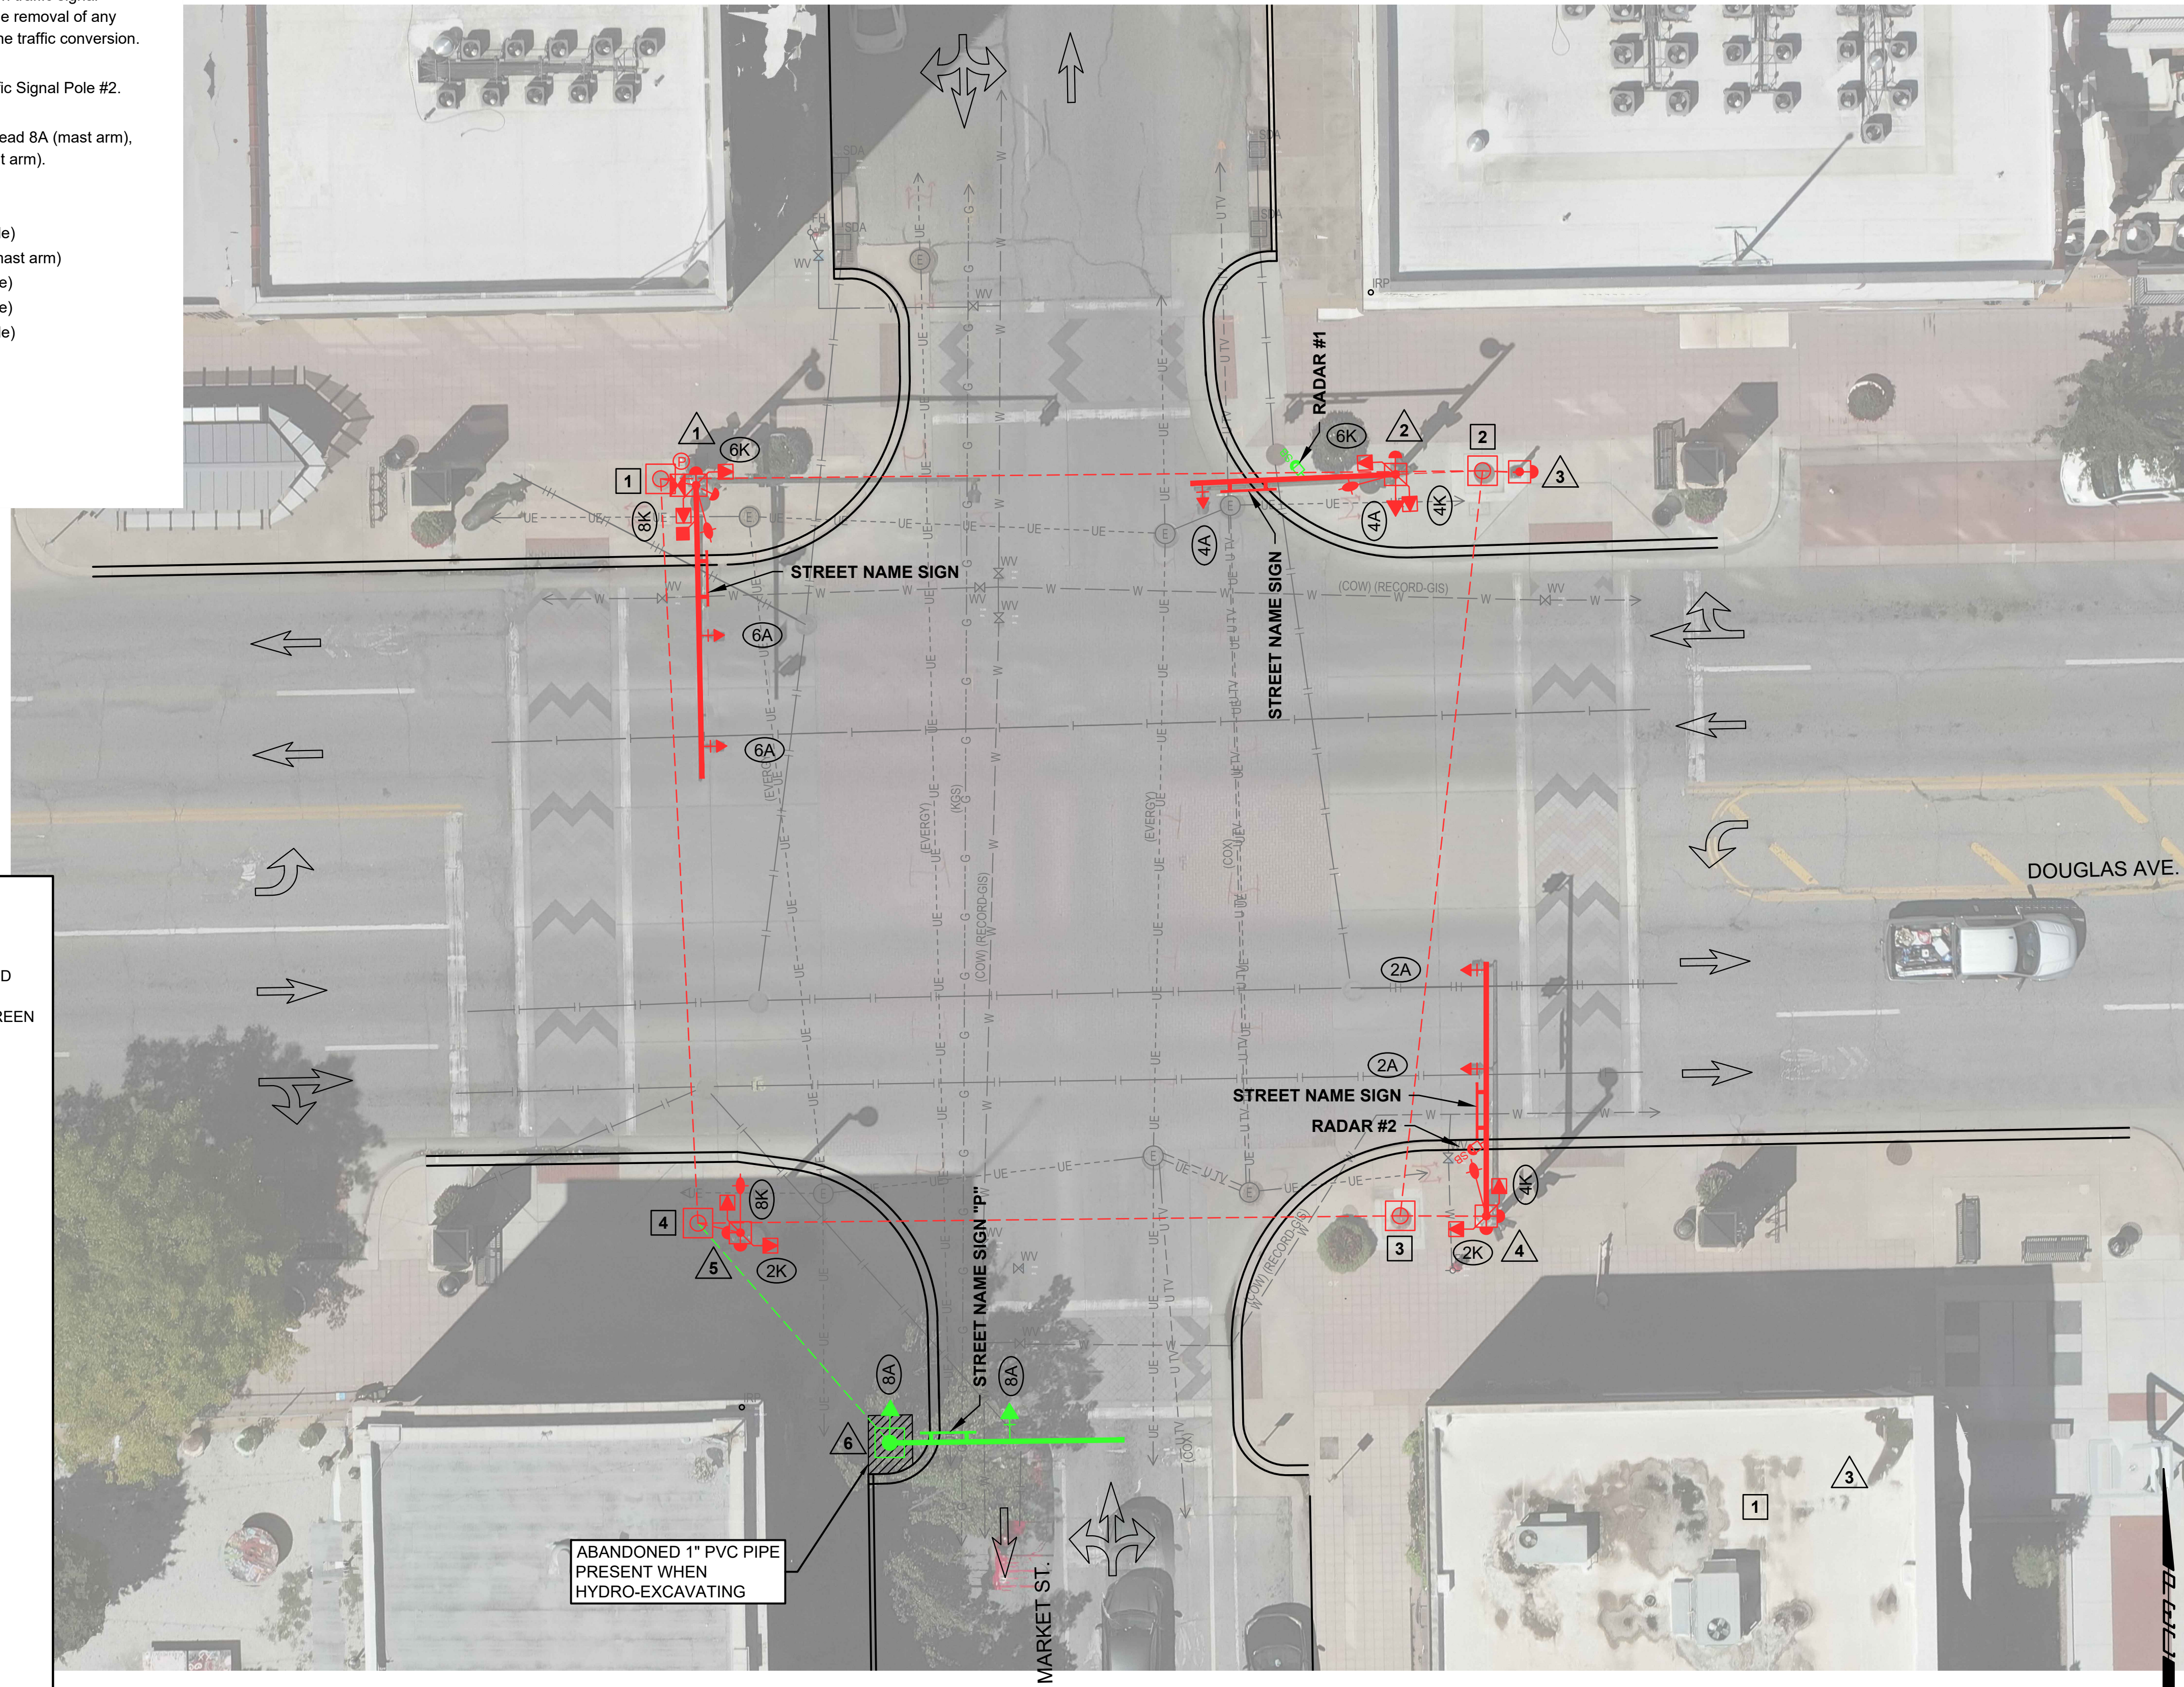


ABANDONED 1" PVC PIPE
PRESENT WHEN
HYDRO-EXCAVATING



LEGEND

- PAVEMENT REMOVED & REPLACED
- TRAFFIC EQUIPMENT TO REMAIN IN RED
- PROPOSED TRAFFIC EQUIPMENT IN GREEN
- POWER/METER LOCATION
- TRAFFIC CONTROLLER CABINET
- SERVICE BOX
- CONDUIT
- TRAFFIC SIGNAL POLE
- SIGNAL HEAD W/BACKPLATE
- SIGNAL HEAD
- PEDESTRIAN SIGNAL HEAD
- PEDESTRIAN PUSHBUTTON
- TRAFFIC SIGN
- LUMINAIRE WITH ARM
- COMM. ANTENNA MOUNT
- VIDEO DETECTION CAMERA
- RADAR DETECTION UNIT
- LANE USE
- SERVICE BOX NUMBER
- SIGNAL POLE NUMBER
- SIGNAL HEAD PHASE/TYPE
- DETECTOR NUMBER

SAVED 6/11/2024 8:43:24 AM BY SCOTT.CANFIELD
 PLOTTED 7/12/2024 1:48:19 PM BY SCOTT.CANFIELD
 U:\WICHITA-CIVIL\2023\230431-000\PECDRAWINGS\230431-000-CP113 MARKET DOUGLAS.DWG

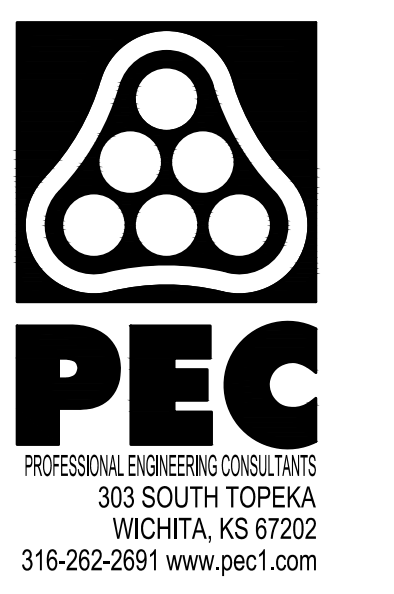

**DOWNTOWN
TWO-WAY STREET
CONVERSION
CENTRAL BUSINESS DISTRICT
WICHITA, KANSAS**

Issue:			
1			

JOB NO.	230431-000
DATE	JULY 2024
PM	TPA
DESIGNED BY	LGP/SAC
DRAWN BY	CP/SAC
CHECKED BY	SAC/TPA

MARKET ST. &
DOUGLAS AVE.
TRAFFIC SIGNAL PLAN SHEET