83809

LATERAL 3, MAIN 7
OF THE
NORTHWEST INTERCEPTOR SEWER
IN
THE CITY OF WICHITA

OCA NO. 744217
CITY OF WICHITA PROJECT NO. 468-83809
JAMES L. ARMOUR, P.E. - CITY ENGINEER

INDEX OF SHEETS

SHEET NO. 1	TITLE SHEET
SHEET NO. 2	KEY MAP AND GENERAL NOTES
SHEET NO. 3-4	PLATS
SHEET NO. 5-9	PLAN/PROFILE
SHEET NO. 10	TYPE "P" MANHOLE DETAILS
SHEET NO. 11	FRAME & COVER DETAILS
SHEET NO. 12	RISER DETAILS
SHEET NO. 13-16	SOIL EROSION BMP DETAILS

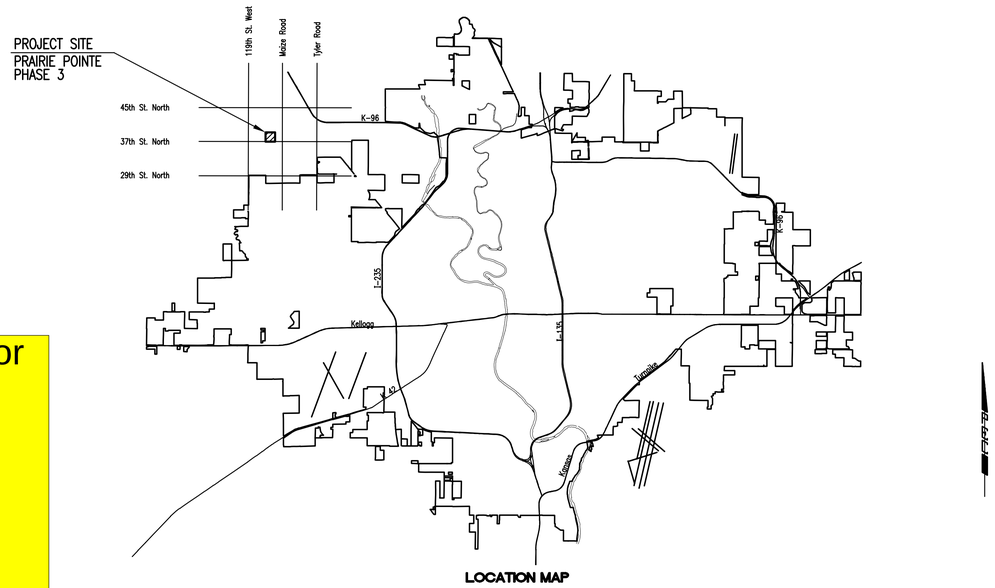

LOCATION MAP

CONSTRUCTION SCHEDULE/SEQUENCE

THE CONTRACTOR FOR EACH OF THE FOLLOWING PRAIRIE POINTE PHASE 3 PROJECTS SHALL COORDINATE THEIR EFFORTS WITH OTHER CONTRACTORS PERFORMING WORK IN THIS AREA SUCH THAT ANY NECESSARY SIMULTANEOUS CONSTRUCTION CAN PROCEED CONCURRENTLY WITHOUT CAUSING UNDUE DELAYS SO THAT CONSTRUCTION CAN BE COMPLETED WITHIN THE TIME FRAMES AS NOTED.

SANITARY SEWER (468-83809)

THE CONTRACTOR SHALL CONSTRUCT LINE NO. 1 TO MH 2 AND LINE NO. 3 IN ITS ENTIRETY PRIOR TO CONSTRUCTING THE OTHER SANITARY SEWERS ON THE PROJECT IN ORDER TO PREVENT DELAYS WITH WATERLINE CONSTRUCTION.
THE CONTRACTOR SHALL COMPLETE, INCLUDING TESTING AND ACCEPTANCE, ALL WORK ON THE PROJECT BY MAY 25, 2007.

WATER DISTRIBUTION SYSTEM (448-89974)

THE CONTRACTOR SHALL COMPLETE PRAIRIE POINTE - PHASE 3 WATERLINE CONSTRUCTION BY JUNE 8, 2007.

STREETS/DRAINAGE (472-84043)

THE CONTRACTOR SHALL COMPLETE PRAIRIE POINTE - PHASE 3 STREETS/DRAINAGE CONSTRUCTION BY JULY 31, 2007.

McCullough Excavation, Inc. - Contractor
Sholander, City - Inspector
Released 6/2/07
As-Built
Risers & Stubs
.pdf by JLD 8/13/07

MARCH 2007

PLANS PREPARED BY
PROFESSIONAL ENGINEERING CONSULTANTS, P.A.
ENGINEERS
WICHITA, KANSAS

Saved 03-05-2007 2:24:38 PM by TLS
Plot Scale 1:1 03-06-2007 8:57:22 AM by REJ
J:\SENTOUT\2006\06563\2007-03-05 to City\Sanitary Sewer\DWG\01-Title Sheet