


P:\DC21001\CAD\Civil\PROJECT\NUMBER\Production Drawings\564720003\_C5.0\_GRA & UTIL.dwg C5.1 Storm Profiles Aug 09, 2021 - 9:33am jconar

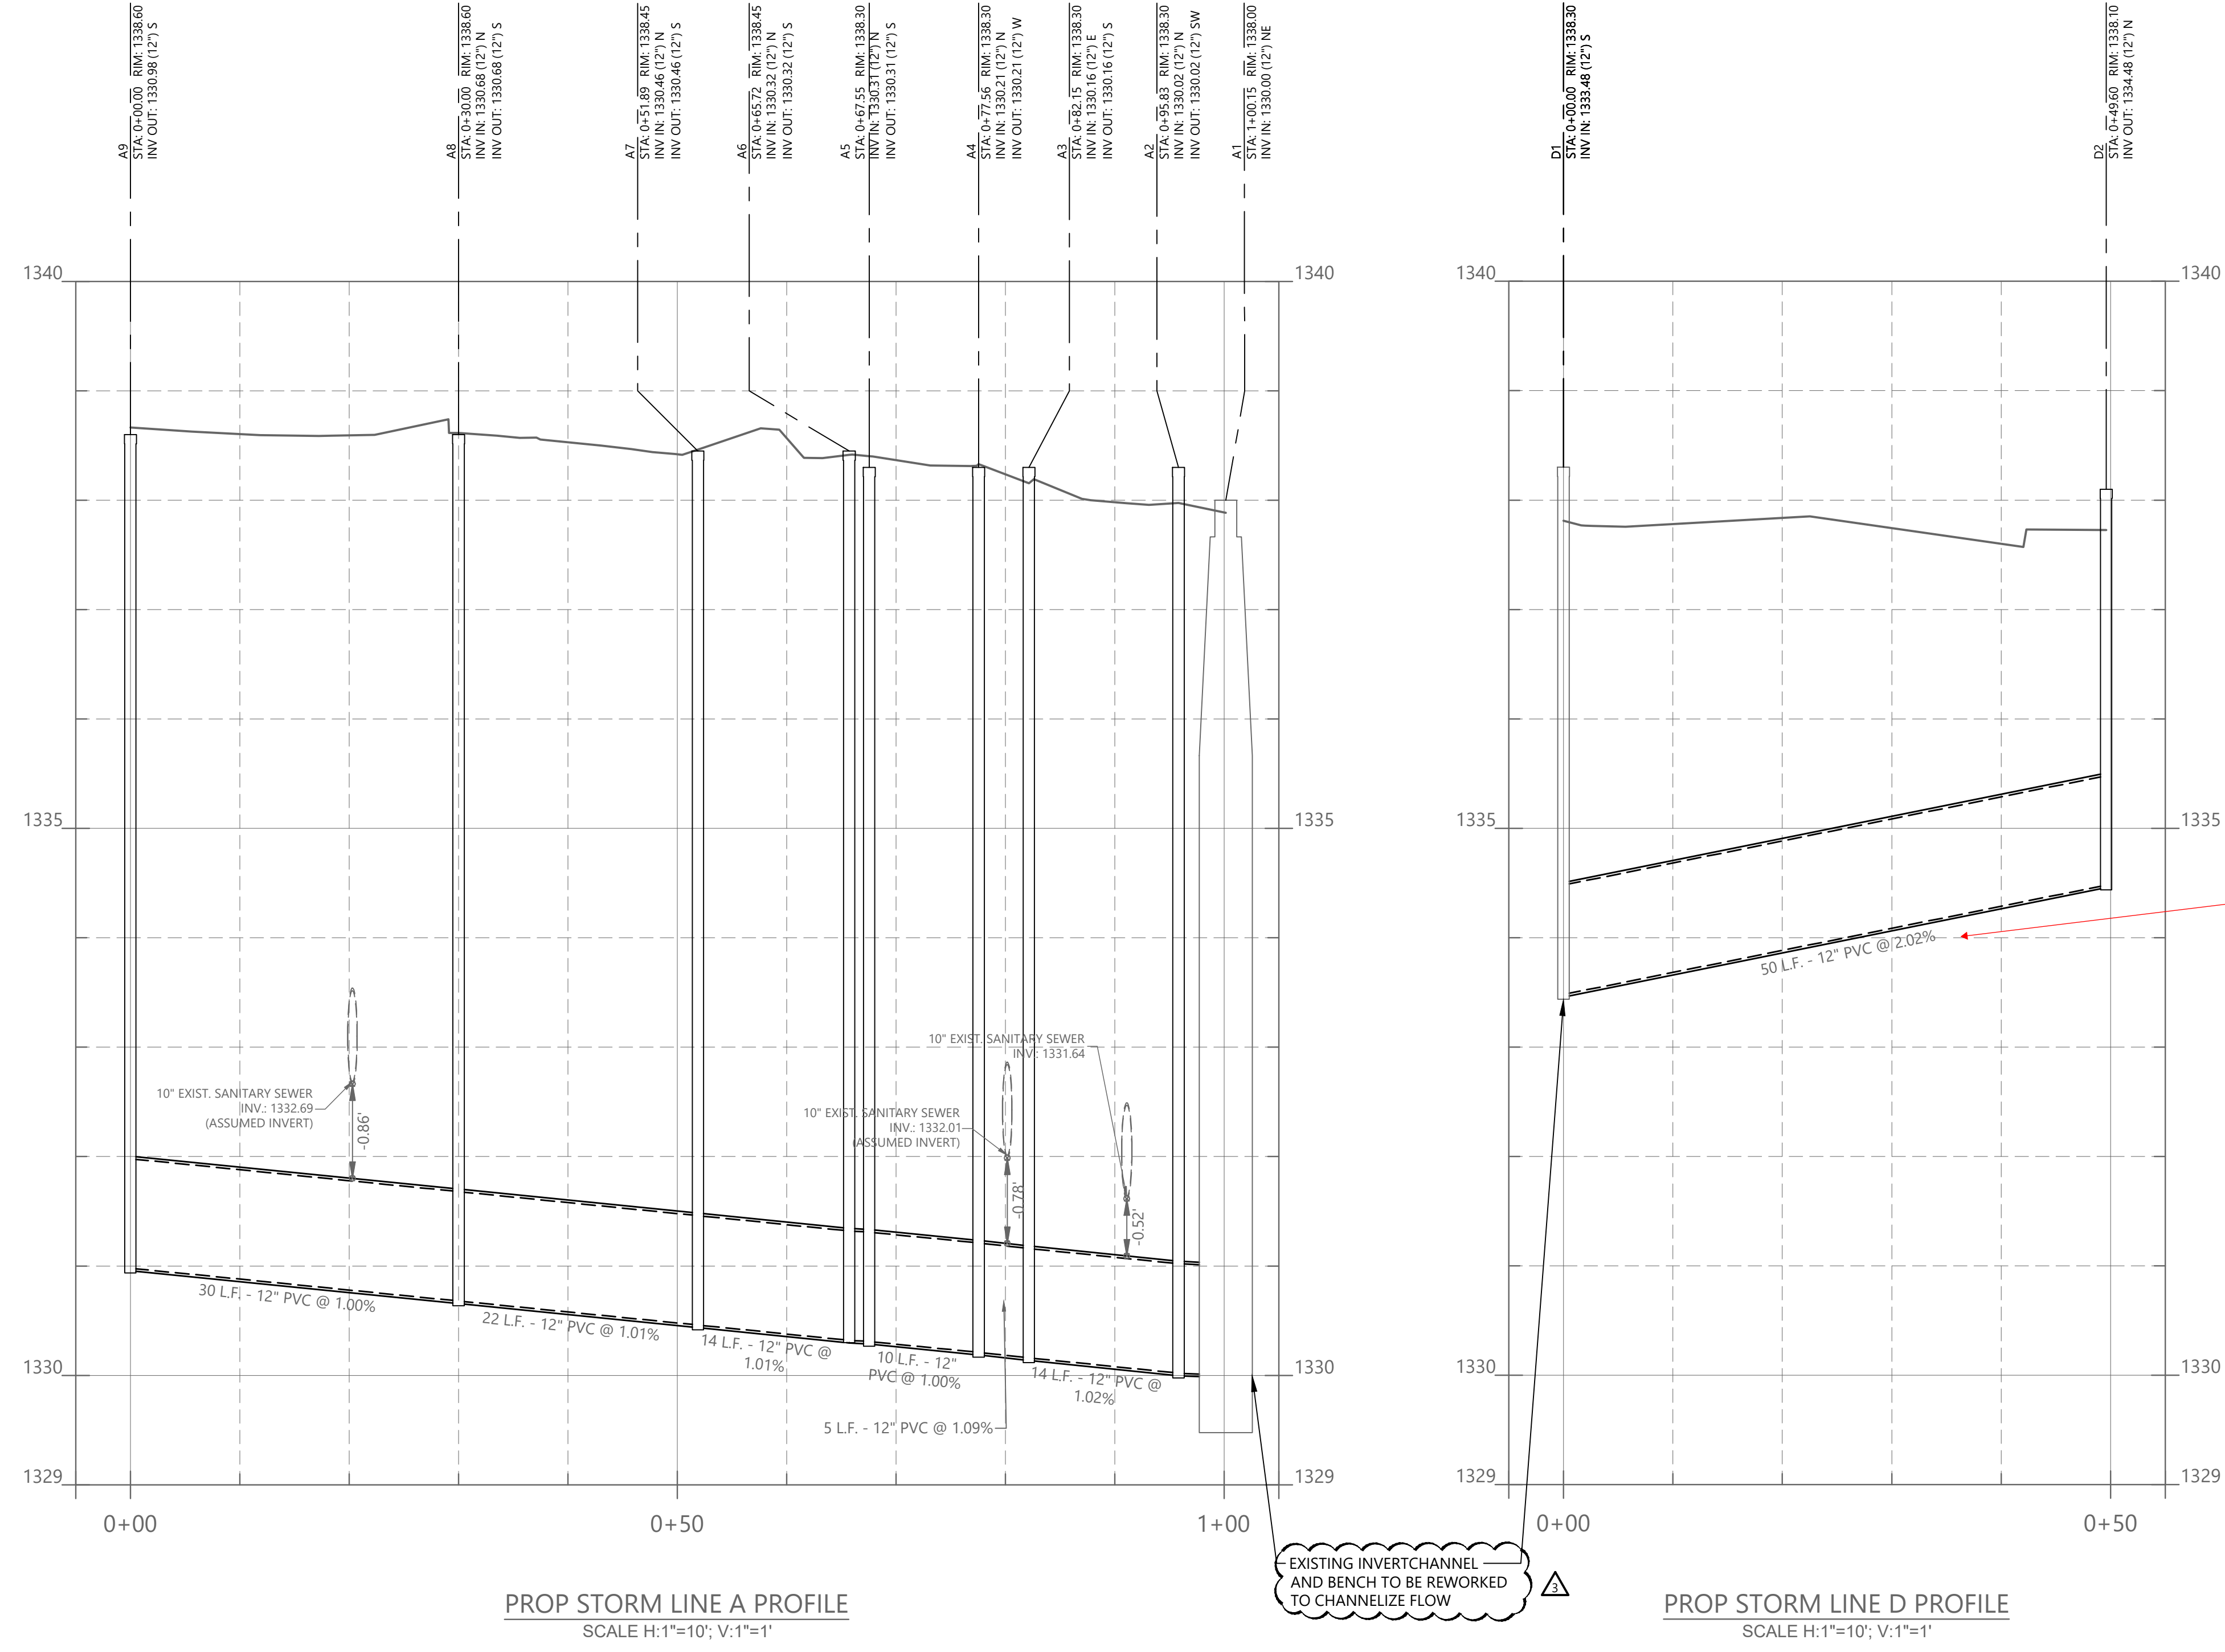


Date: 2021-11-15  
 Inspector: Arne Thompson  
 Design/Inspecting Firm: Gould Turner Group, P.C./Kaw Valley Engineering, Inc.  
 Contractor: J.E. Dunn Construction  
 Subcontractor: Pearson Construction LLC  
 Built in general conformance to construction plans, except where noted on plans.

NOTE: Datum, SWS  
 Manhole at sta. A-1 +1+00.15

Please see Pipe Revisions: 12\"/>

658 GRASSMERE PARK DR., STE 100  
 NASHVILLE, TN 32804  
 T 615.385.4144  
 www.smeinc.com  
 Kansas Firm Registration No. 4008990  
 Jeffrey D. Connar, P.E. 27117  
 Edward A. Browder P.L.A. LA 0927

WESLEY MEDICAL CENTER ED AND IMU SUPPORT  
 WICHITA, KANSAS

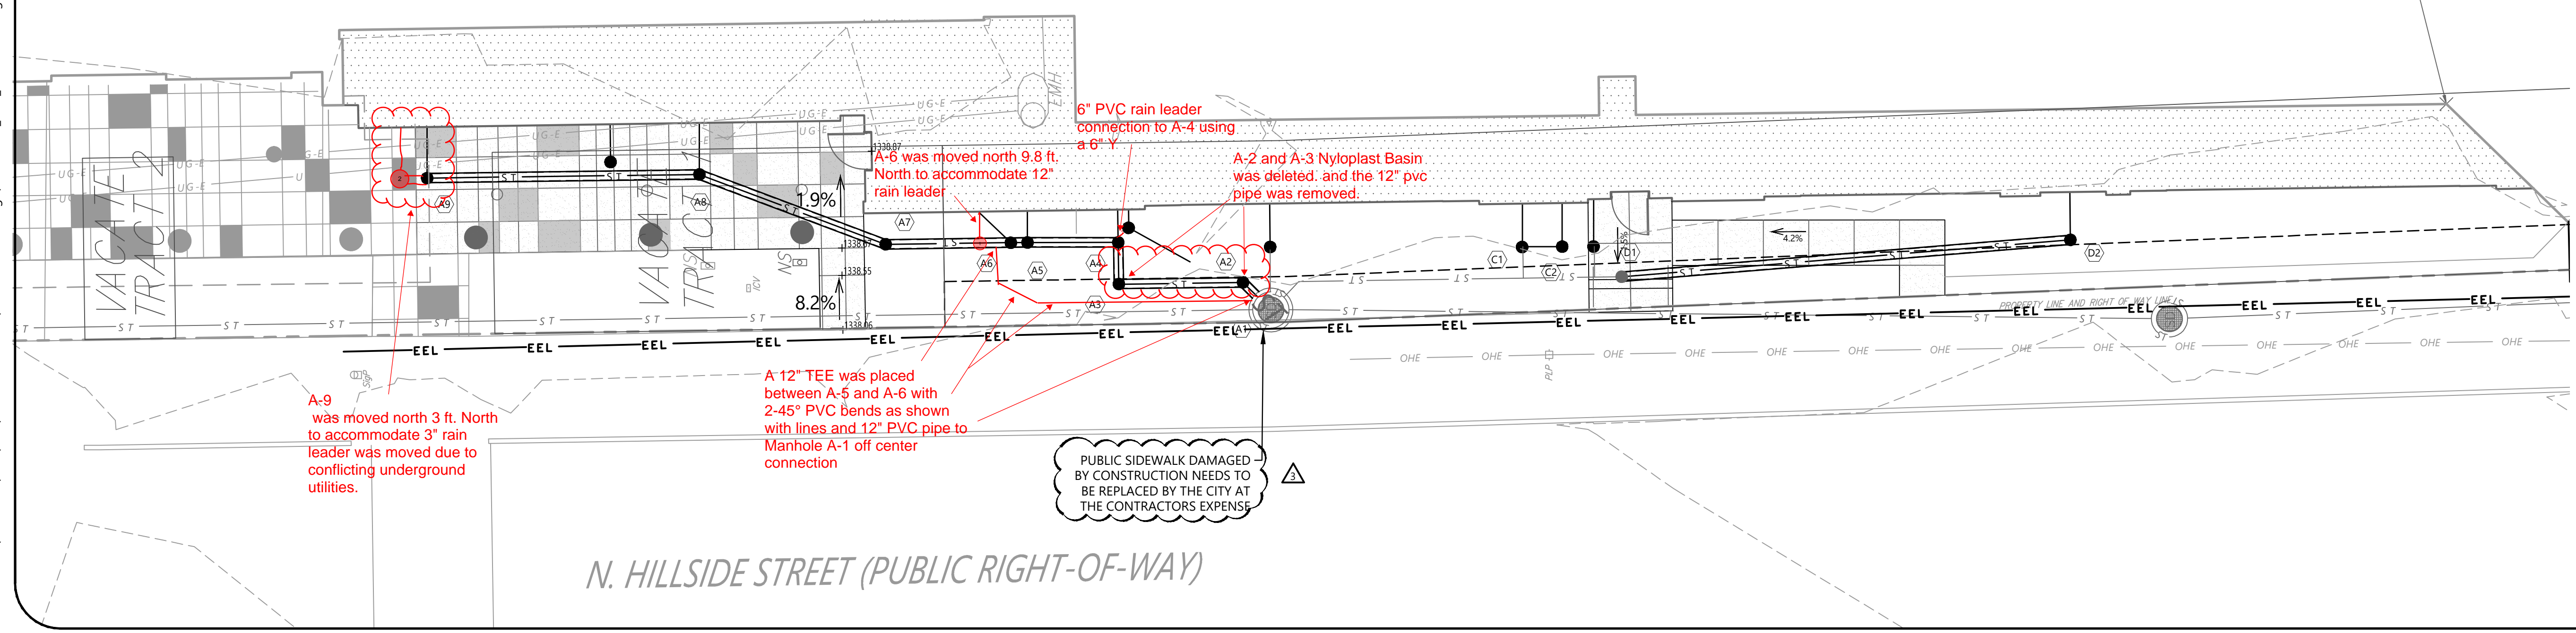

Know what's below.  
 Call before you dig.



NO.	DATE	DESCRIPTION	BY	CHK	APP
1	07/21/2021	ADDENDUM 1 (PRO) EDD/S	CS	IC	IC
2	06/07/2021	ADDENDUM 02	CS	IC	IC
3	03/18/2021	ADDENDUM 01	CS	IC	IC
4	07/13/2021	CD DRAWINGS	CS	IC	IC

PROJECT NUMBER: 564720003  
 DRAWING NUMBER: C5.1  
 DRAWING NAME: STORM PROFILES

HCA  
 HCA DESIGN MANAGER  
 ZACH WIDSMAN  
 HCA CONSTRUCTION MANAGER  
 MARC BRIBEBOS

CIVIL CONSULTANT  
 SNAME  
 658 GRASSMERE PARK DR., SUITE 100  
 NASHVILLE, TN 37211


STRUCTURAL CONSULTANT  
 STANLEY D. LINDSEY AND ASSOCIATES  
 750 OLD HICKORY BLVD, BLDG. 1, SUITE 175  
 NASHVILLE, TN 37027  
 MANAGER: MARK HILLNER, P.E.

M.P.E. & T. CONSULTANT  
 I.C. THOMASSON & ASSOCIATES  
 2650 RAMFORD DRIVE, SUITE 500  
 NASHVILLE, TN 37204  
 MANAGER: CHRIS MCGUIRE, P.E.

GENERAL CONTRACTORS  
 J.E. DUNN CONSTRUCTION  
 28 HERMITAGE AVE.  
 NASHVILLE, TN 37210  
 MANAGER: BRANDON MOORE

VENDOR INFORMATION


WESLEY MEDICAL CENTER  
 ED AND IMU SUPPORT  
 550 N. HILLSIDE ST. WICHITA, KANSAS  
 HCA OWNER PROJECT #  
 GTCF PROJ. #4008140099  
 AGENCY #

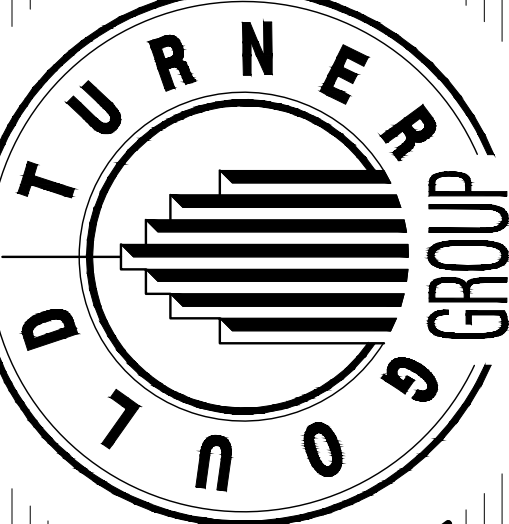

GOULD TURNER GROUP, P.C.  
 ARCHITECTURE  
 615 3RD AVE. SOUTH, SUITE 700  
 NASHVILLE, TENNESSEE 37210

CONSTRUCTION DOCUMENTS

REVISIONS:  
 01/05/21  
 ADDENDUM 03  
 04/29/21  
 ADDENDUM 03  
 7/21/21

DATE: 06/07/2021