




No.	Date	By	Approved	Revision

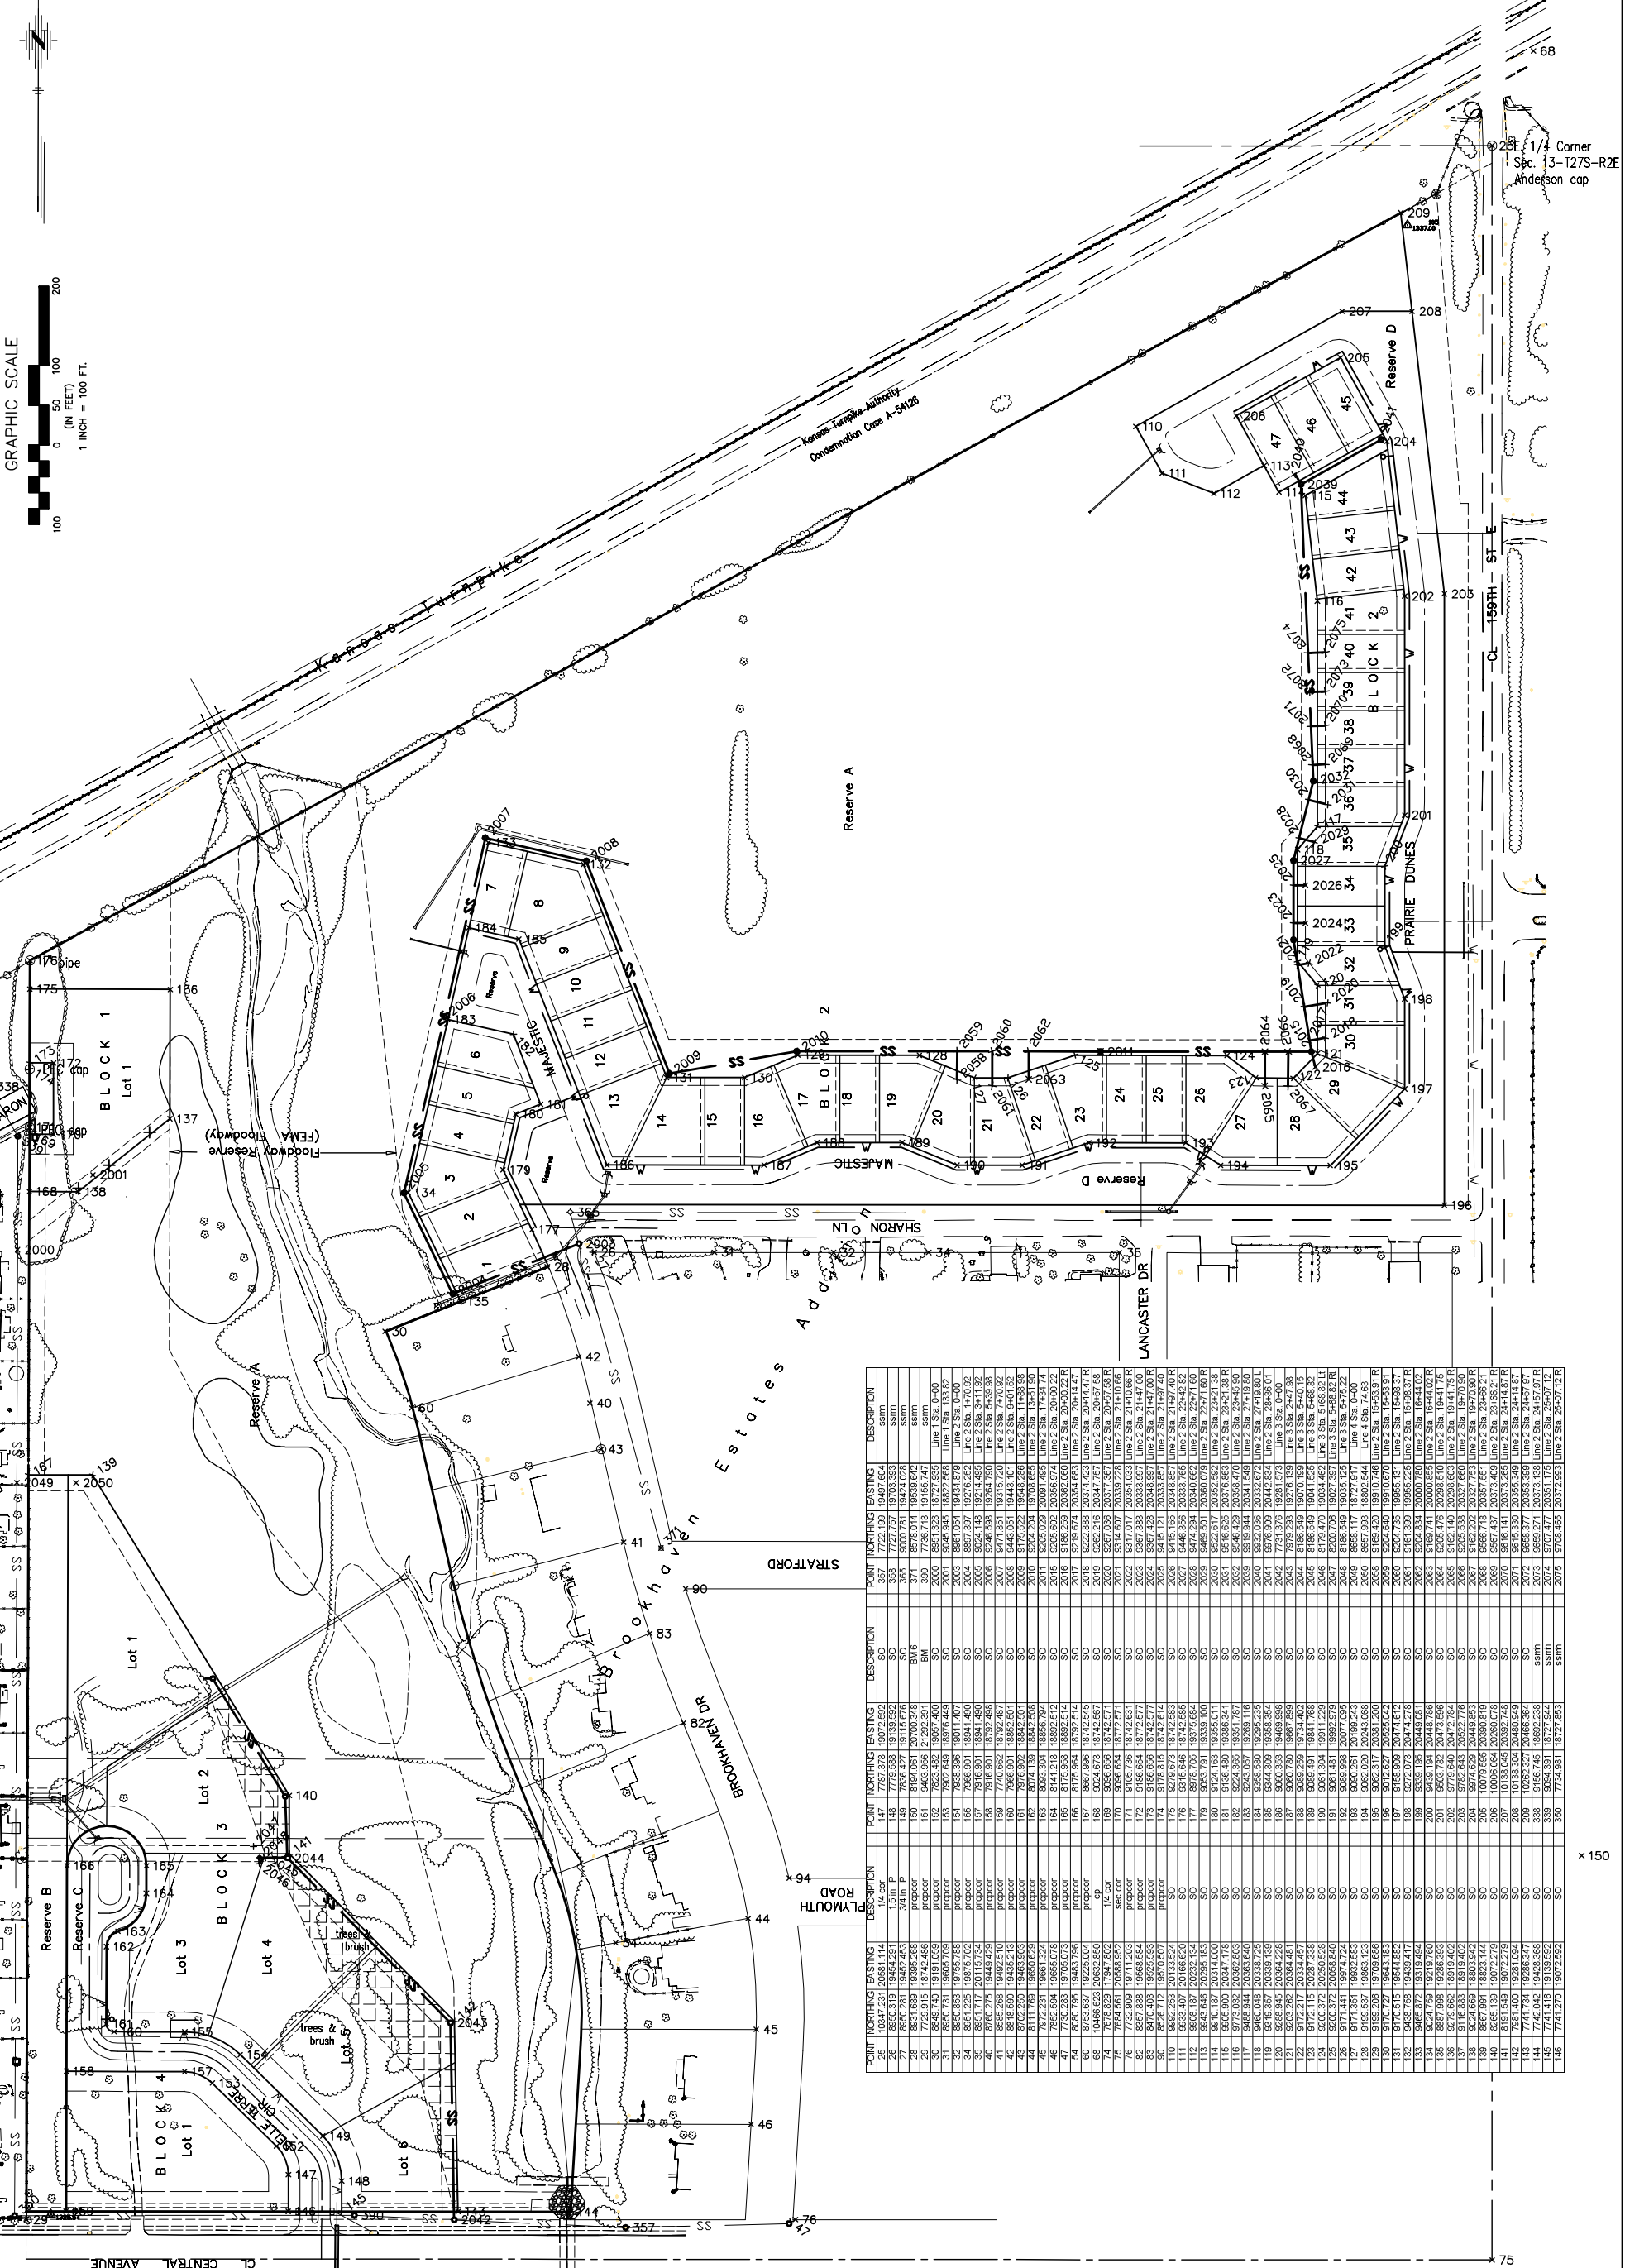

POINT	NORTHING	EASTING	DESCRIPTION	POINT	NORTHING	EASTING	DESCRIPTION
25	10347.231	20031.114	14.0 cor	367	1752.189	19497.604	ssm
26	8890.319	19454.291	1.9 in. P	368	779.588	19139.992	SO
27	8890.281	19462.453	34 in. P	369	900.781	19242.028	ssm
28	7729.915	18742.246	BM	370	113.713	19155.742	ssm
29	7729.915	18742.246	BM	371	778.713	19155.742	ssm
30	8649.740	19191.059	prop/cor	2000	8691.323	18727.935	Line 1 Ssb. 1000
31	8890.731	19005.029	prop/cor	2001	906.945	18627.668	Line 1 Ssb. 133.82
