


Ruggles & Bohm, P.A.
 Engineering, Surveying, Land Planning
 521 North Main
 Wichita, Kansas 67202
 www.rugglesandbohm.com
 Phone: 316-264-8000
 Fax: 316-264-8001
 Email: info@rugglesandbohm.com

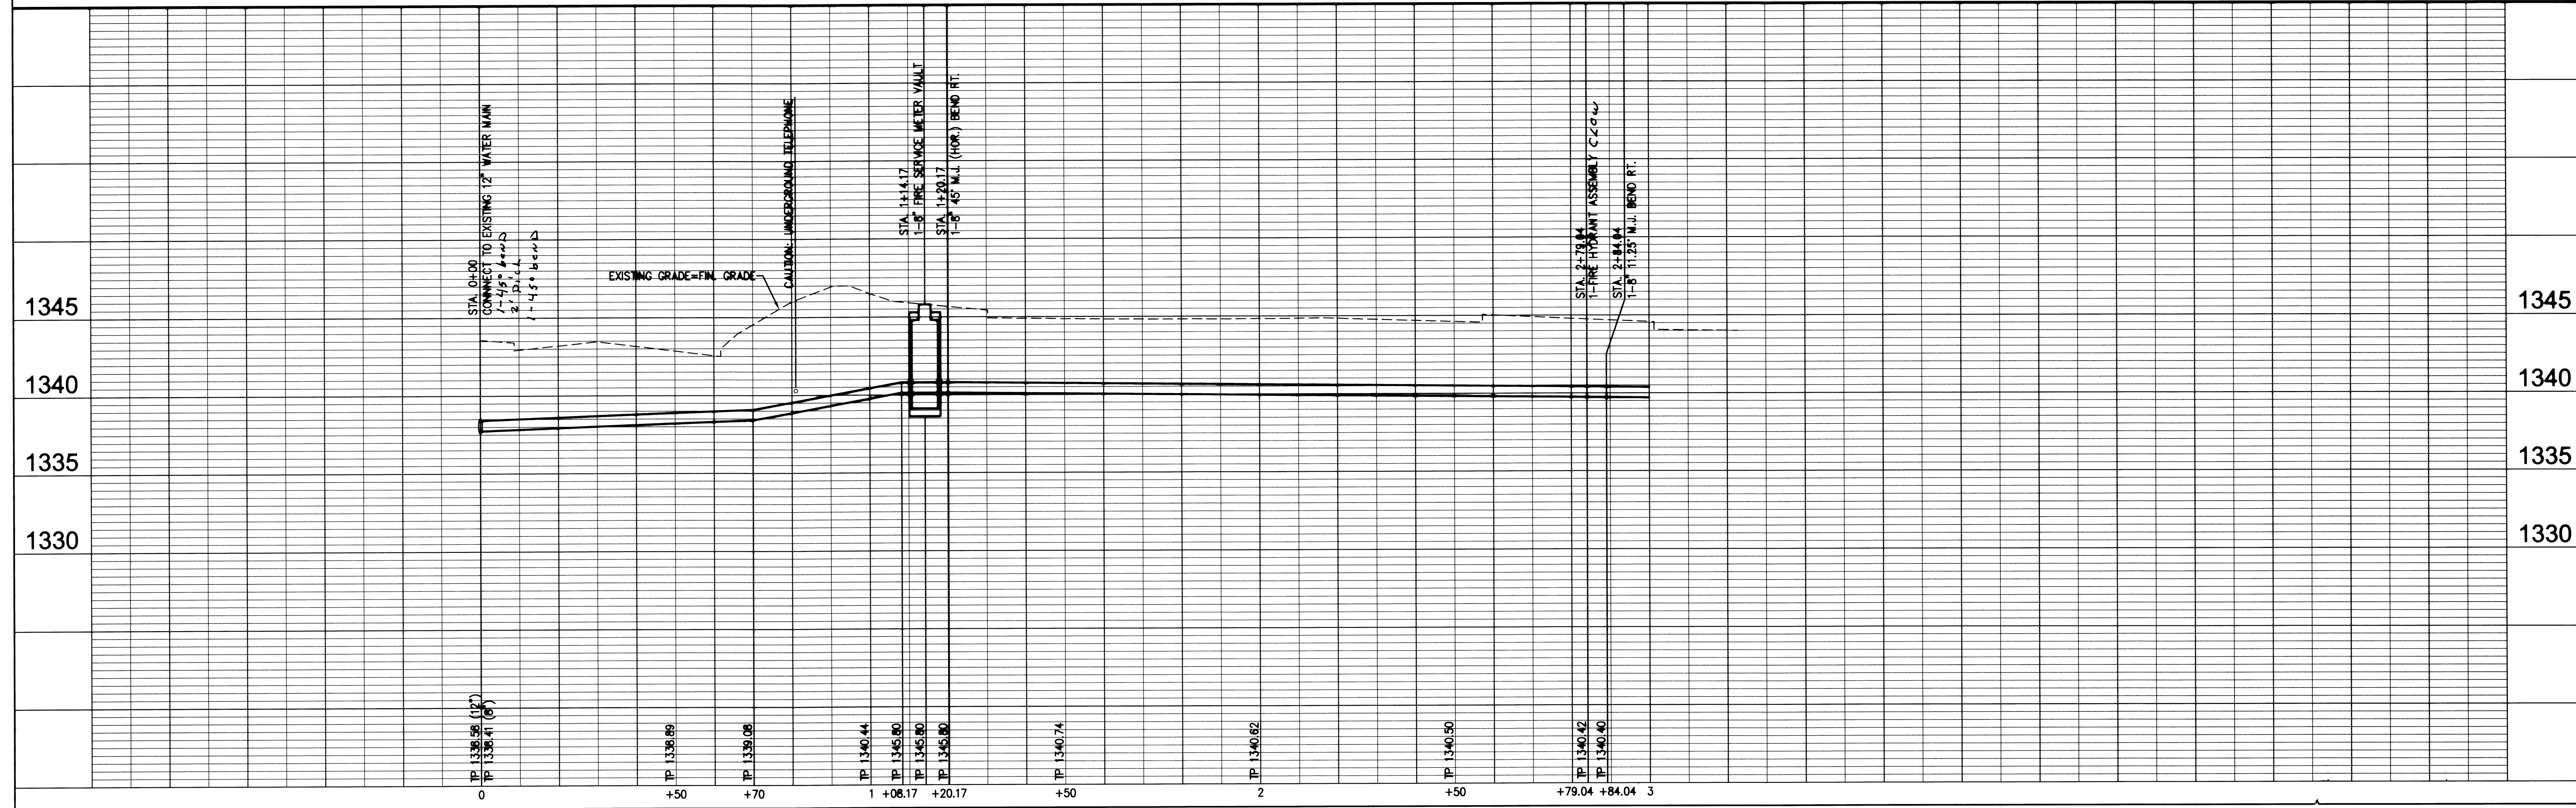

ANDOVER HIGH SCHOOL
WATER PLAN & PROFILE
ANDOVER, KANSAS

REVISIONS:
 REVIEW: []
 DATE: Feb. 28, 2007
 DRAWN: EJB
 DESIGN: TOR
 PROJECT NUMBER: 1290 PPW
 DRAWING FILE: []
 ENGINEERING BASE (SYS): []

NO. JOB: 2004E
 SHEET: 2 OF 7